


#5939

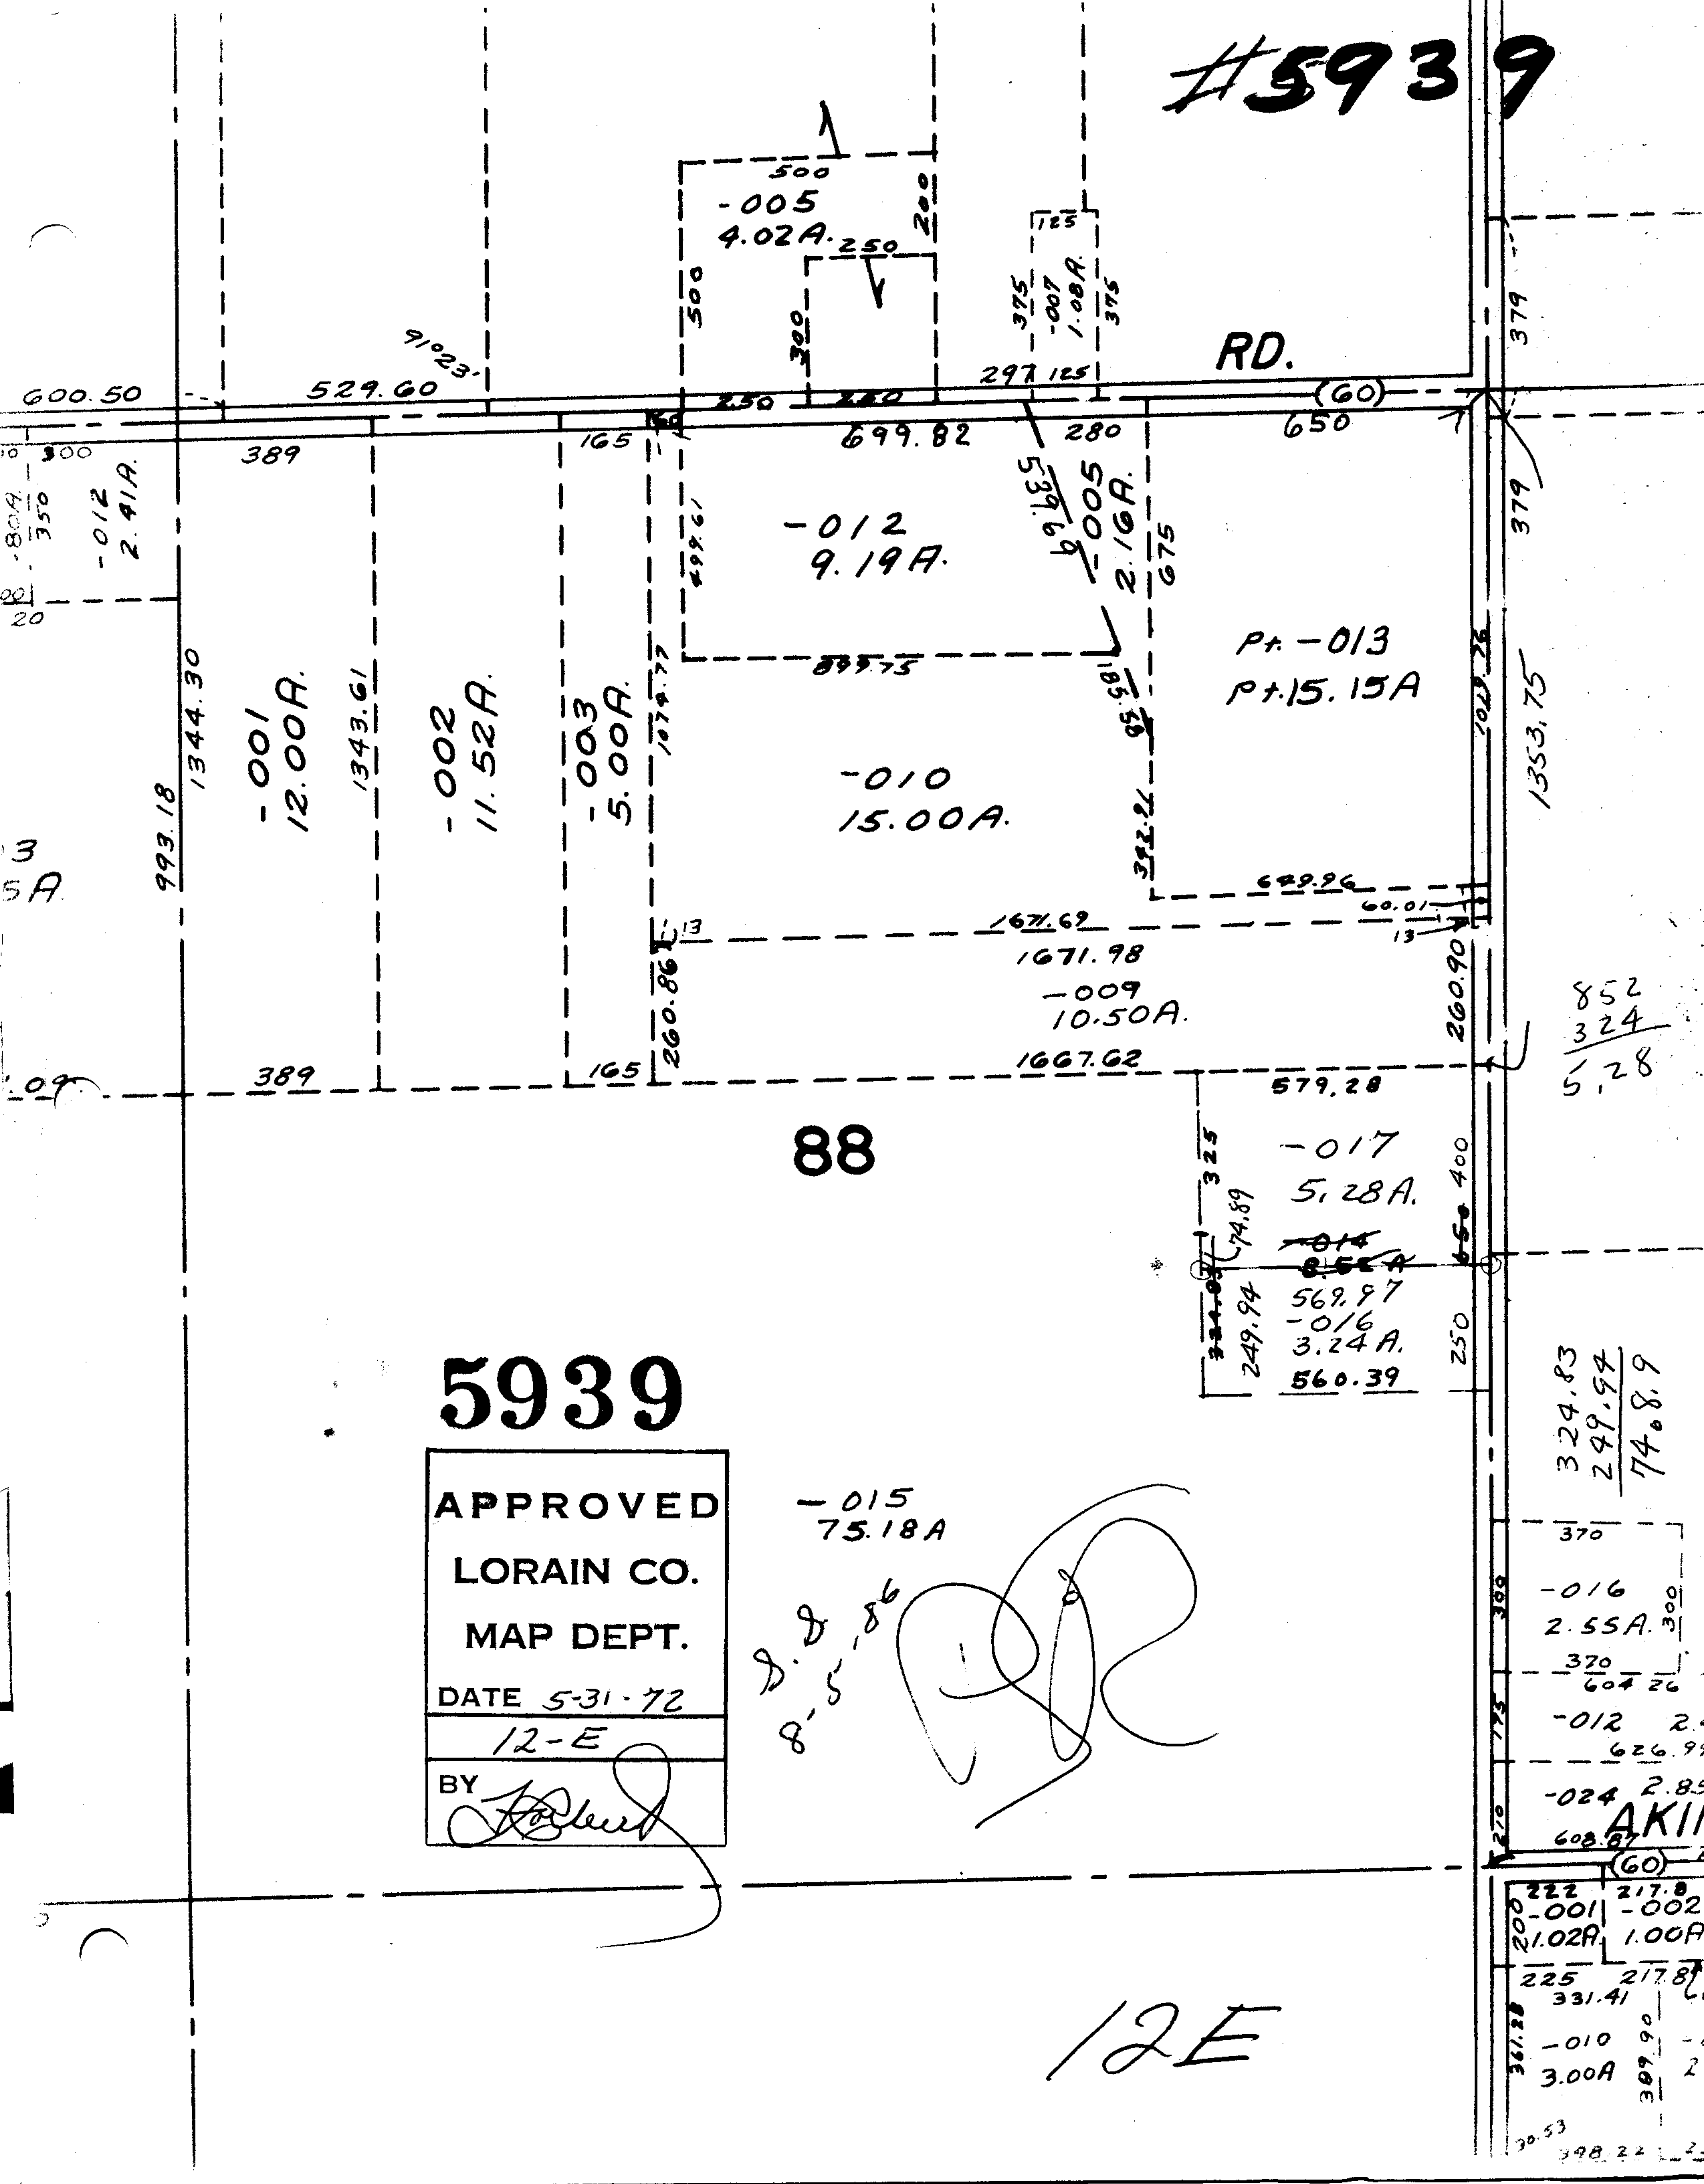

5939

APPROVED
 LORAIN CO.
 MAP DEPT.
 DATE 5-31-72
 12-E
 BY *[Signature]*

88

-015
75.18A

D. S. 8-5-86

[Large signature]

12E

RD.

Pt. -013
Pt. 15.15A

852
324
5.28

324.83
249.94
74.89

370
-016
2.55A.300
370
604.26

-012 2.85
626.91
-024 2.85
602.87
AKII
(60)

200 222 217.8
 -001 -002
 21.02A 1.00A
 225 217.8
 331.41
 361.28
 -010
 3.00A 309.90
 30.53
 398.22