


SEE 5-00-098-C

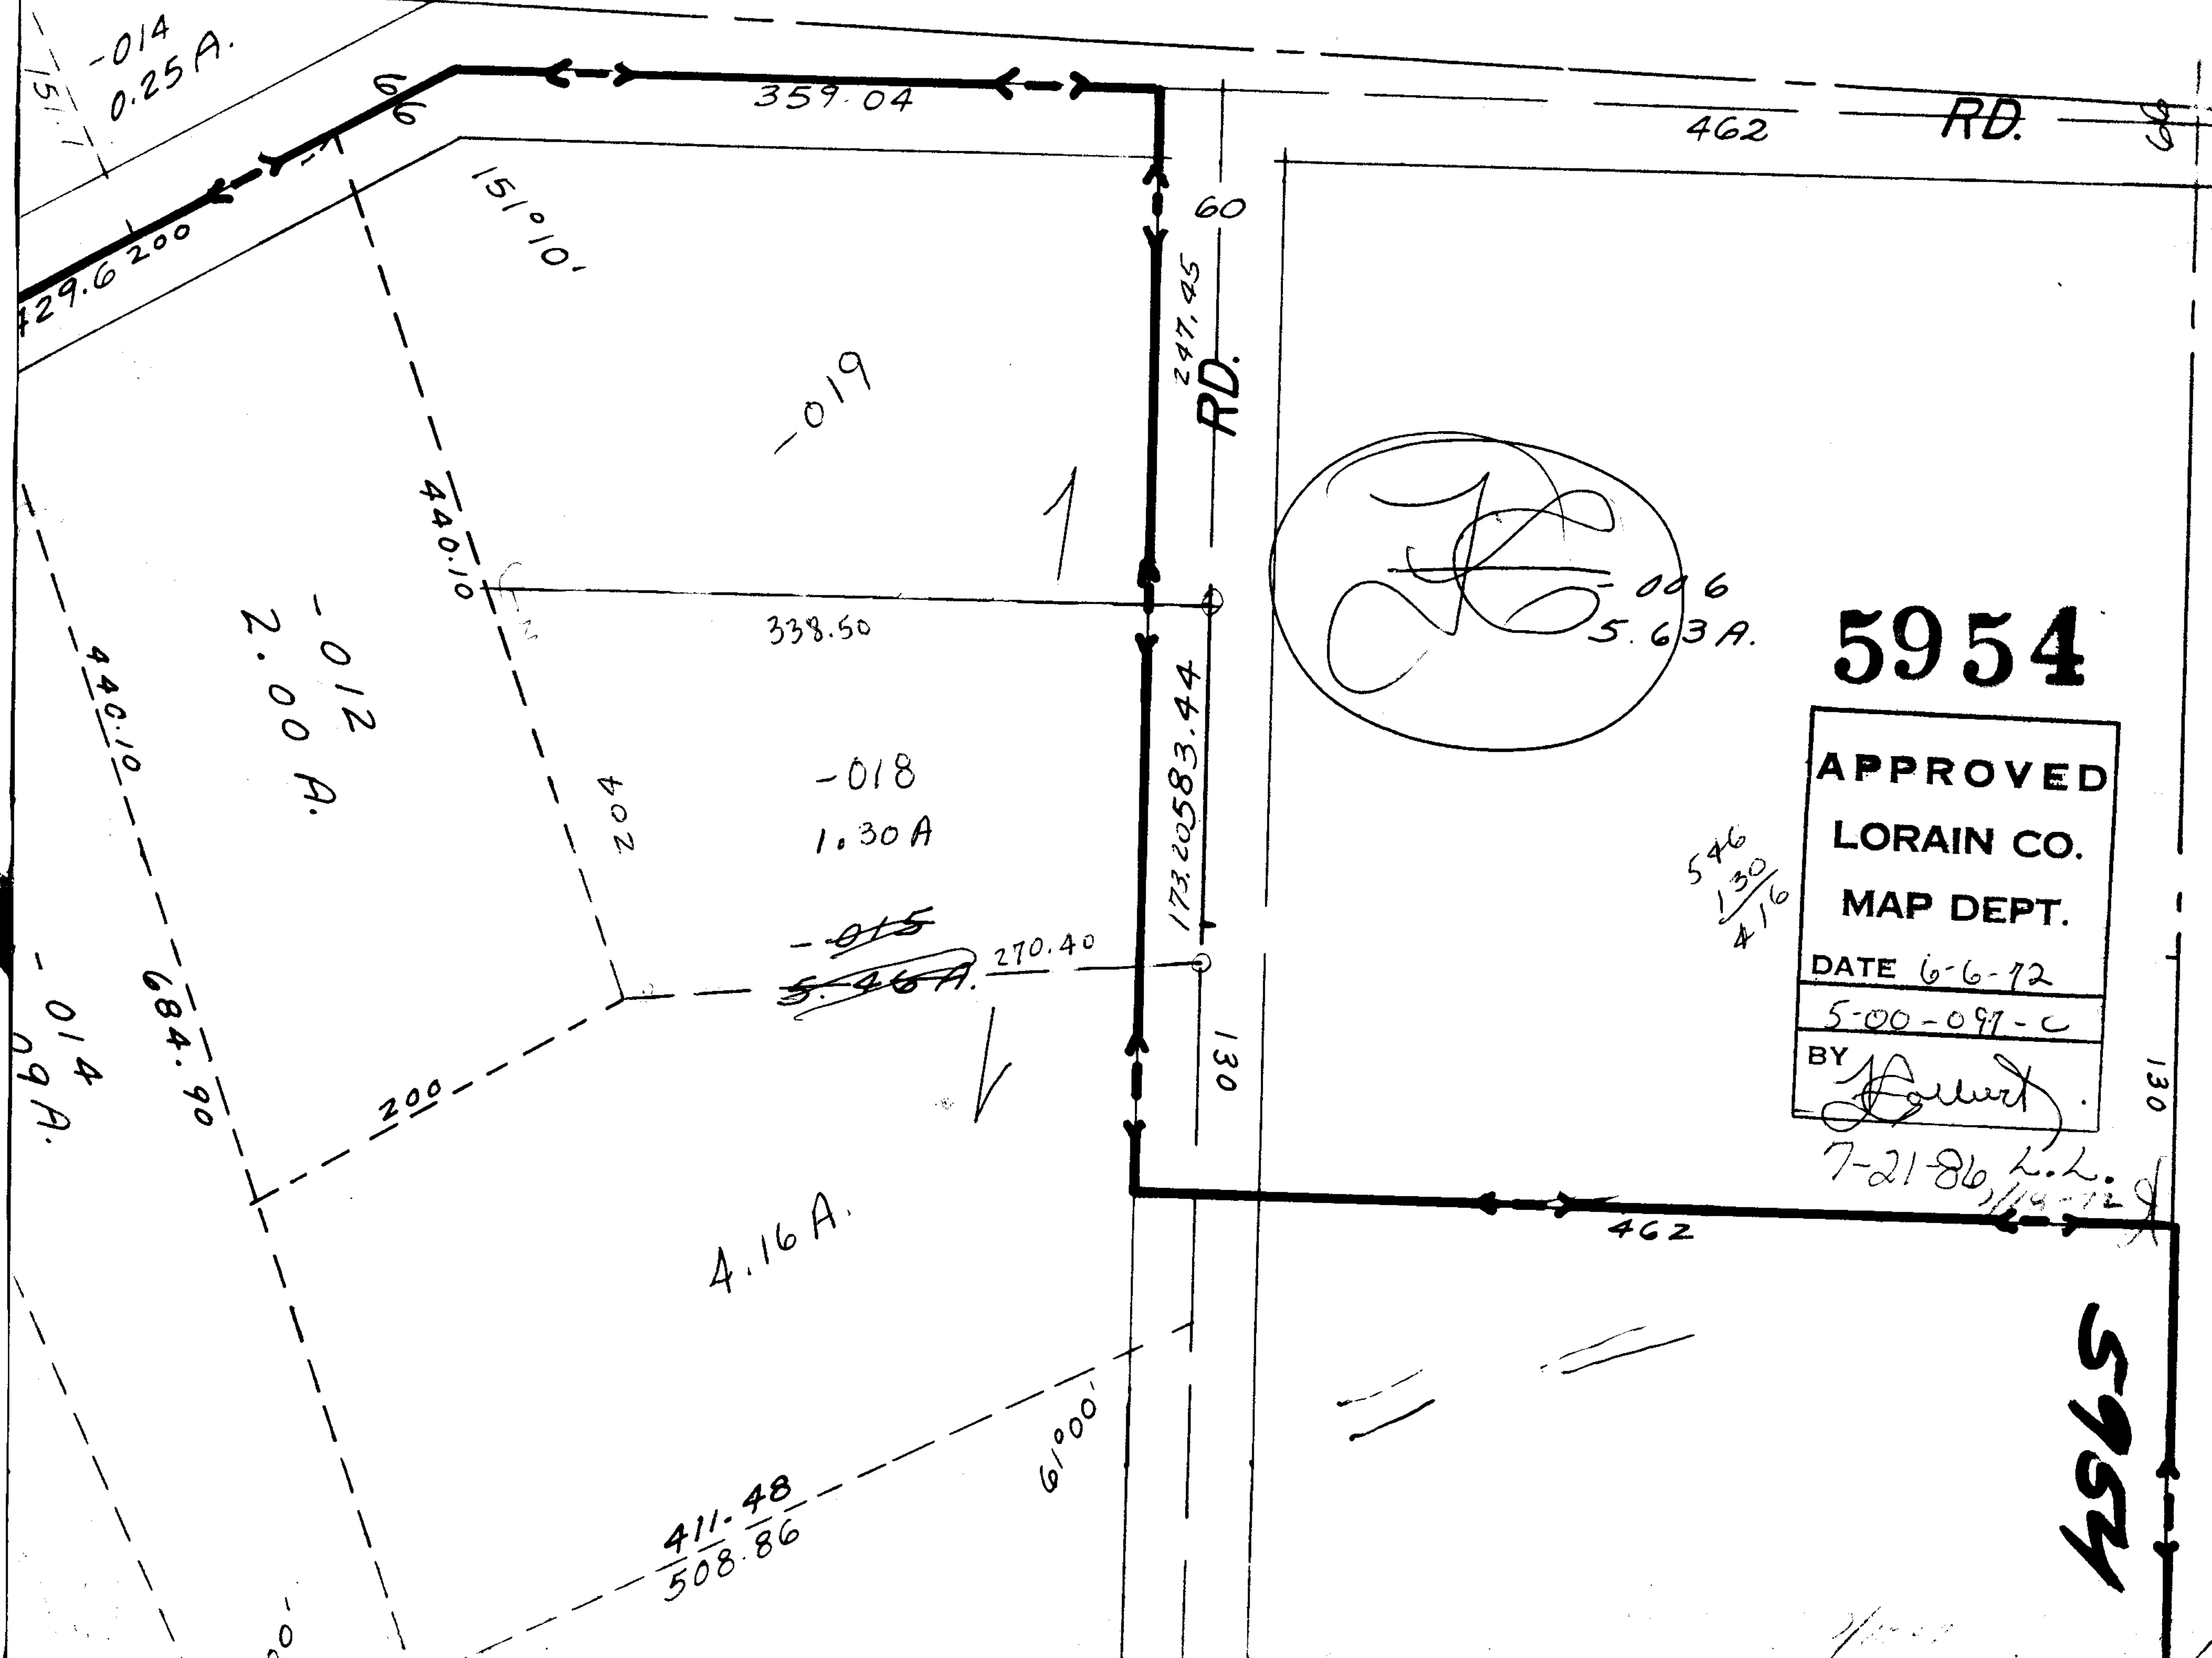

5954

APPROVED  
 LORAIN CO.  
 MAP DEPT.  
 DATE 6-6-72  
 5-00-097-C  
 BY *[Signature]*

$\frac{546}{130} = 416$

7-21-86, L.L.  
 1/14-72

5954