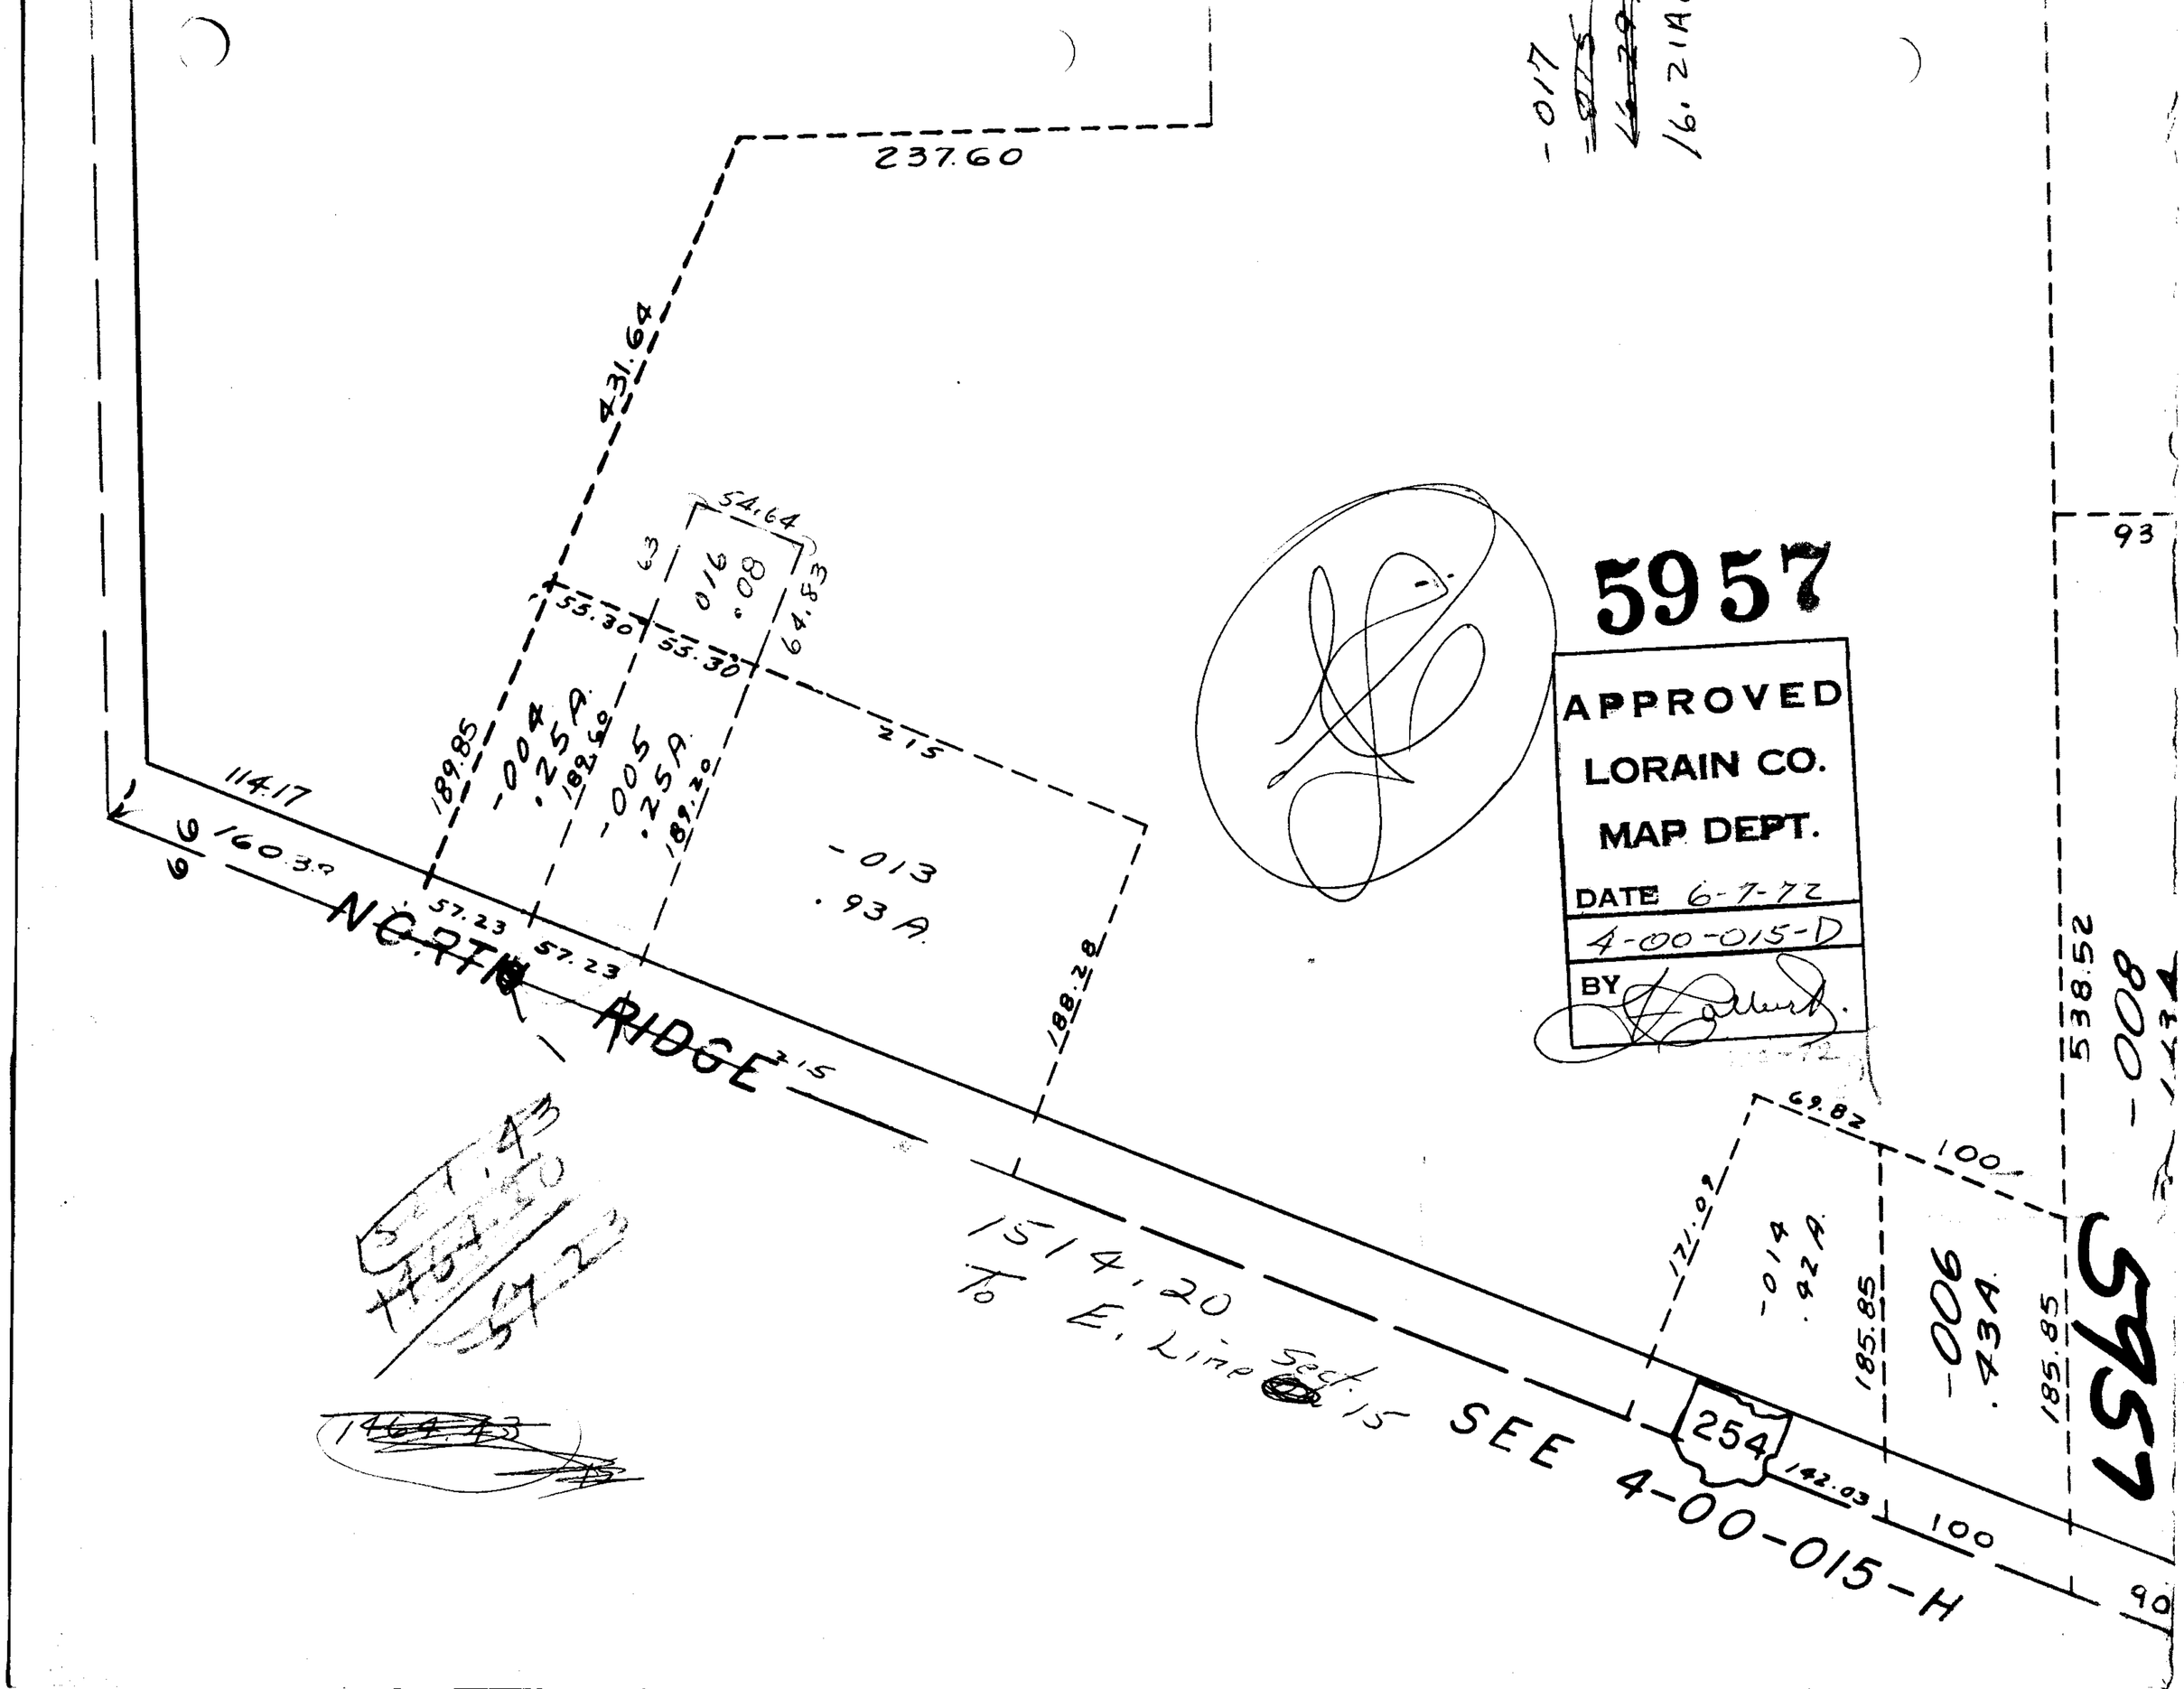

237.60
431.64
54.64
63
016
.08
64.83
55.30
55.30
189.85
-004
.25A.
189.60
-005
.25A.
189.20
215
-013
.93A.
114.17
160.39
57.23
57.23
NORTH RIDGE
188.28
215
1514.20
To E. Line Sect. 15
SEE 4-00-015-H
254
142.03
100
100
171.09
69.82
-014
.42A.
185.85
-006
.43A.
185.85
538.52
-008
93
90
-017
16.21A
5957
APPROVED
LORAIN CO.
MAP DEPT.
DATE 6-7-72
4-00-015-D
BY