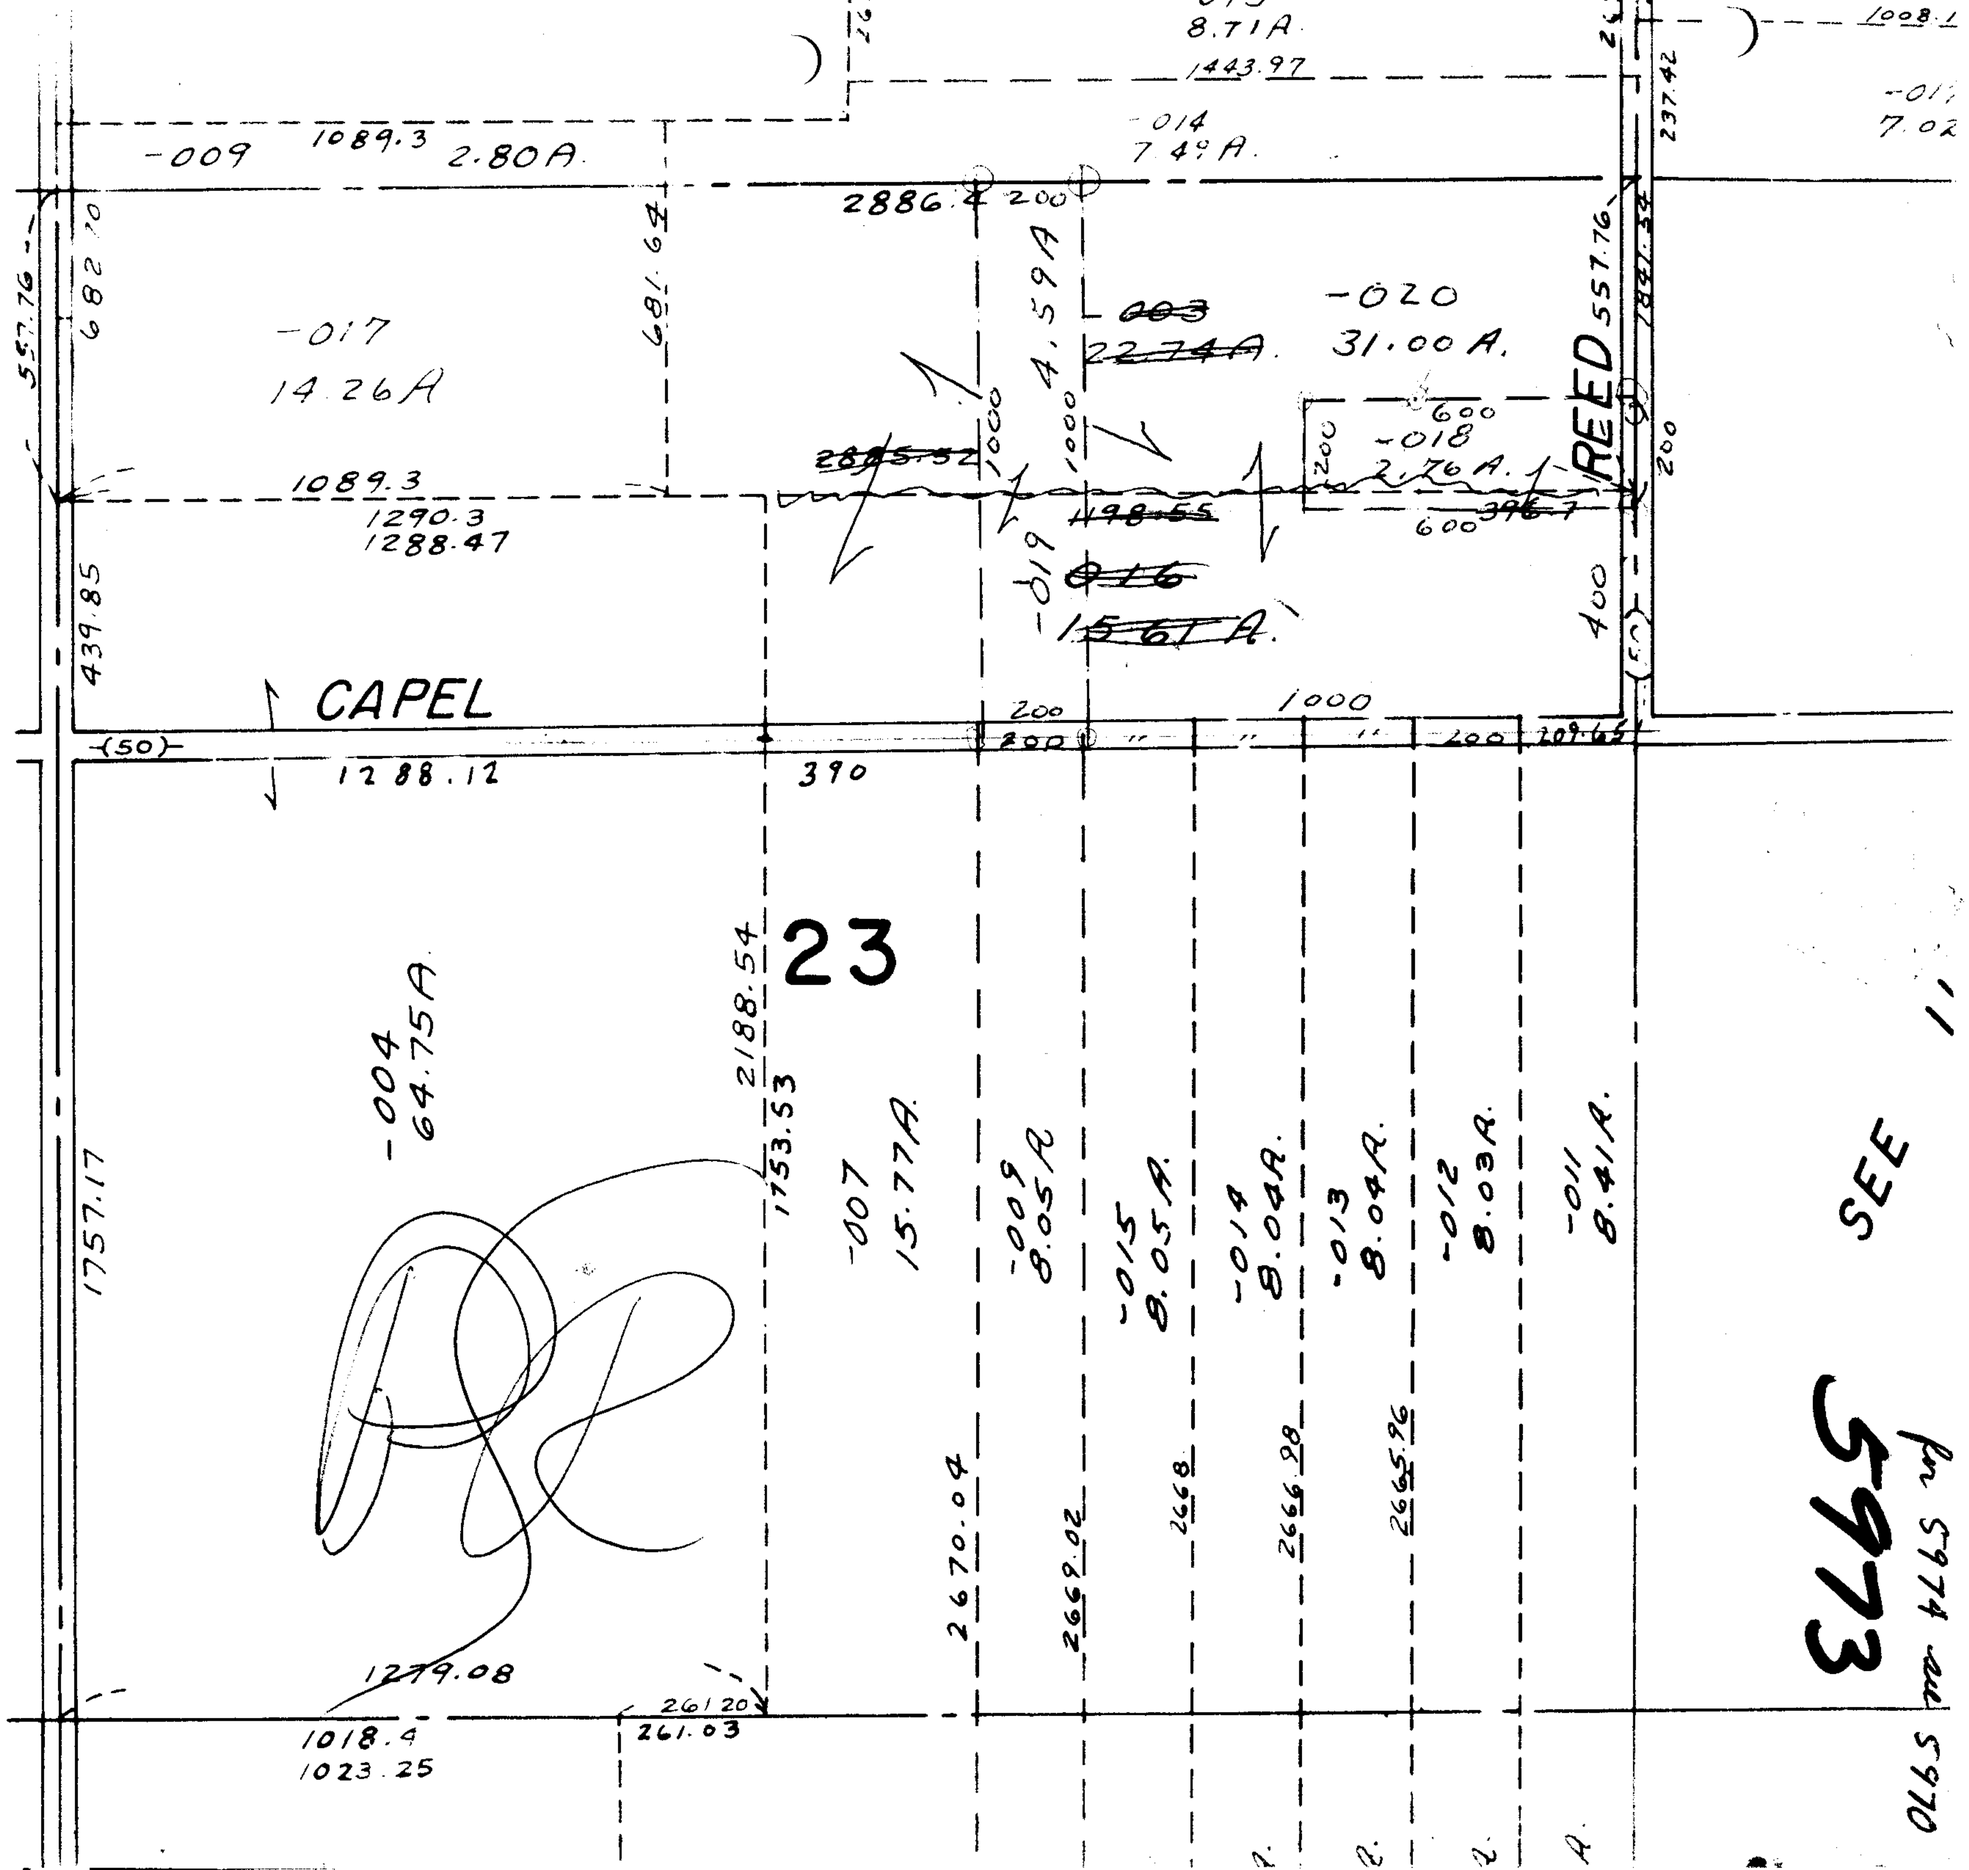

5973

APPROVED
LORAIN CO.
MAP DEPT.
DATE 6-8-72
11-H
BY

5973

for 5974 see 5970