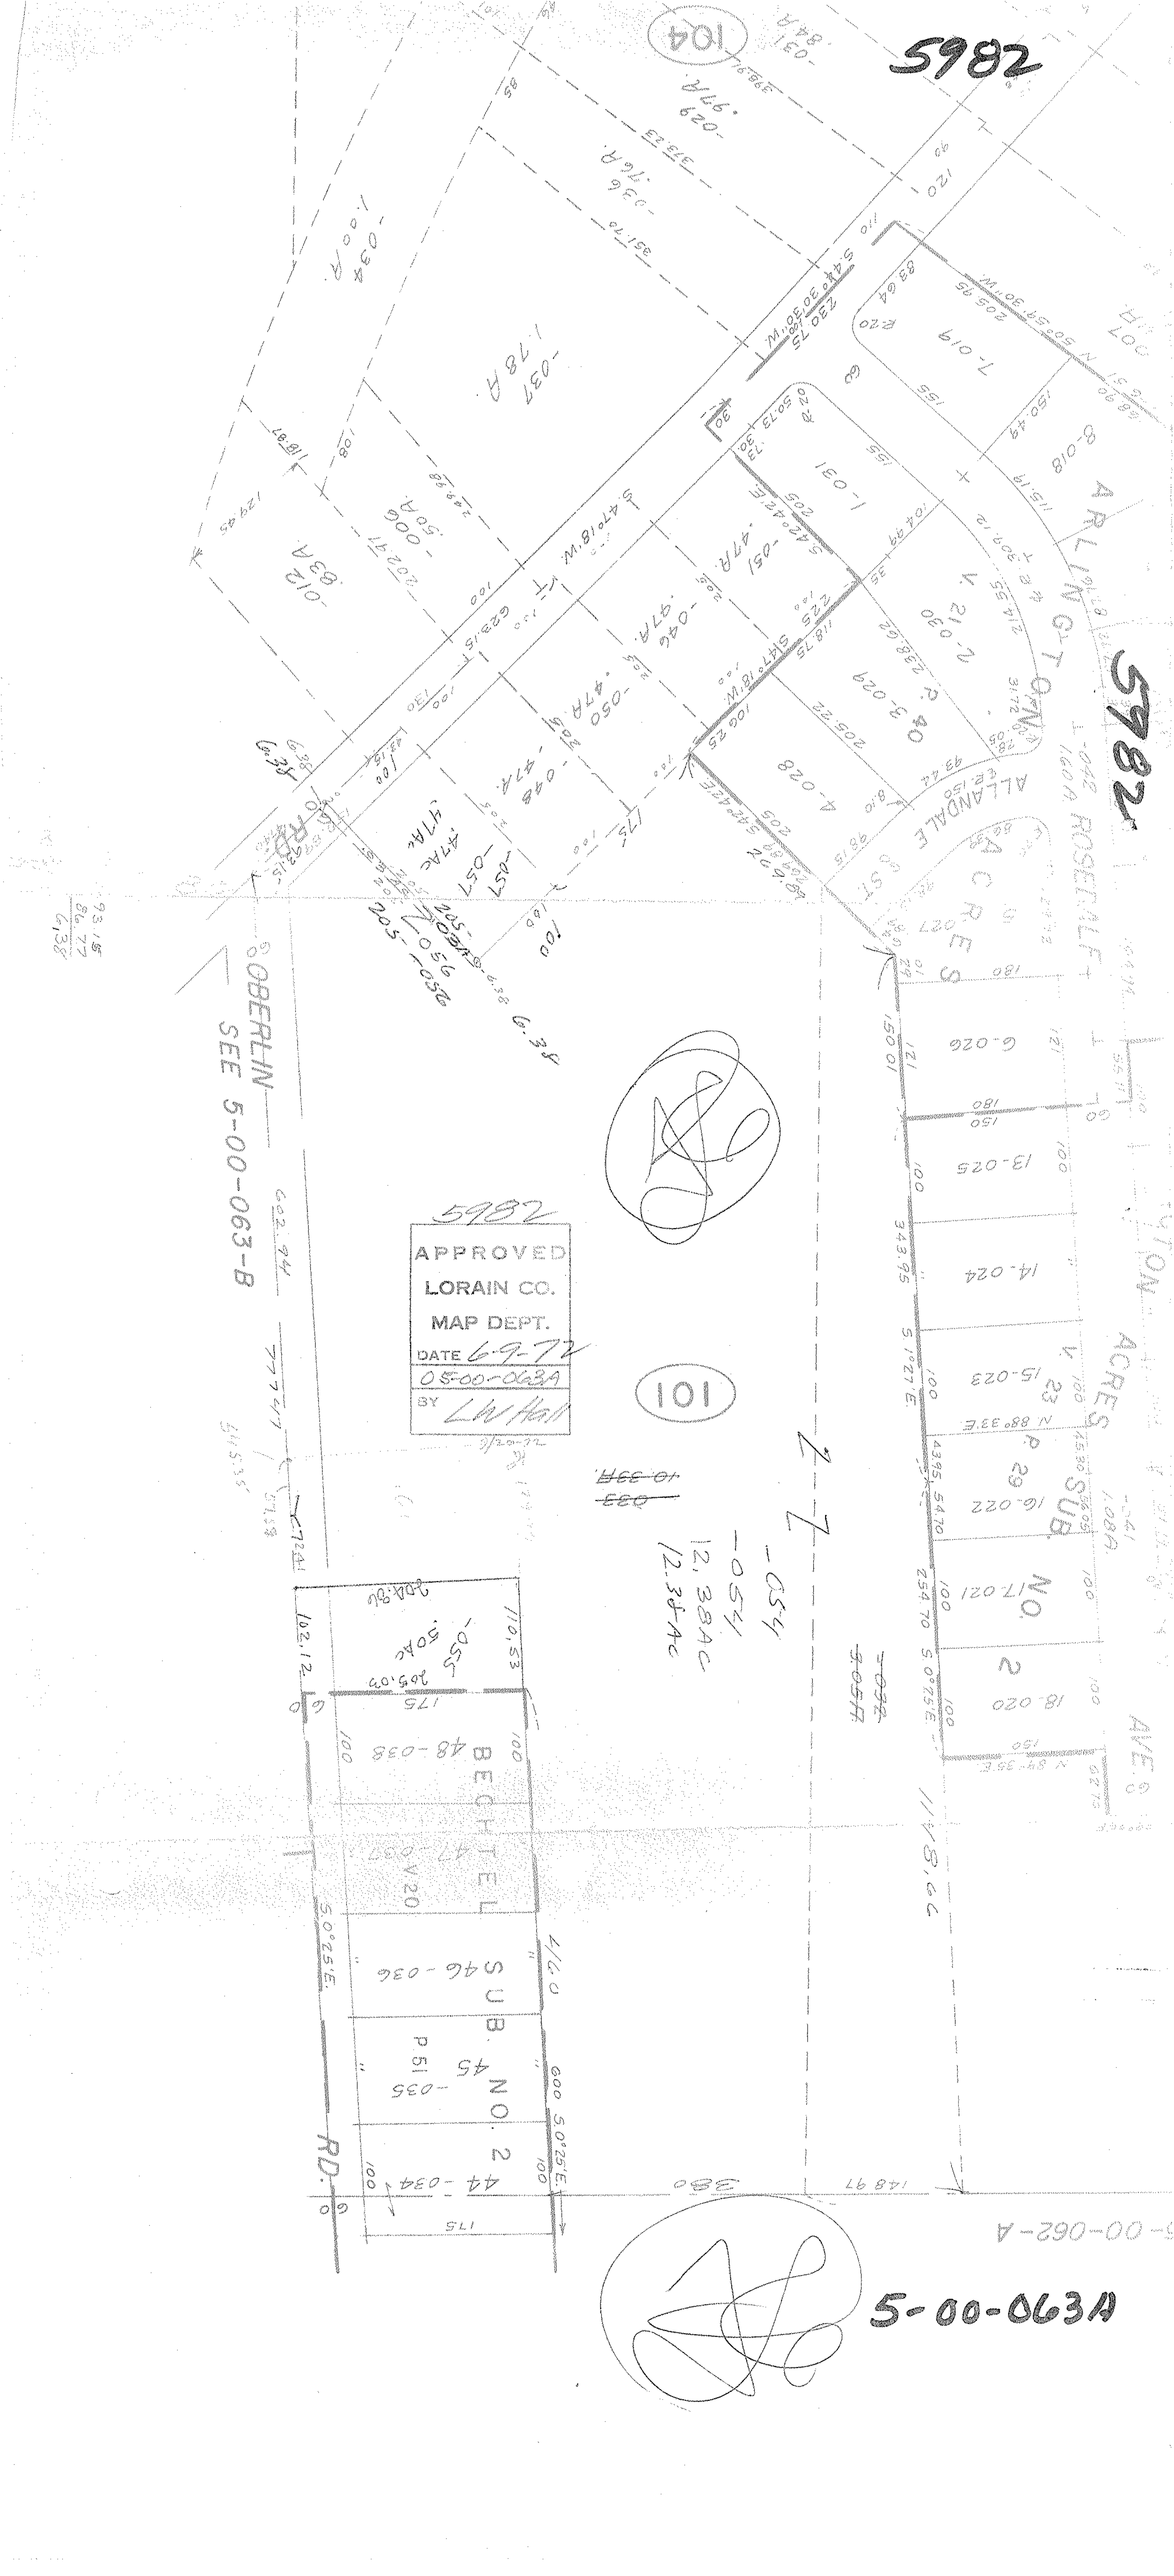
5982
104
ARLINGTON
ALLANDALE ST.
ROSEDALE
ACRES
OBERLIN
SEE 5-00-063-B
5982
APPROVED
LORAIN CO.
MAP DEPT.
DATE 6-9-72
05-00-063A
BY LW Hall
101
BECHTEL SUB. NO. 2
RD.
5-00-062-A
5-00-063A