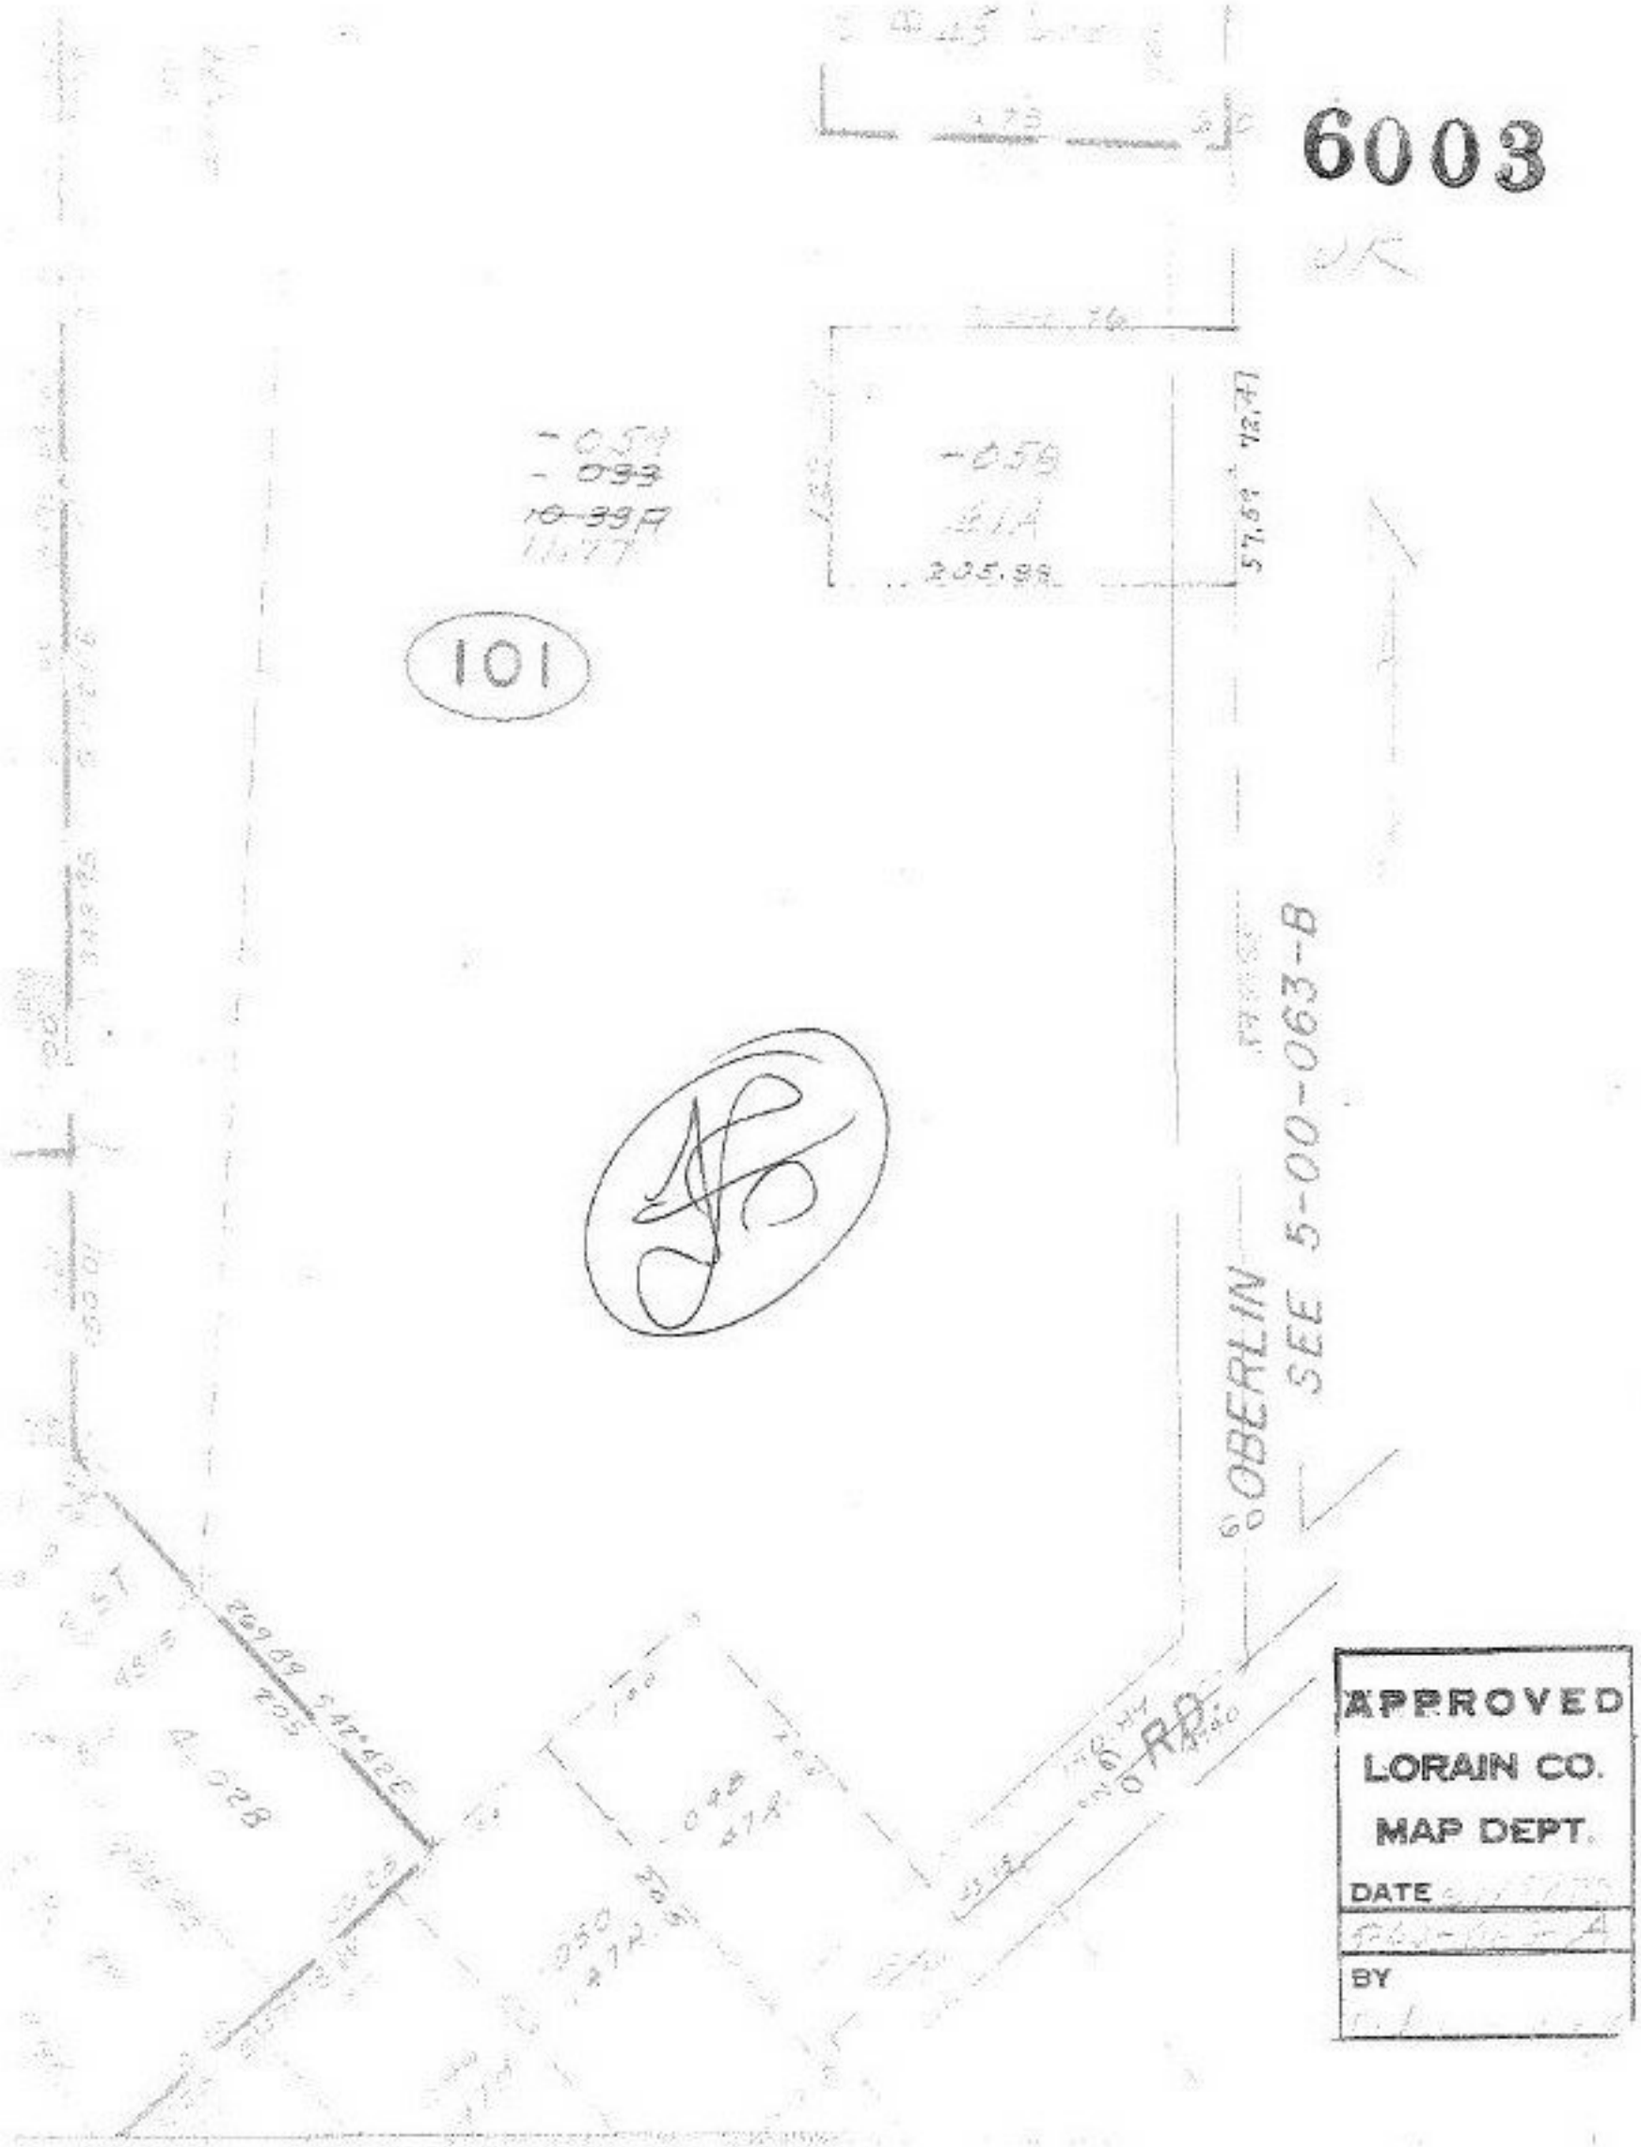
6003
101
OBERLIN
SEE 5-00-063-B
APPROVED
LORAIN CO.
MAP DEPT.
DATE
BY