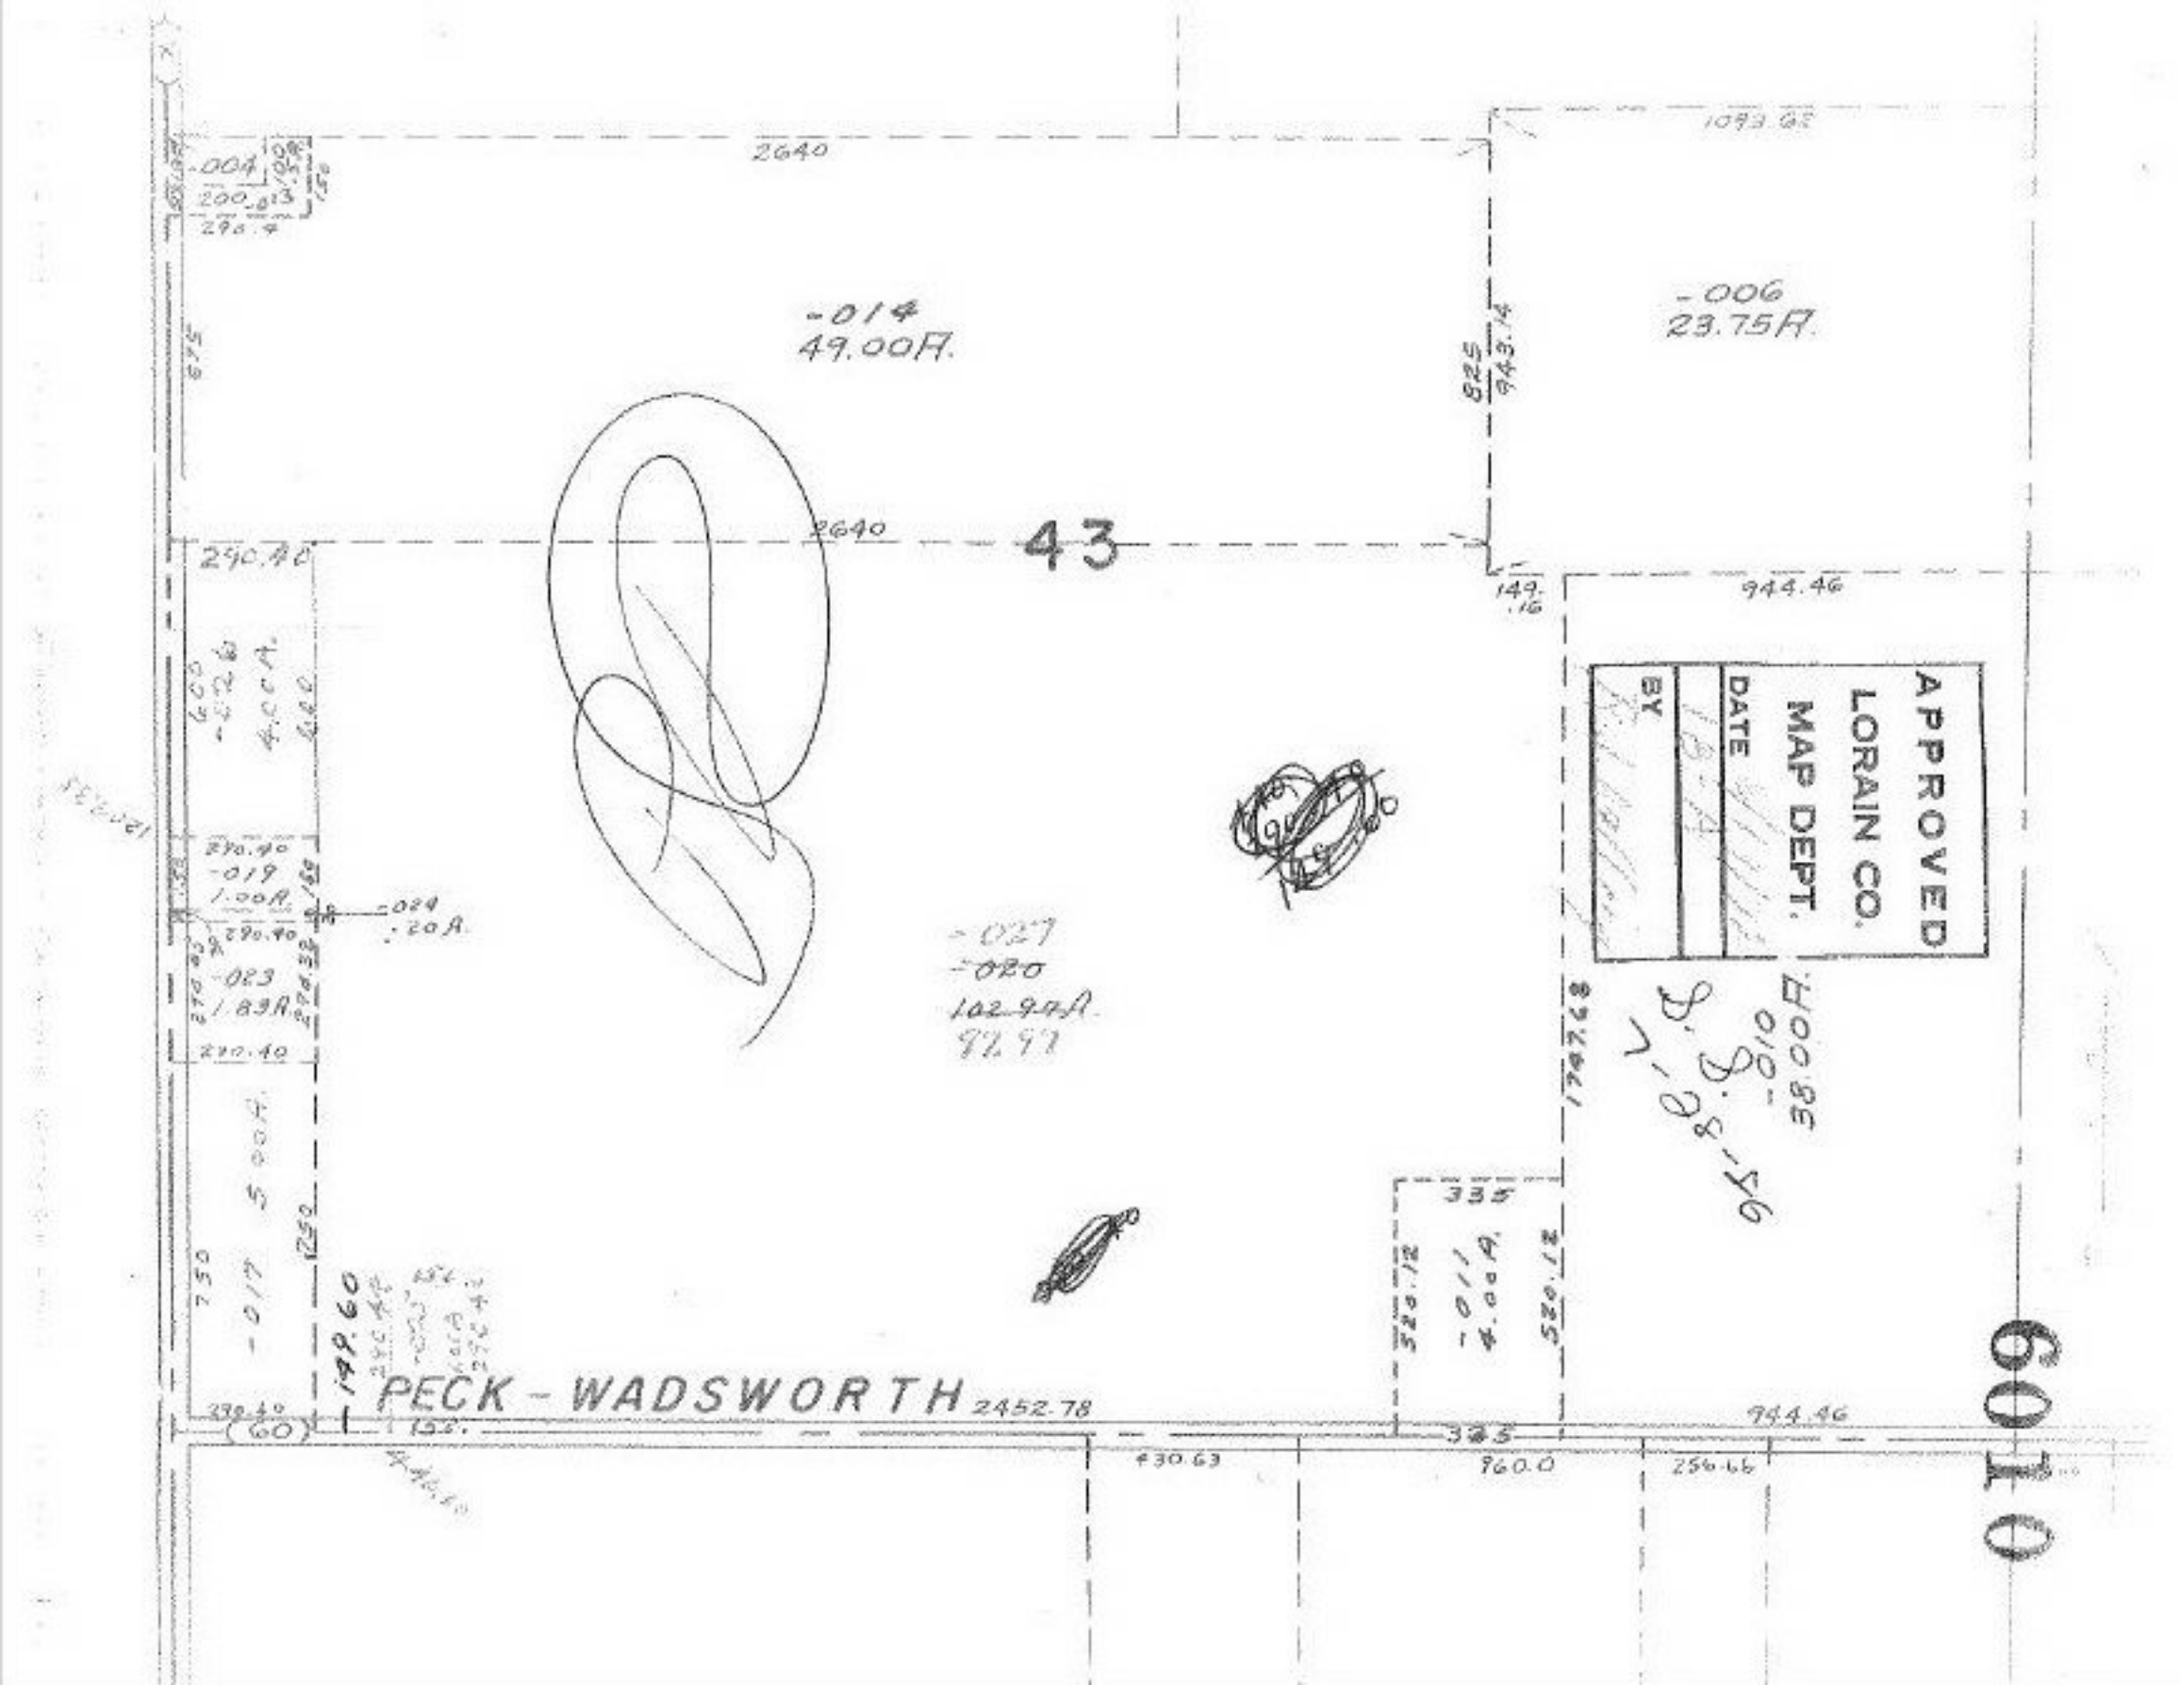
2640
1093.62
-004
200.83
296.4
-014
49.00A.
825
943.14
-006
23.75A.
43
2640
290.40
149.16
944.46
APPROVED
LORAIN CO.
MAP DEPT.
DATE
BY
-026
4.00A.
-019
1.00A.
-024
.20A.
-023
1.89A.
-027
-020
102.90A.
92.97
-011
4.00A.
335
320.12
1742.68
400.83
-010-
5.98A.
-017
5.00A.
1250
750
149.60
PECK - WADSWORTH 2452.78
(60)
132.
430.63
960.0
256.66
944.46
60