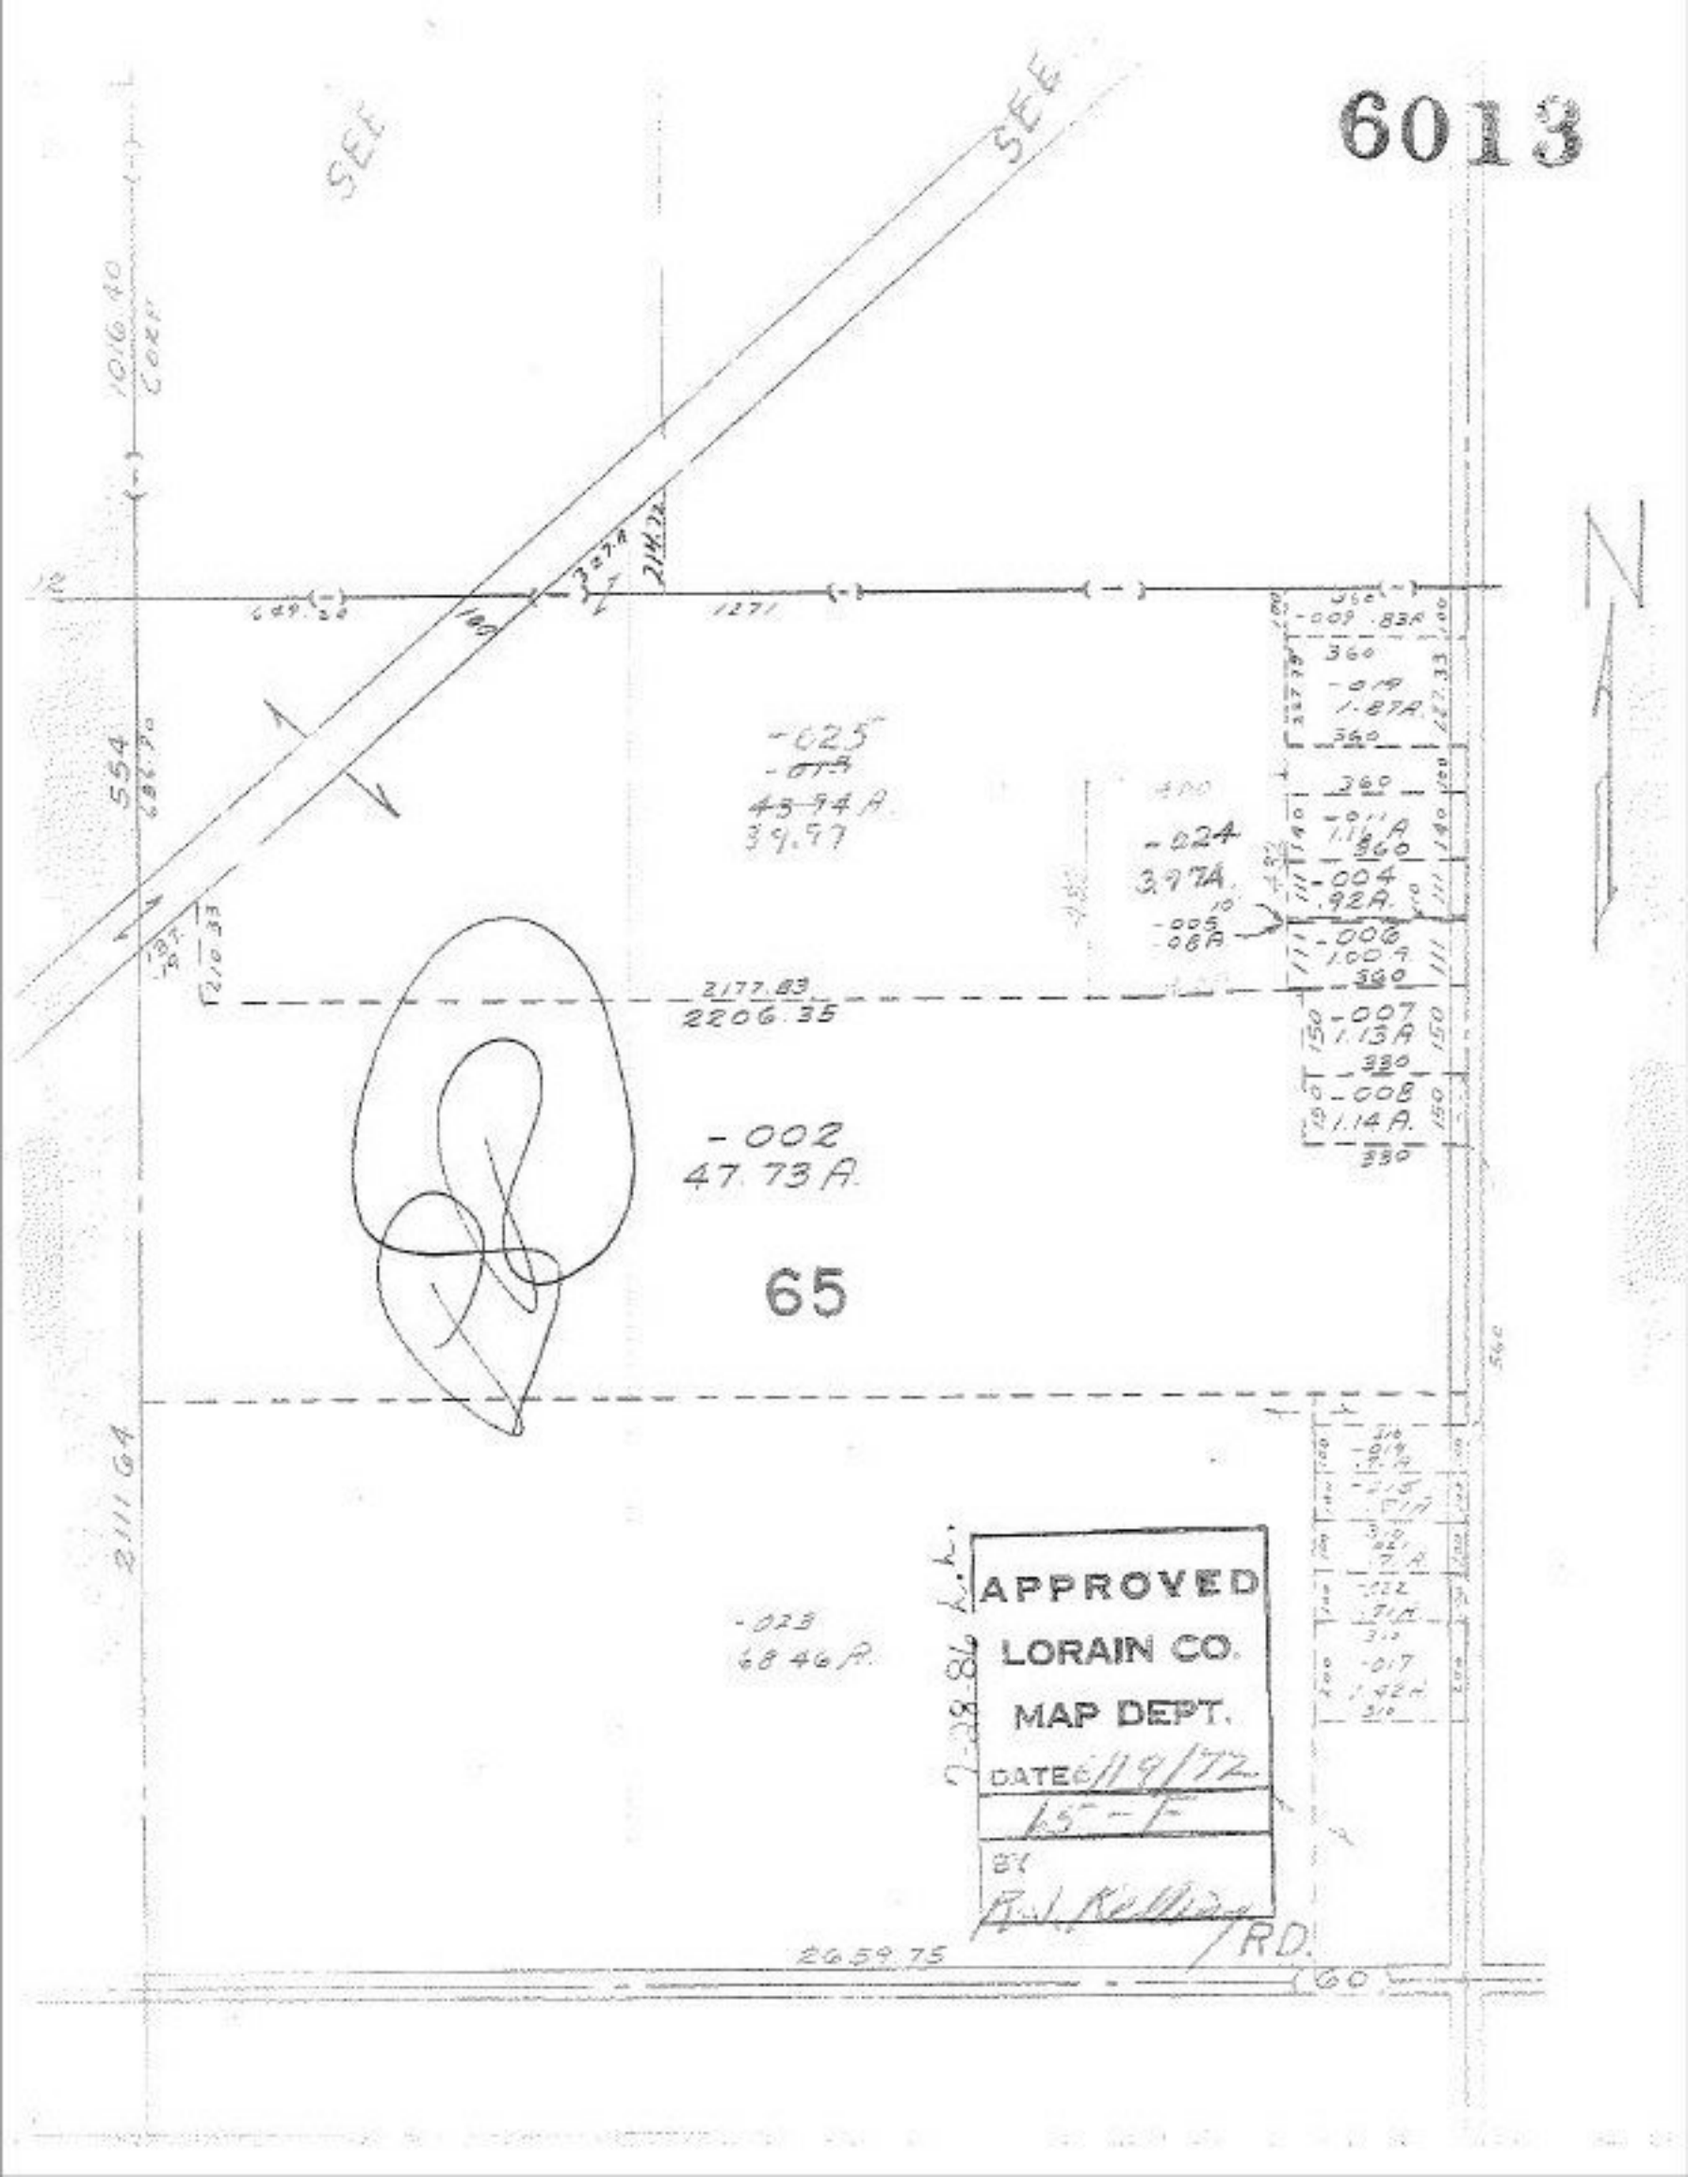
6013
SEE
SEE
1016.40
CORP
554
2111.64
649.20
1271
-025
-013
43.94 A.
39.97
-024
3.97A.
-005
.08A
-009 .83A
-019
1.87A.
-011
1.16 A
-004
.92A.
-006
1.00 A
-007
1.13A
-008
1.14 A.
2177.83
2206.35
-002
47.73 A.
65
-023
68.46 A.
2659.75
60
APPROVED
LORAIN CO.
MAP DEPT.
DATE 6/19/72
15-F
BY
R.J. Kelley
RD.