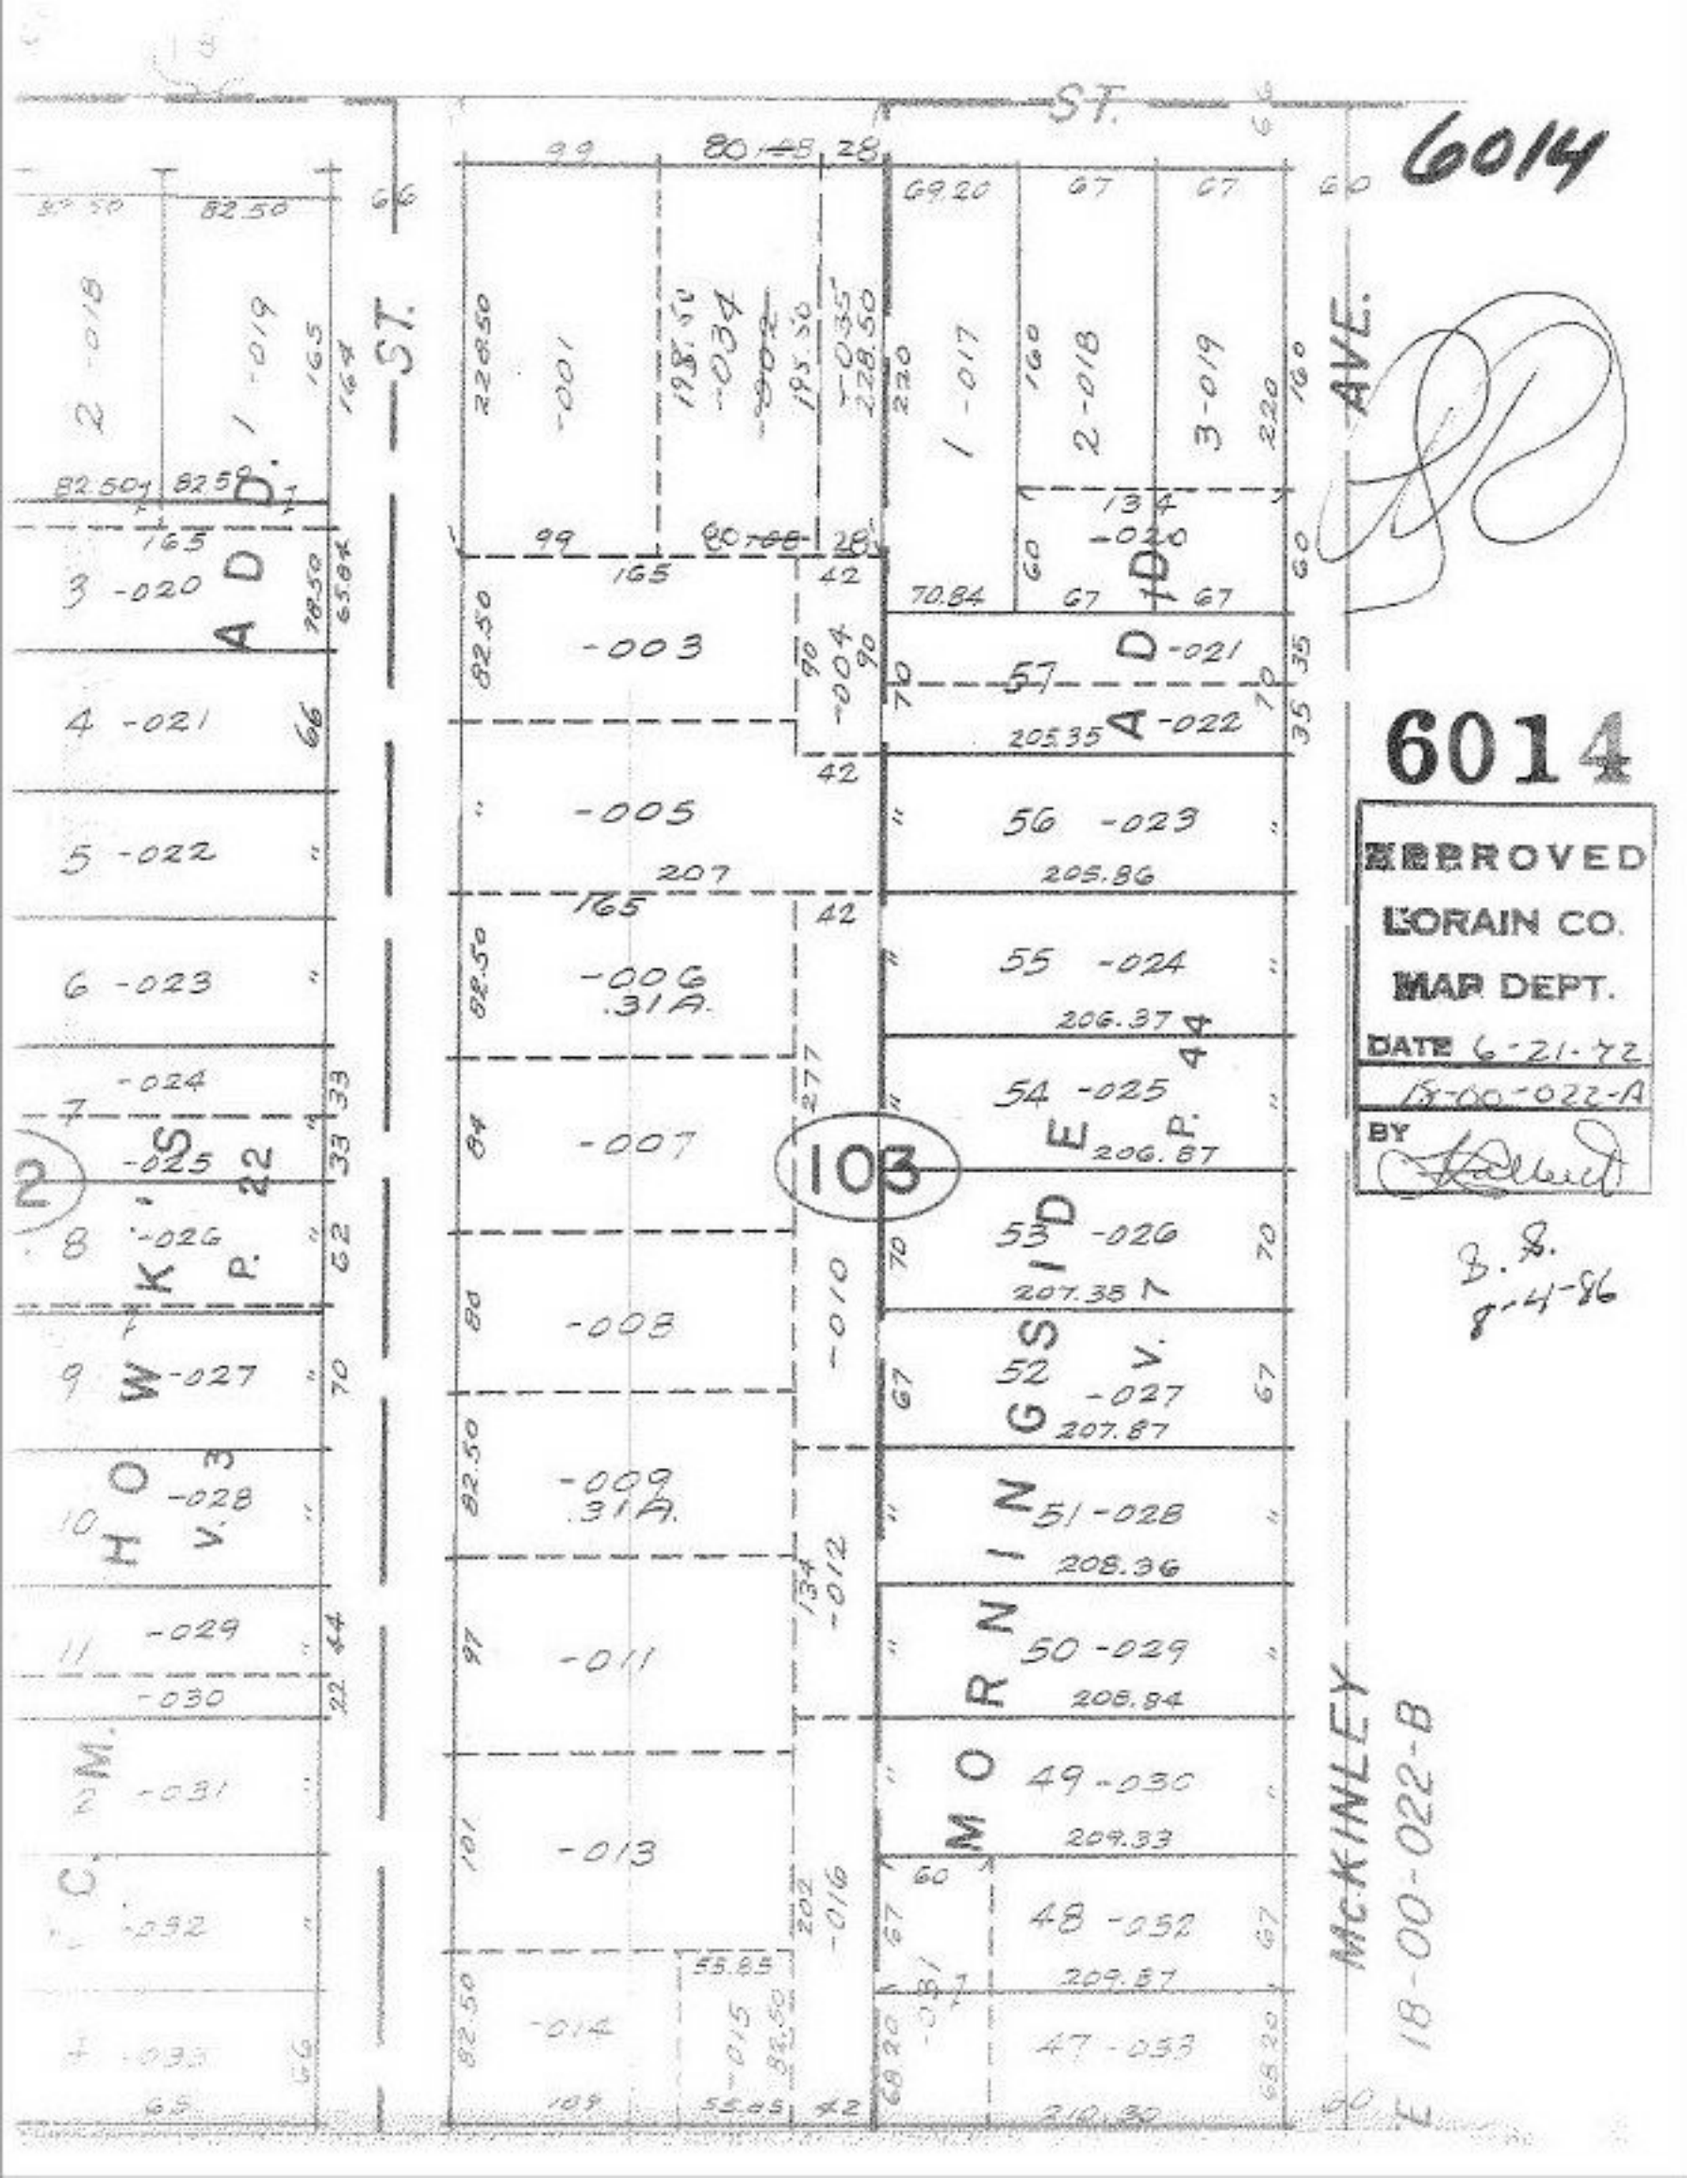
6014
ST.
AVE.
McKINLEY
E 18-00-022-B
ADD.
HOWK
MORNINGSIDE
103
-001
-003
-004
-005
-006
.31A.
-007
-008
-009
.31A.
-010
-011
-012
-013
-014
-015
-016
-017
-018
-019
-020
-021
-022
-023
-024
-025
-026
-027
-028
-029
-030
-031
-032
-033
-034
-035
-036
-052
-053
APPROVED
LORAIN CO.
MAP DEPT.
DATE 6-21-72
18-00-022-A
BY
B. S.
8-4-86