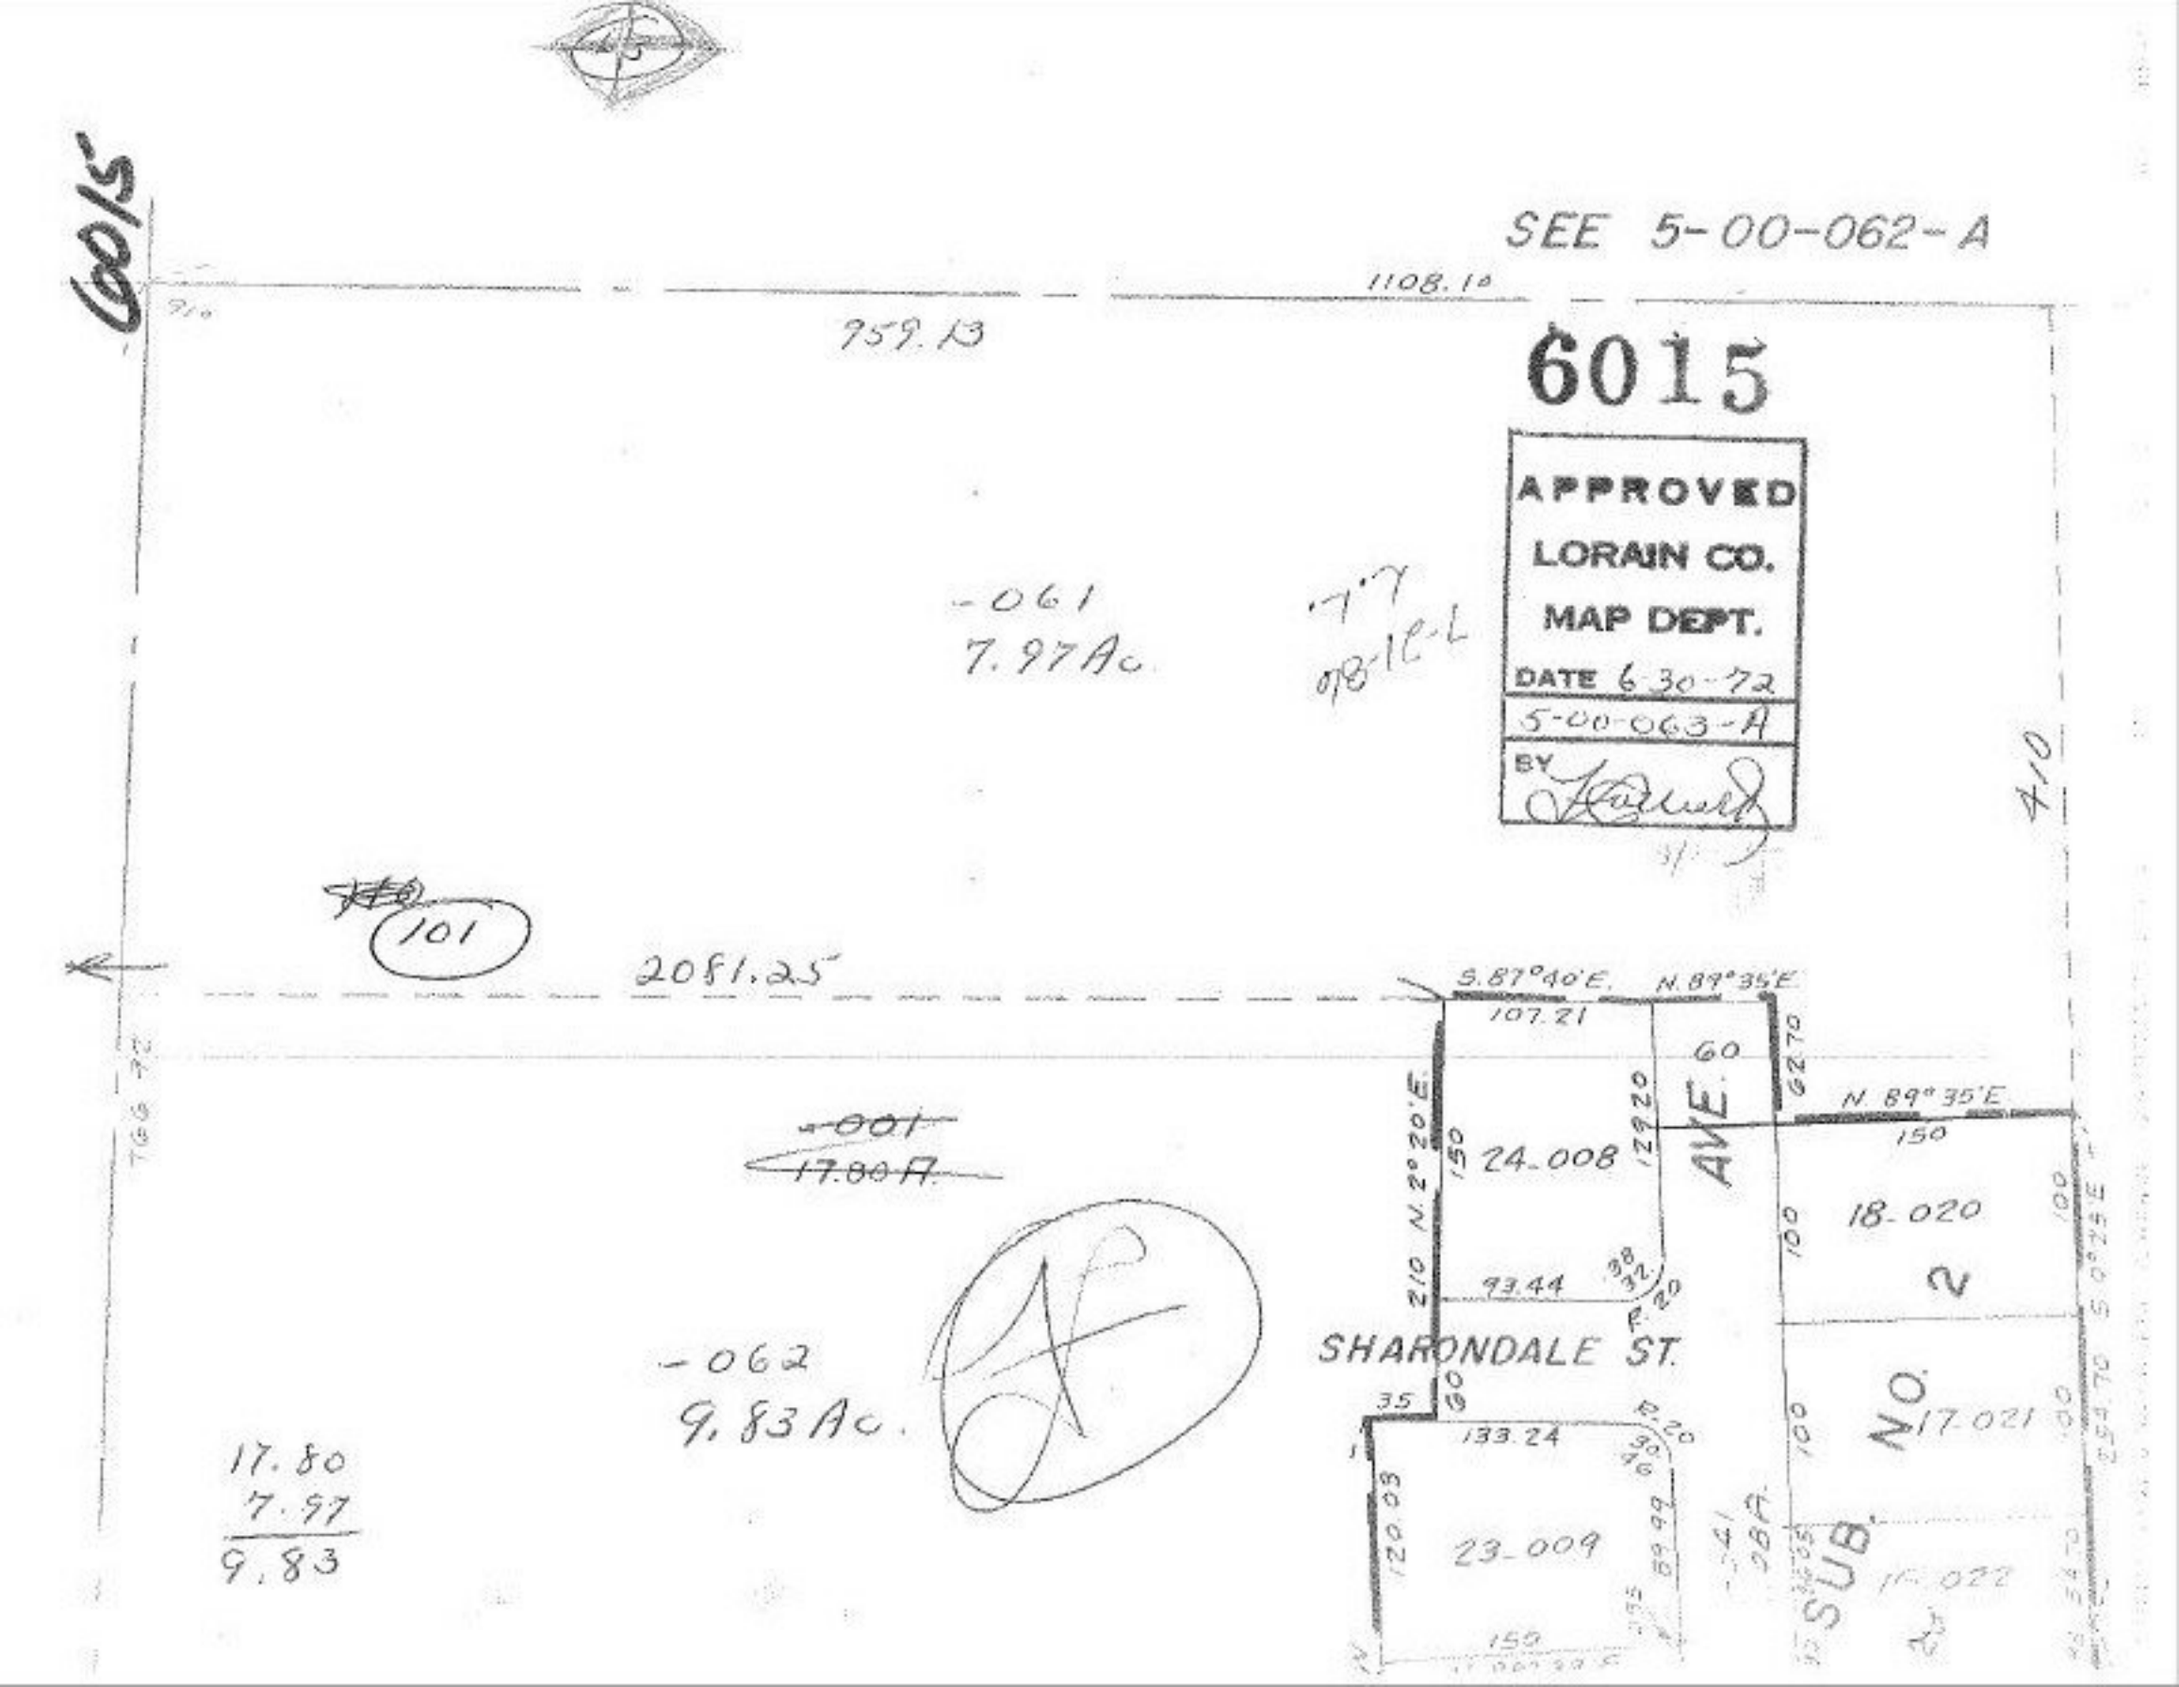
6015
SEE 5-00-062-A
1108.10
959.13
APPROVED
LORAIN CO.
MAP DEPT.
DATE 6-30-72
5-00-063-A
BY
-061
7.97Ac.
7.7
018-16-L
101
2081.25
S.87°40'E.
N.89°35'E.
107.21
60
AVE.
N 89° 35'E
150
24.008
18.020
2
93.44
SHARONDALE ST.
-062
9.83Ac.
17.80
7.97
9.83
133.24
23.009
17.021
SUB. NO.
410