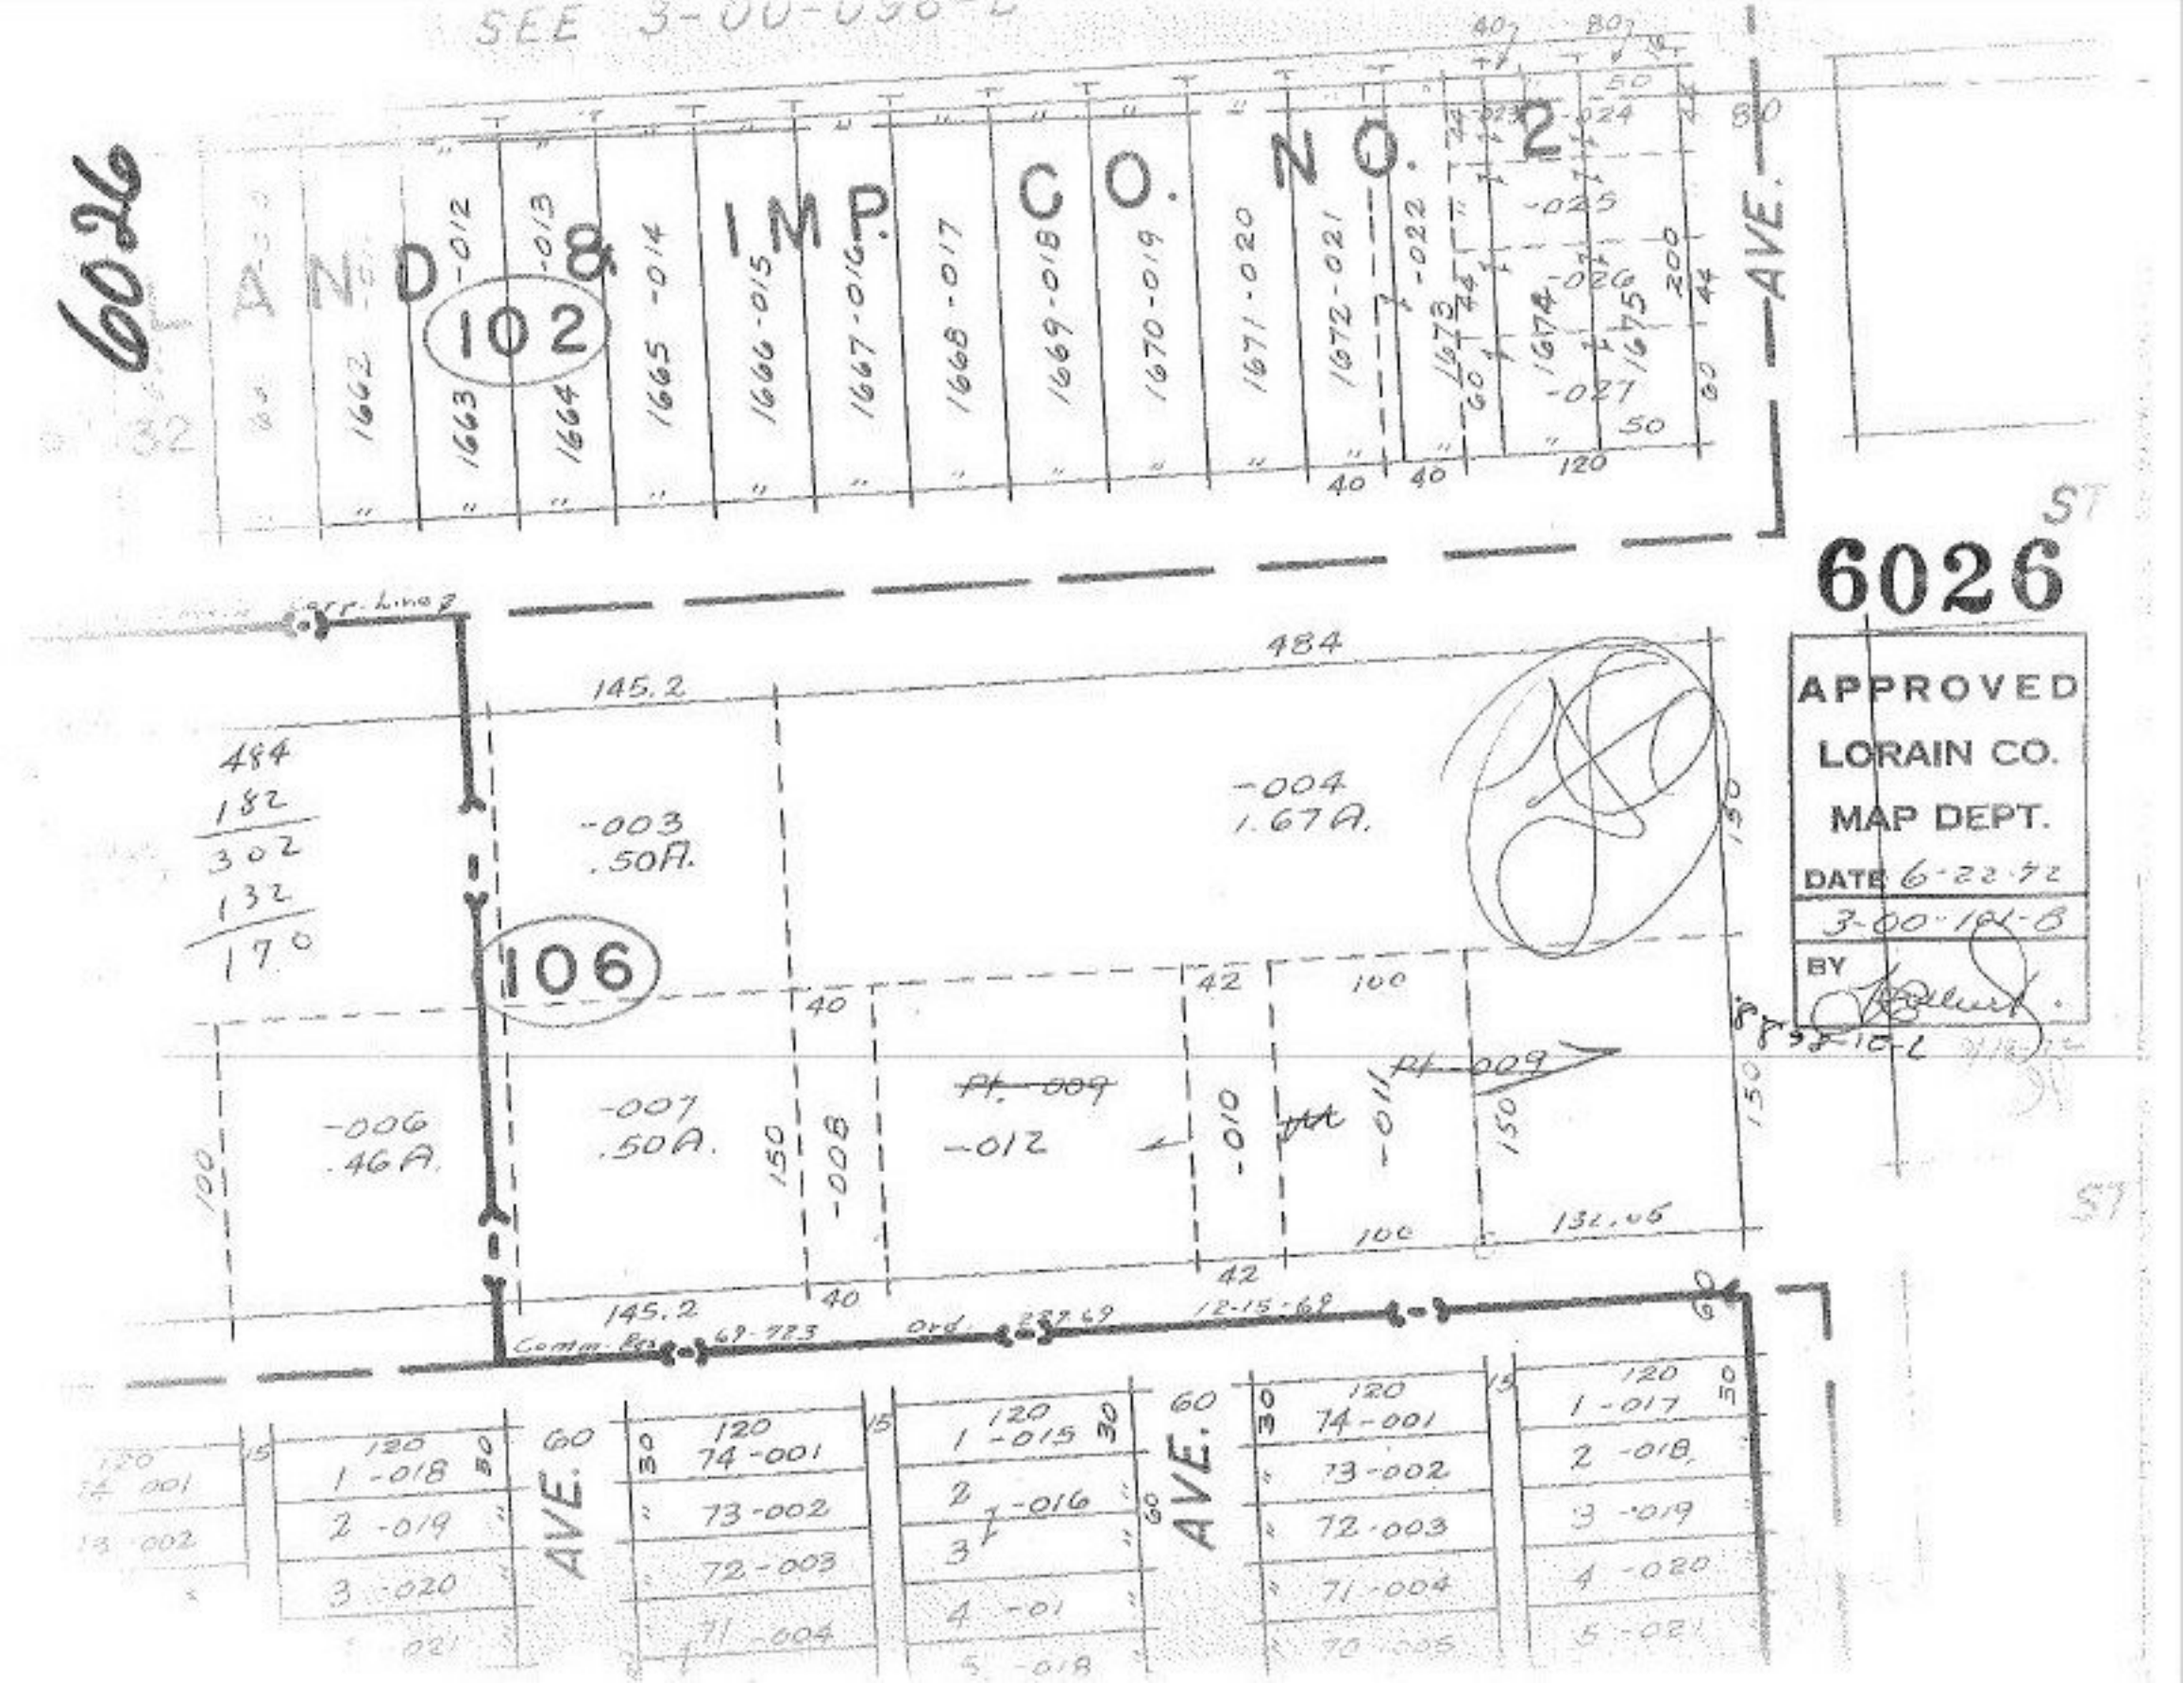

SEE 3-00-098-B
6026
LAND & IMP. CO. NO. 2
102
106
AVE.
ST
6026
APPROVED
LORAIN CO.
MAP DEPT.
DATE 6-22-92
3-00-101-B
BY
Corp. Line
484
145.2
484
182
302
132
170
-003
.50A.
-004
1.67A.
-006
.46A.
-007
.50A.
-008
-012
-010
-011
Pt. 009
132.05
Comm. Res.
69-723
Ord.
12-15-69
1-018
2-019
3-020
74-001
73-002
72-003
71-004
1-015
2-016
3
4-01
5-018
74-001
73-002
72-003
71-004
70-005
1-017
2-018
3-019
4-020
5-021