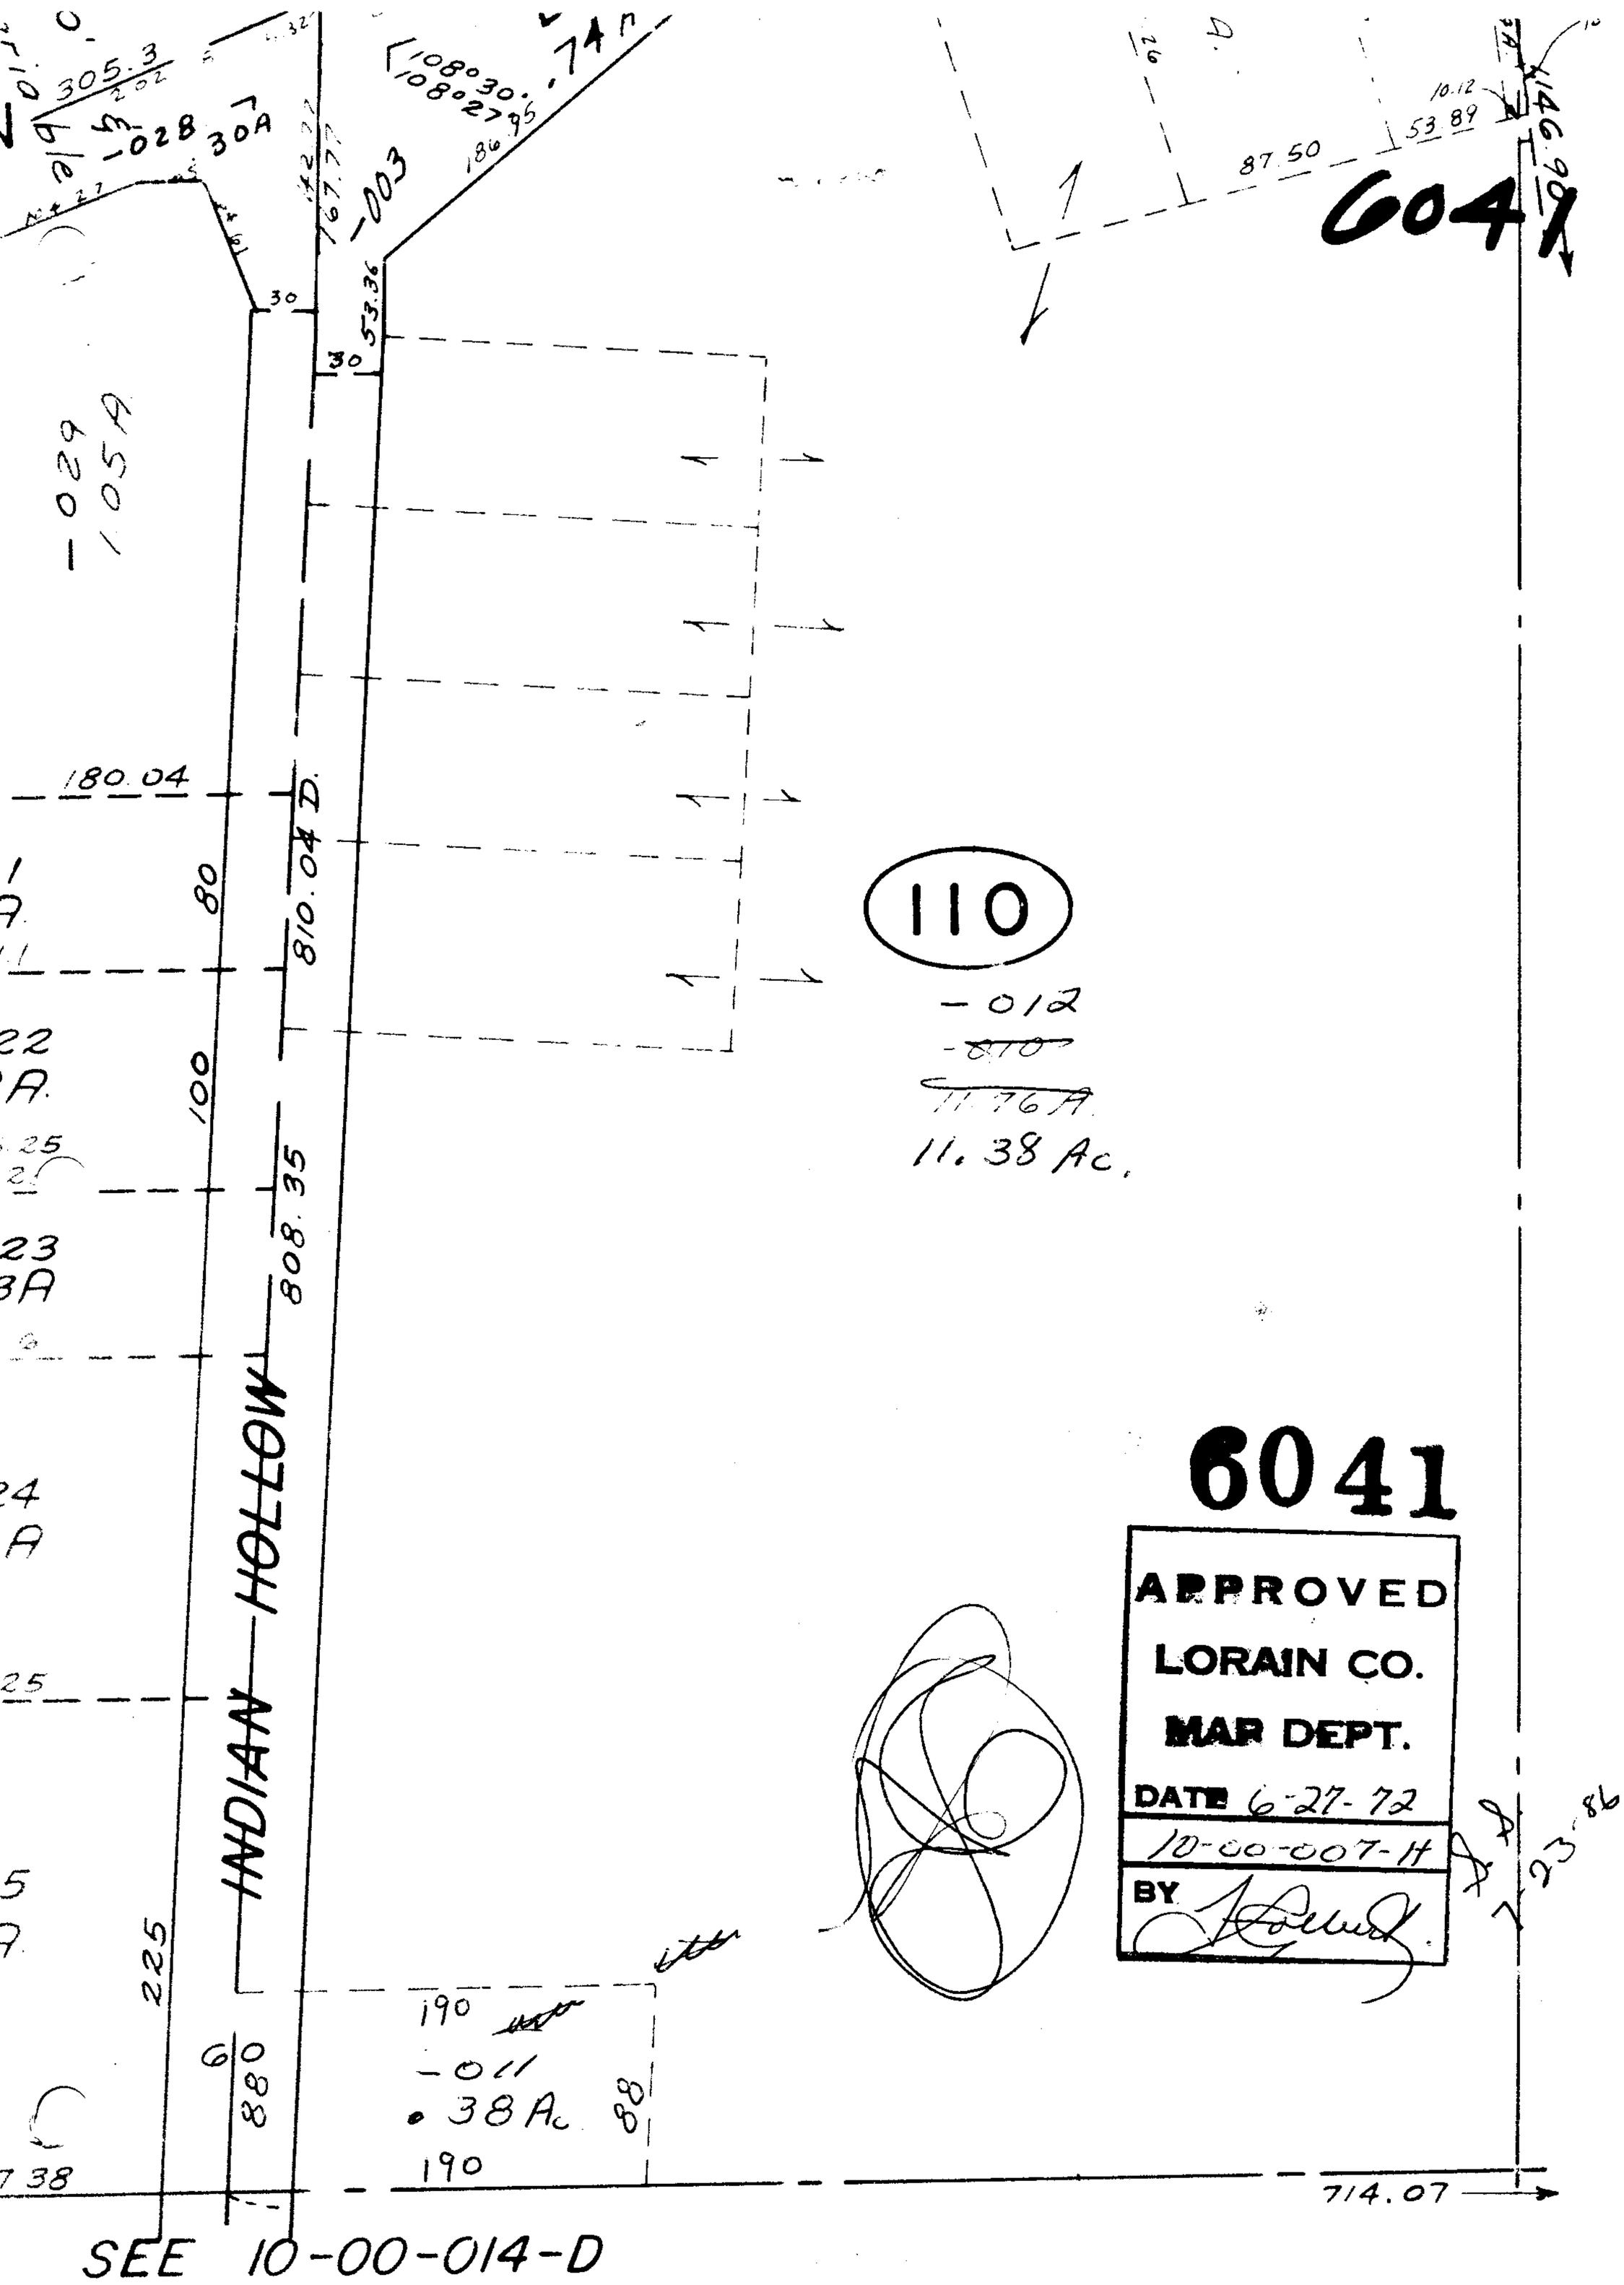
305.3
-028
30A
-003
108030.74 n
108027.96
167.77
53.36
30
-029
1051A
180.04
810.04 D.
80
100
808.35
HOLLOW
INDIAN
225
190
-011
.38 Ac.
190
88
88
714.07
87.50
53.89
10.12
146.96
6041
110
-012
11.38 Ac.
23.86
APPROVED
LORAIN CO.
MAR DEPT.
DATE 6-27-72
10-00-007-14
BY
SEE 10-00-014-D