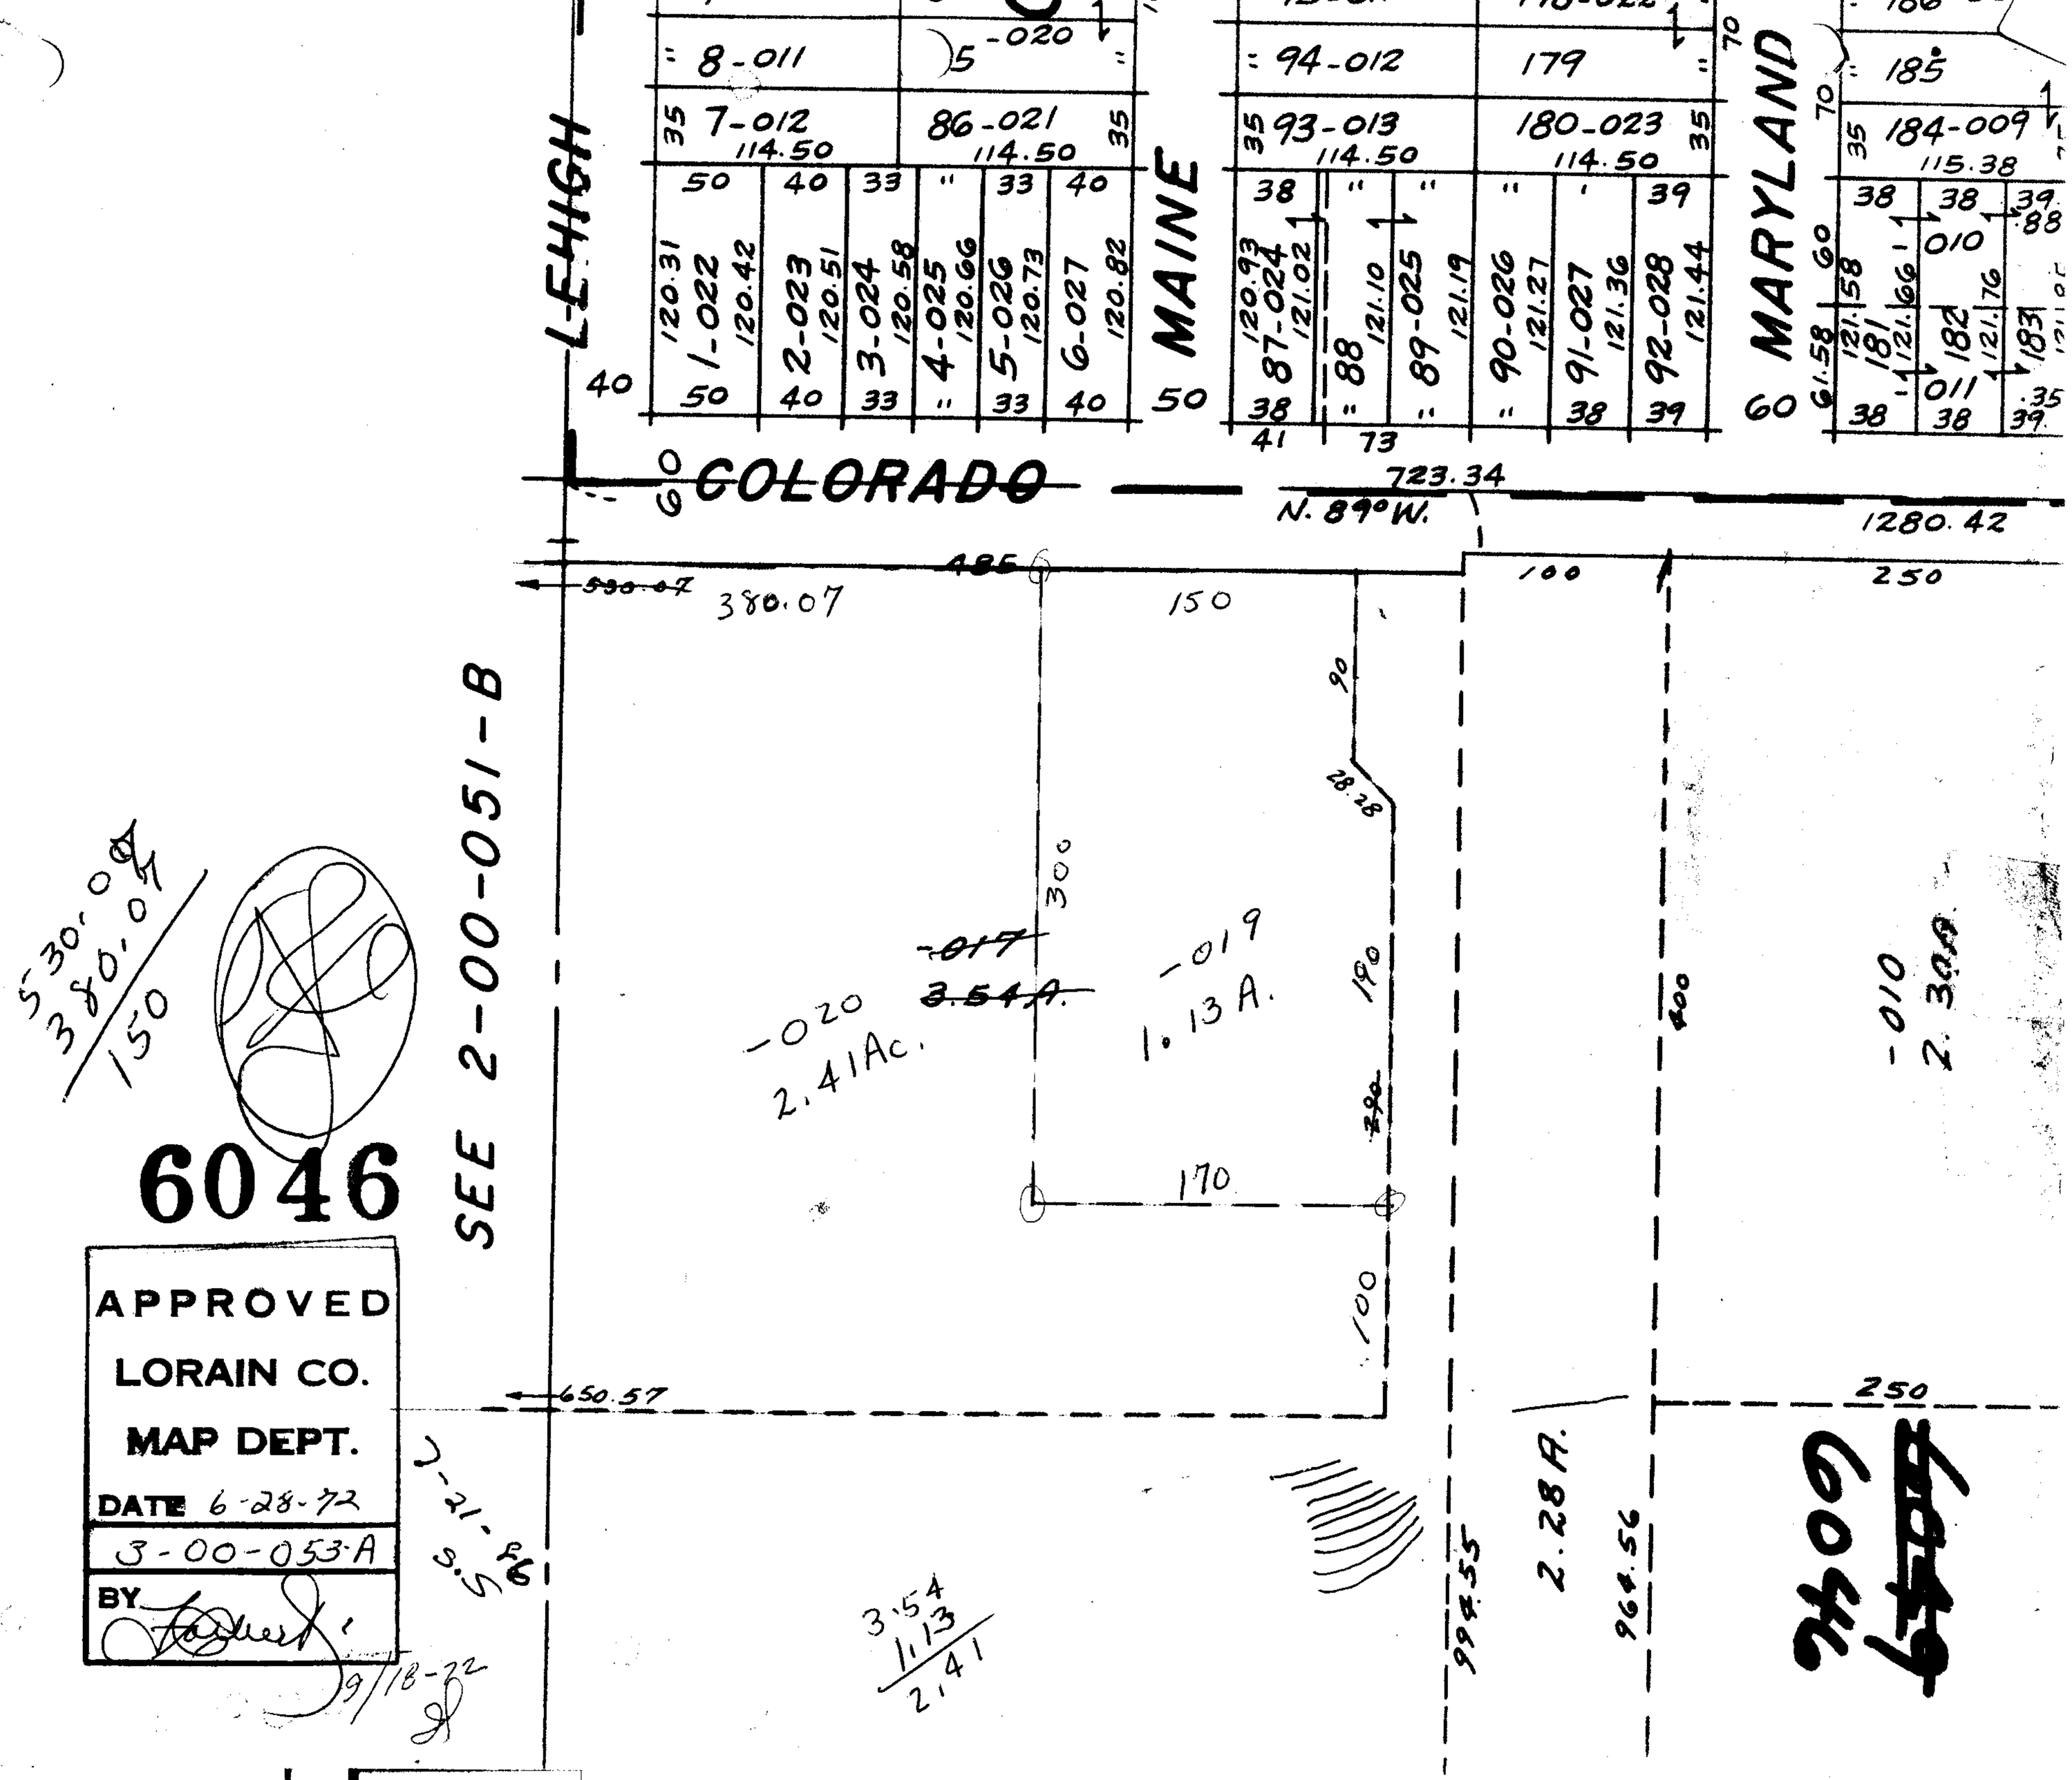

LEHIGH
MAINE
MARYLAND
COLORADO
N. 89° W.
723.34
1280.42
SEE 2-00-051-B
6046
APPROVED
LORAIN CO.
MAP DEPT.
DATE 6-28-72
3-00-053-A
BY
-020
2.41Ac.
-019
1.13 A.
-017
3.54 A.
-010
2.30A.
2.28 A.
650.57
380.07
150
100
250
994.55
964.56
3.54
1.13
2.41