



6047

APPROVED
LORAIN CO.
MAP DEPT.
DATE 6-29-70
6-79
BY *[Signature]*

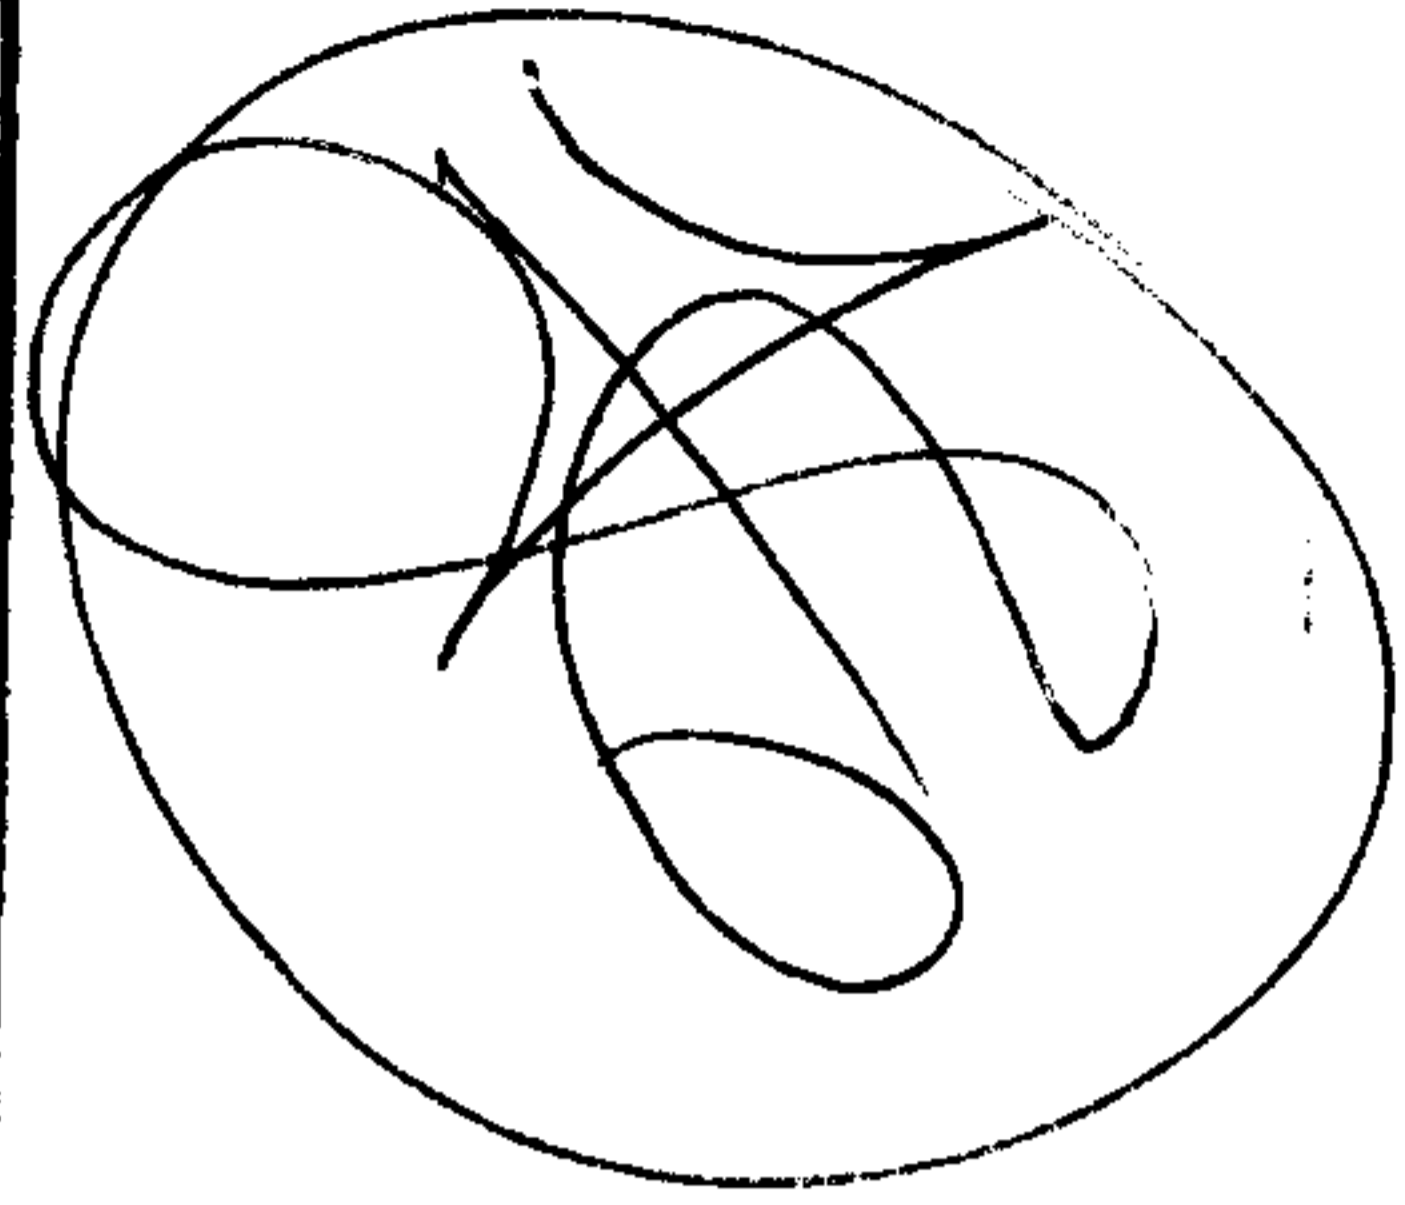

64.22
23.59
40.63

SEE 6-61

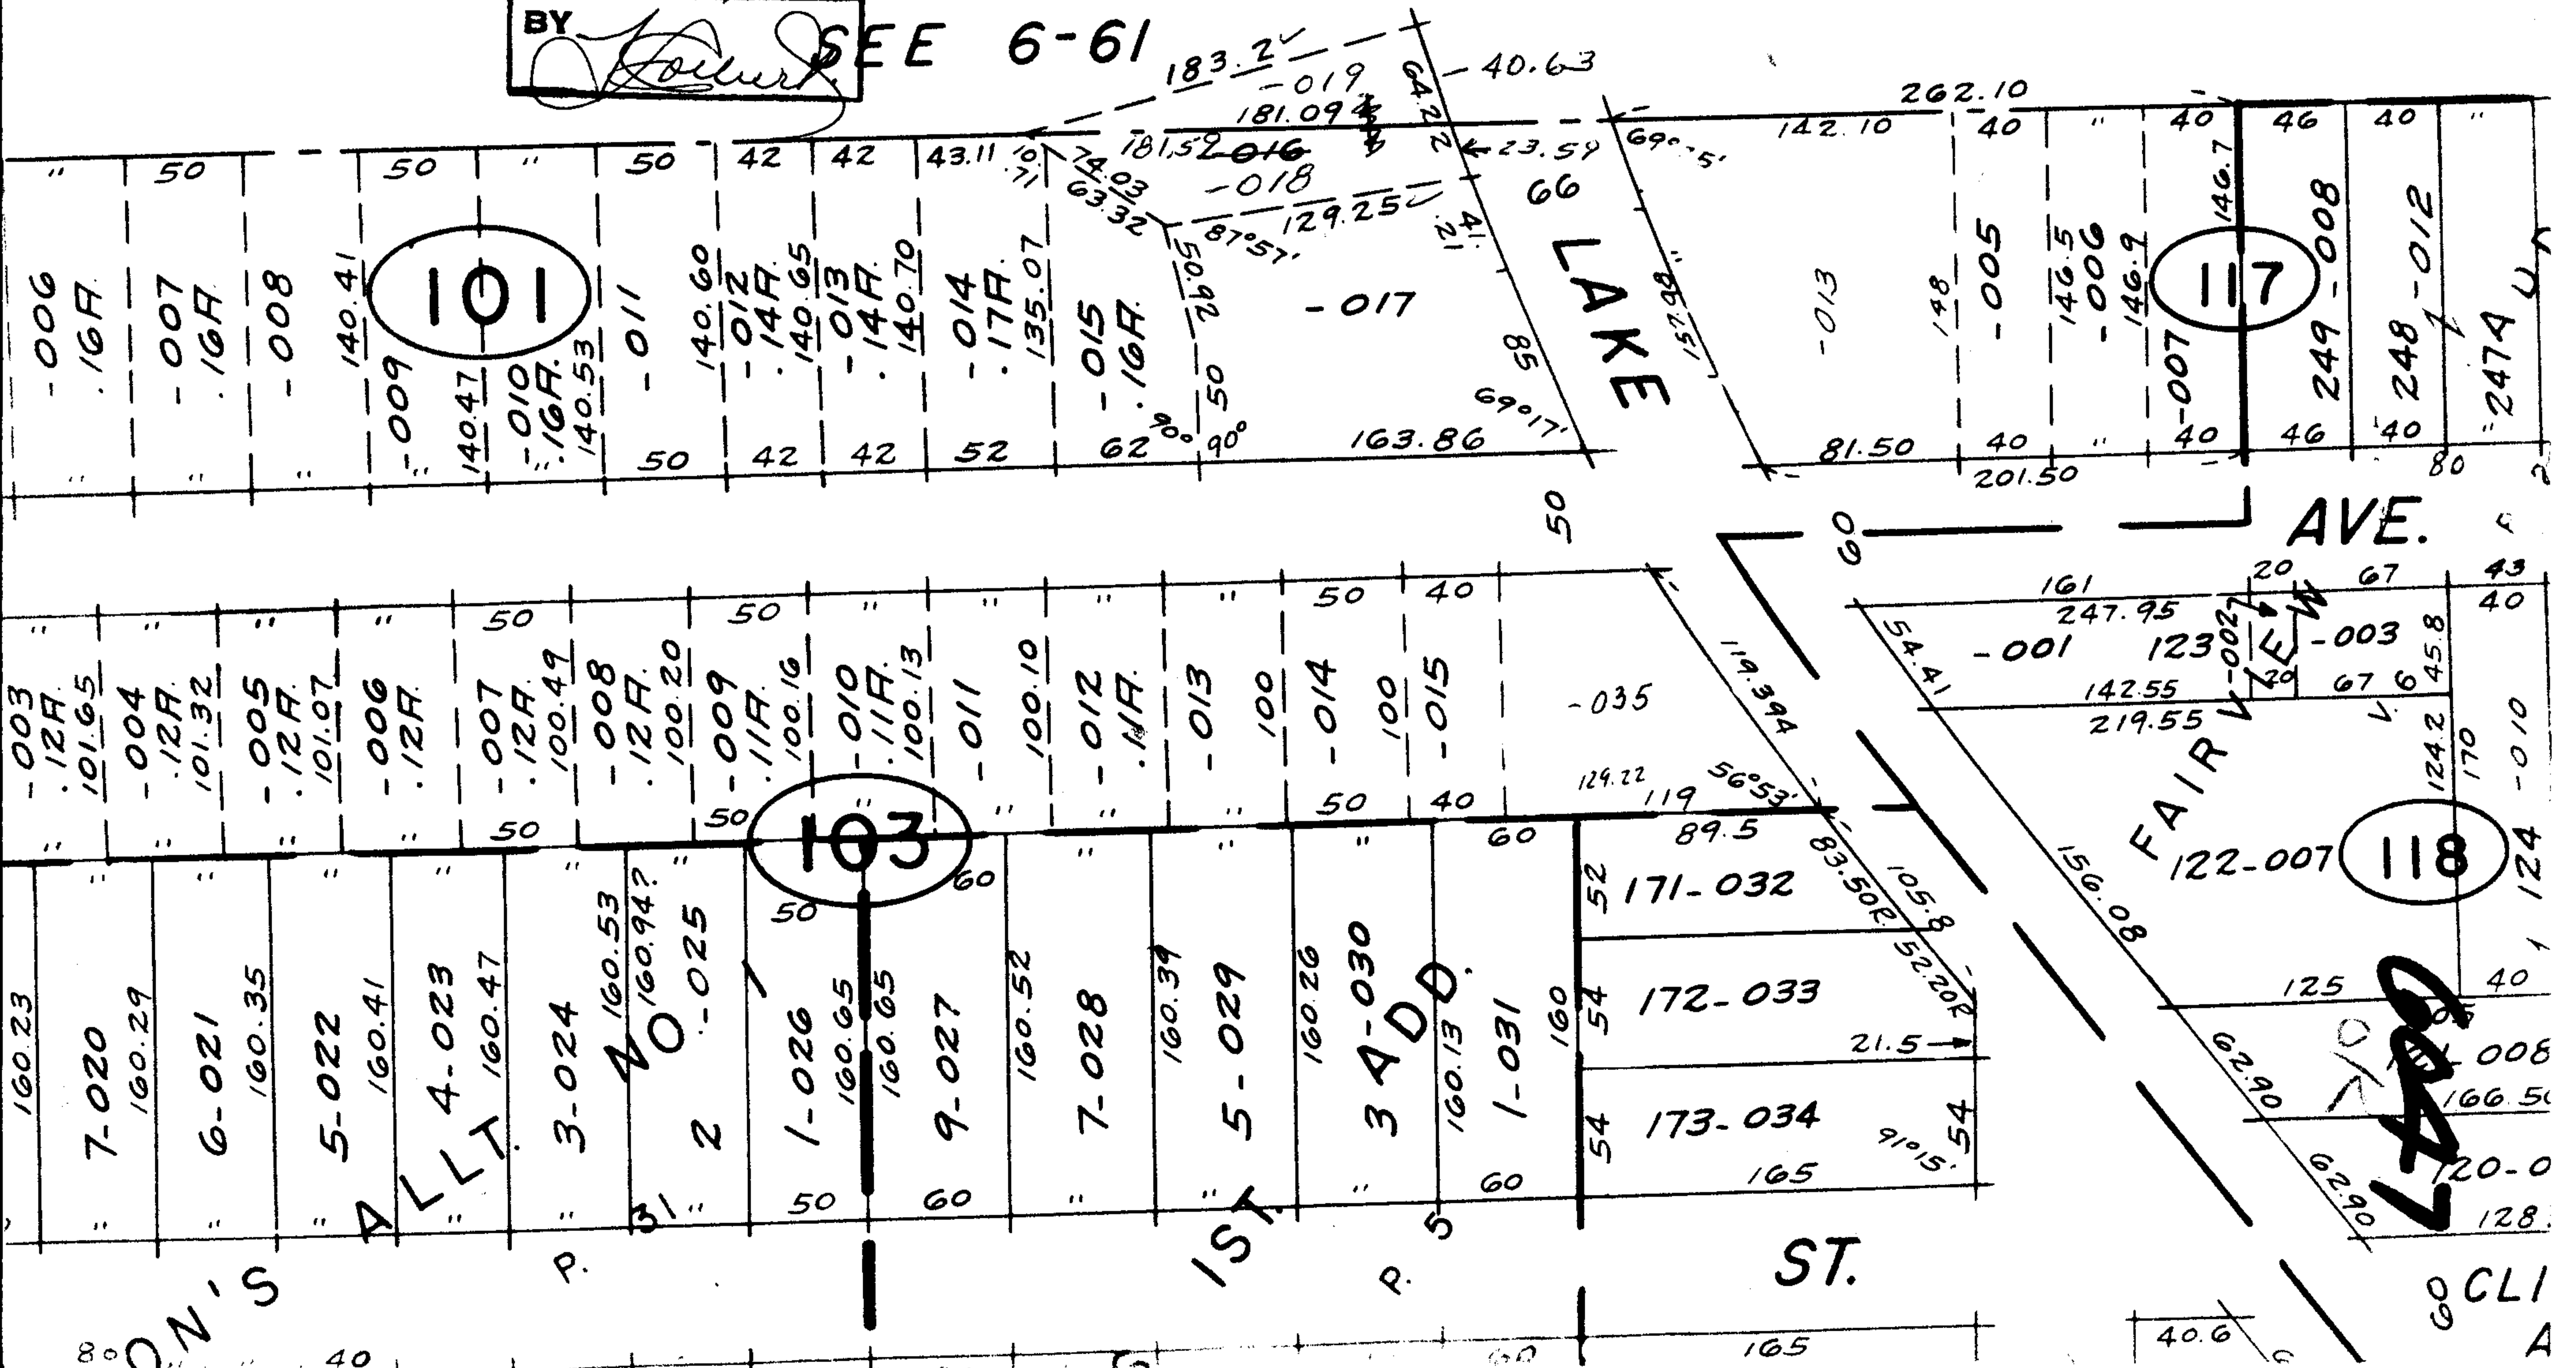

DON'S ST.

1ST ST.

ST.

AVE.

FAIRVIEW

LAKE

CLIA