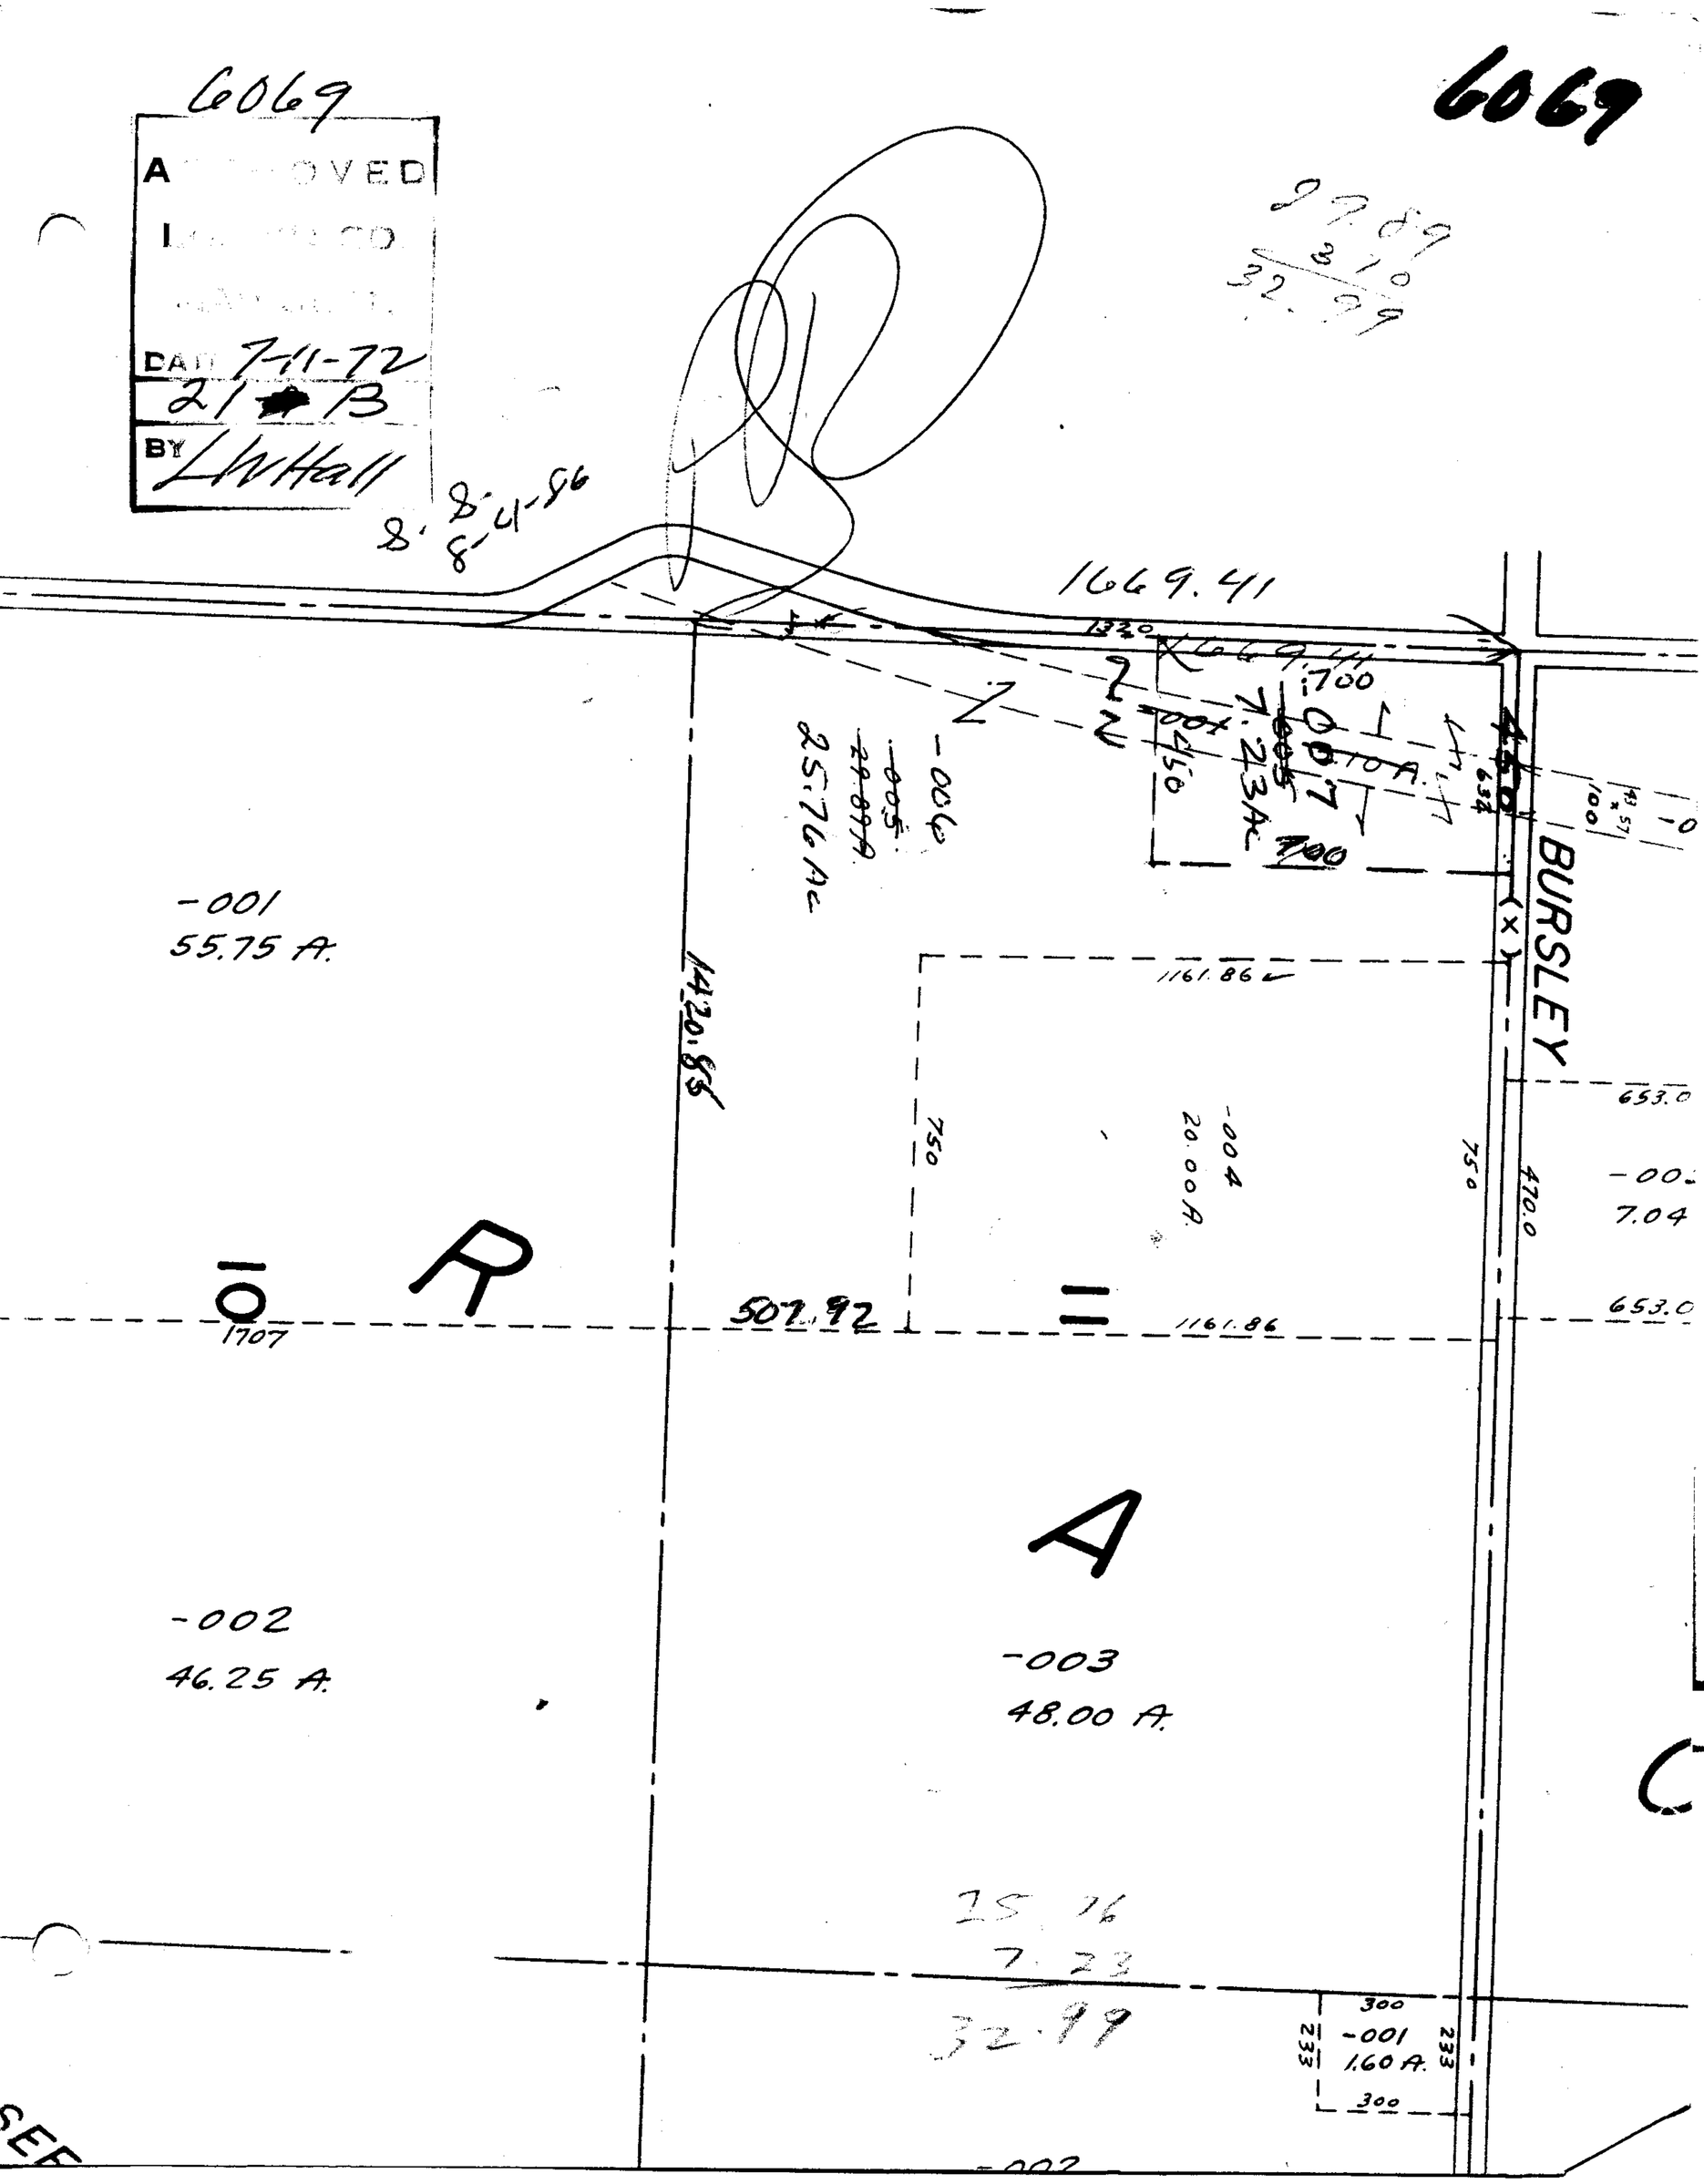
6069
6069
APPROVED
DATE 7-11-72
21 B
BY LWHall
8-8-8-4-86
1669.41
1320
700
-001
7.23 Ac
-006
25.76 Ac
-001
55.75 A.
1420.85
1161.86
750
-004
20.00 A.
750
470.0
BURSLEY
653.0
-00
7.04
653.0
R
507.92
1161.86
1707
A
-002
46.25 A.
-003
48.00 A.
25.76
7.23
32.99
300
-001
1.60 A.
233
233
300
-002