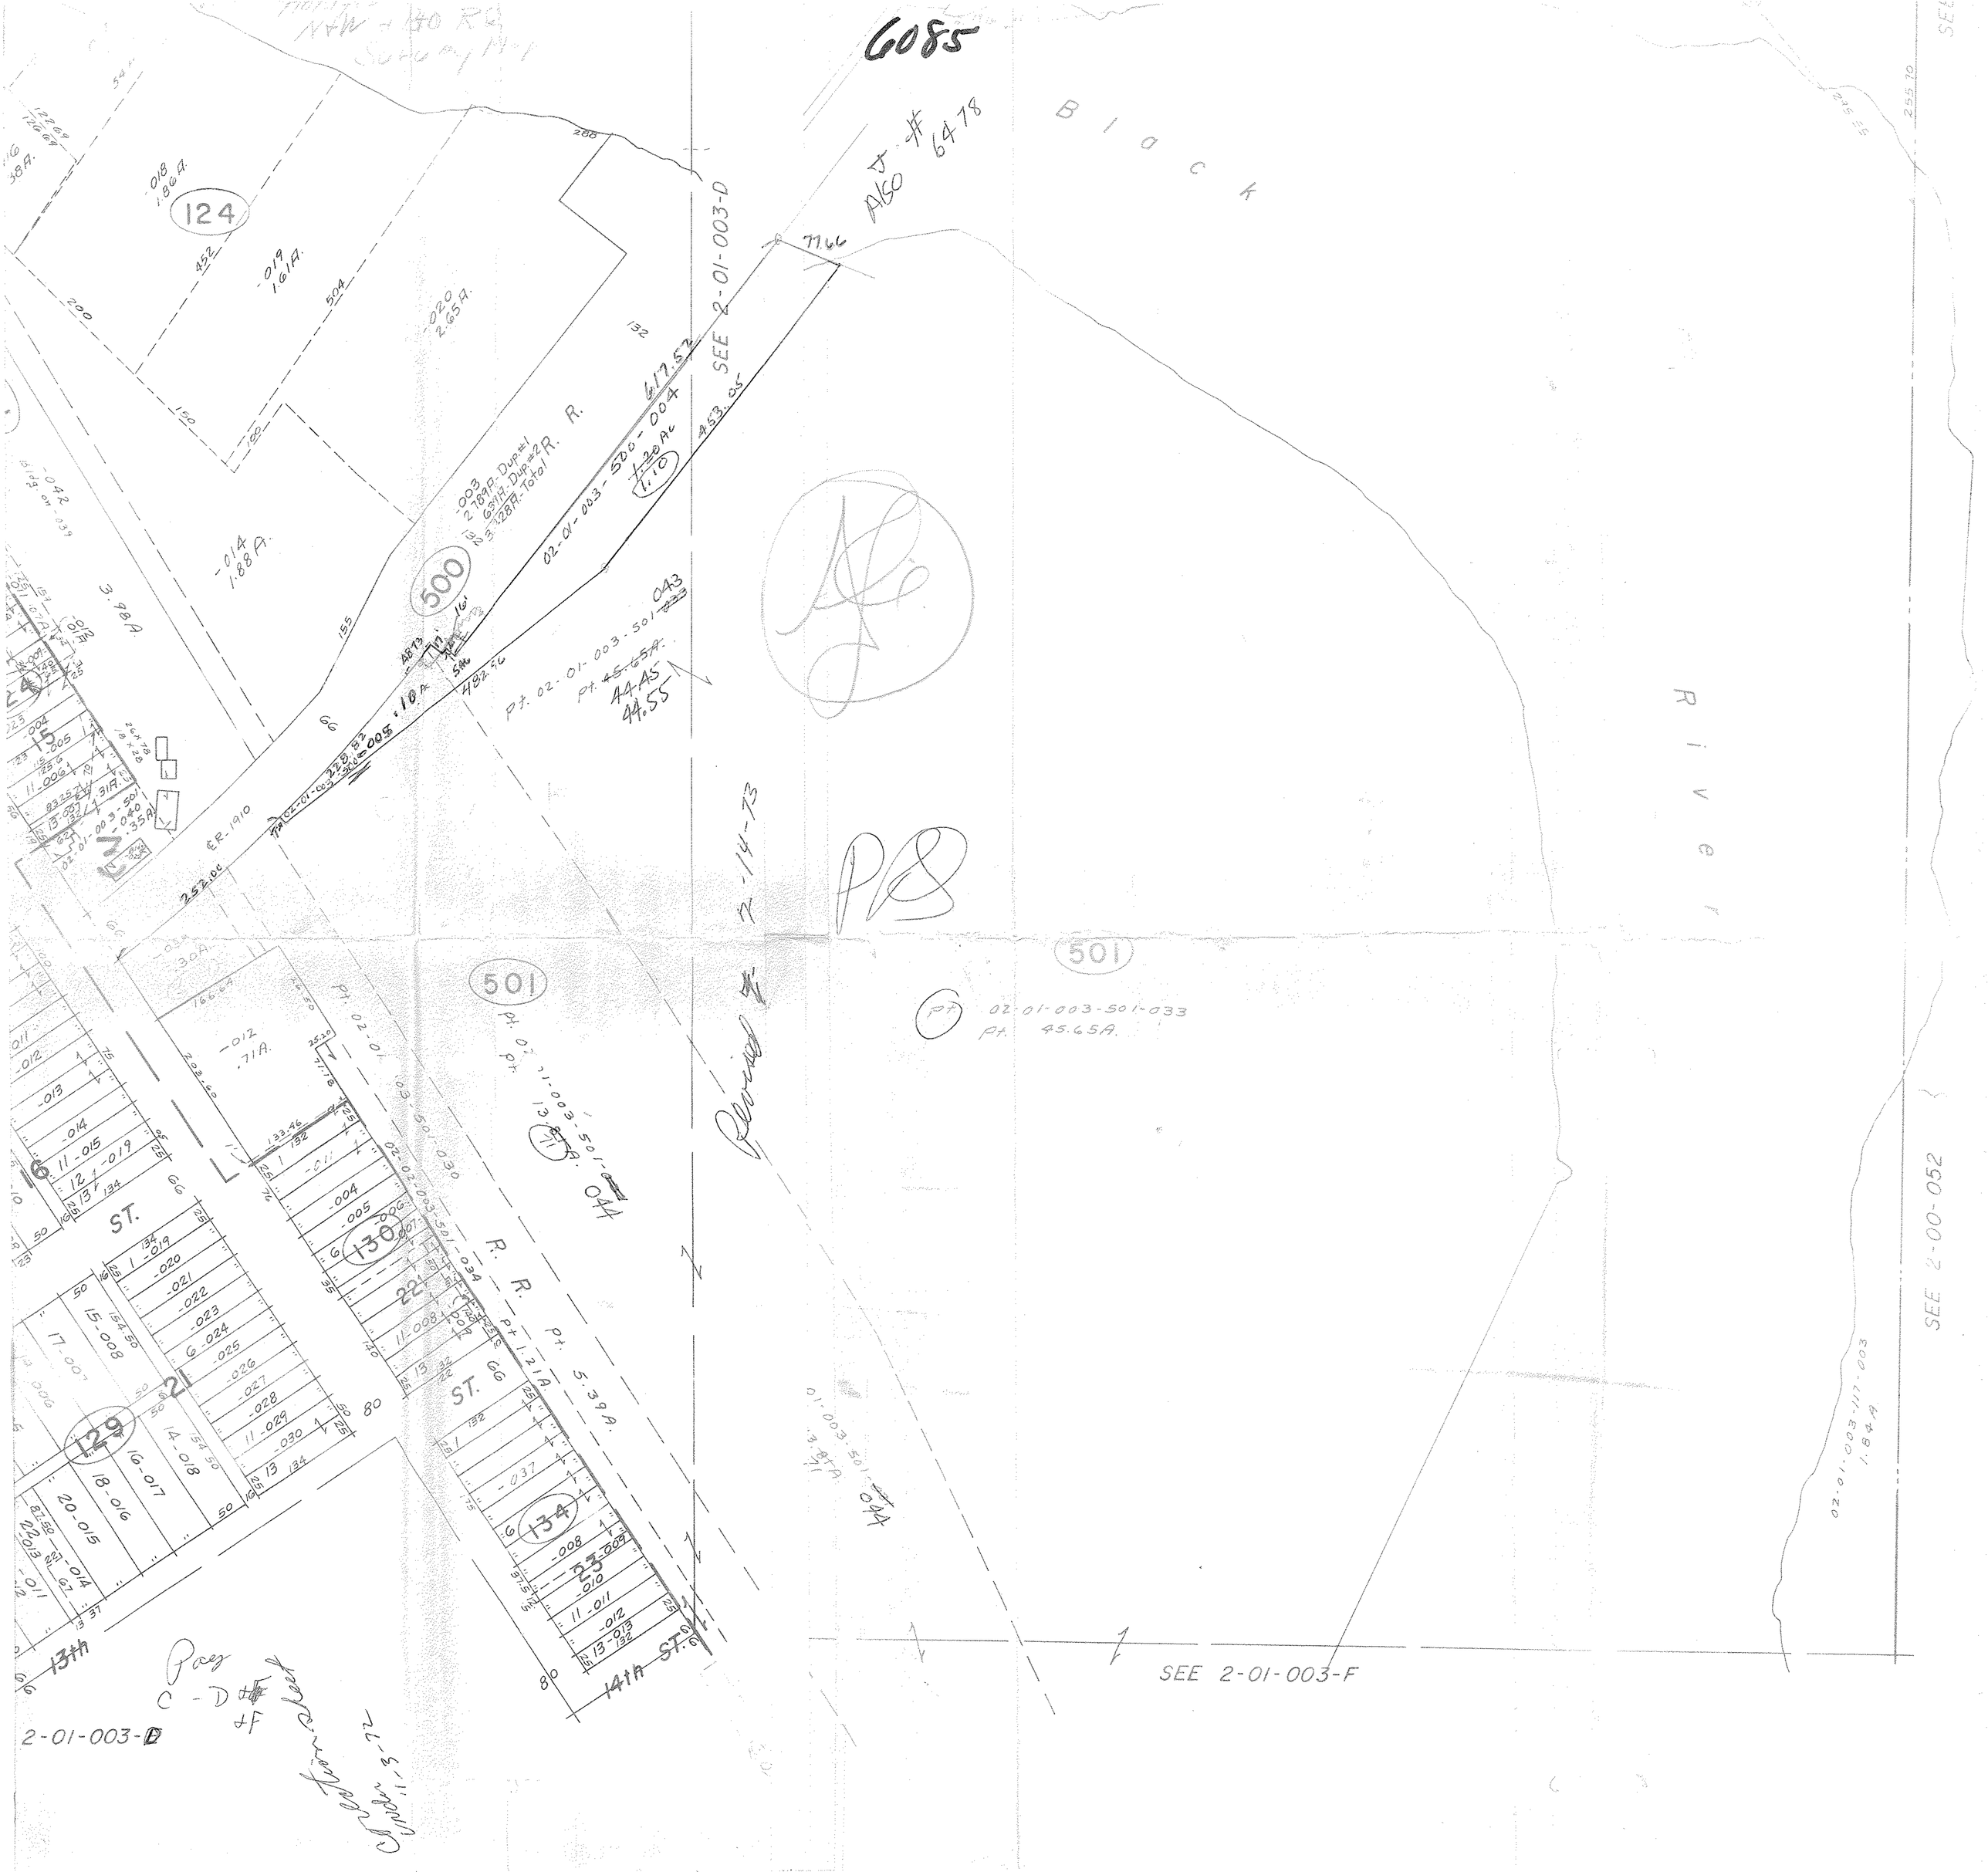
6085
Black
River
SEE 2-01-003-D
SEE 2-01-003-F
SEE 2-00-052
124
500
501
129
130
134
13th
14th ST.
R. R.
Pt. 5.39A.
Pt. 02-01-003-501-033
Pt. 45.65A.
Pt. 02-01-003-501-043
Pt. 44.45
44.55
Revised 2-14-73
Also # 6478
Pay C-D & F
Creation sheet
Under 1-3-72