


245.25
 24.42
 269.67

279.51
 269.67
 9.84

279.84
 269.67
 10.17

6099

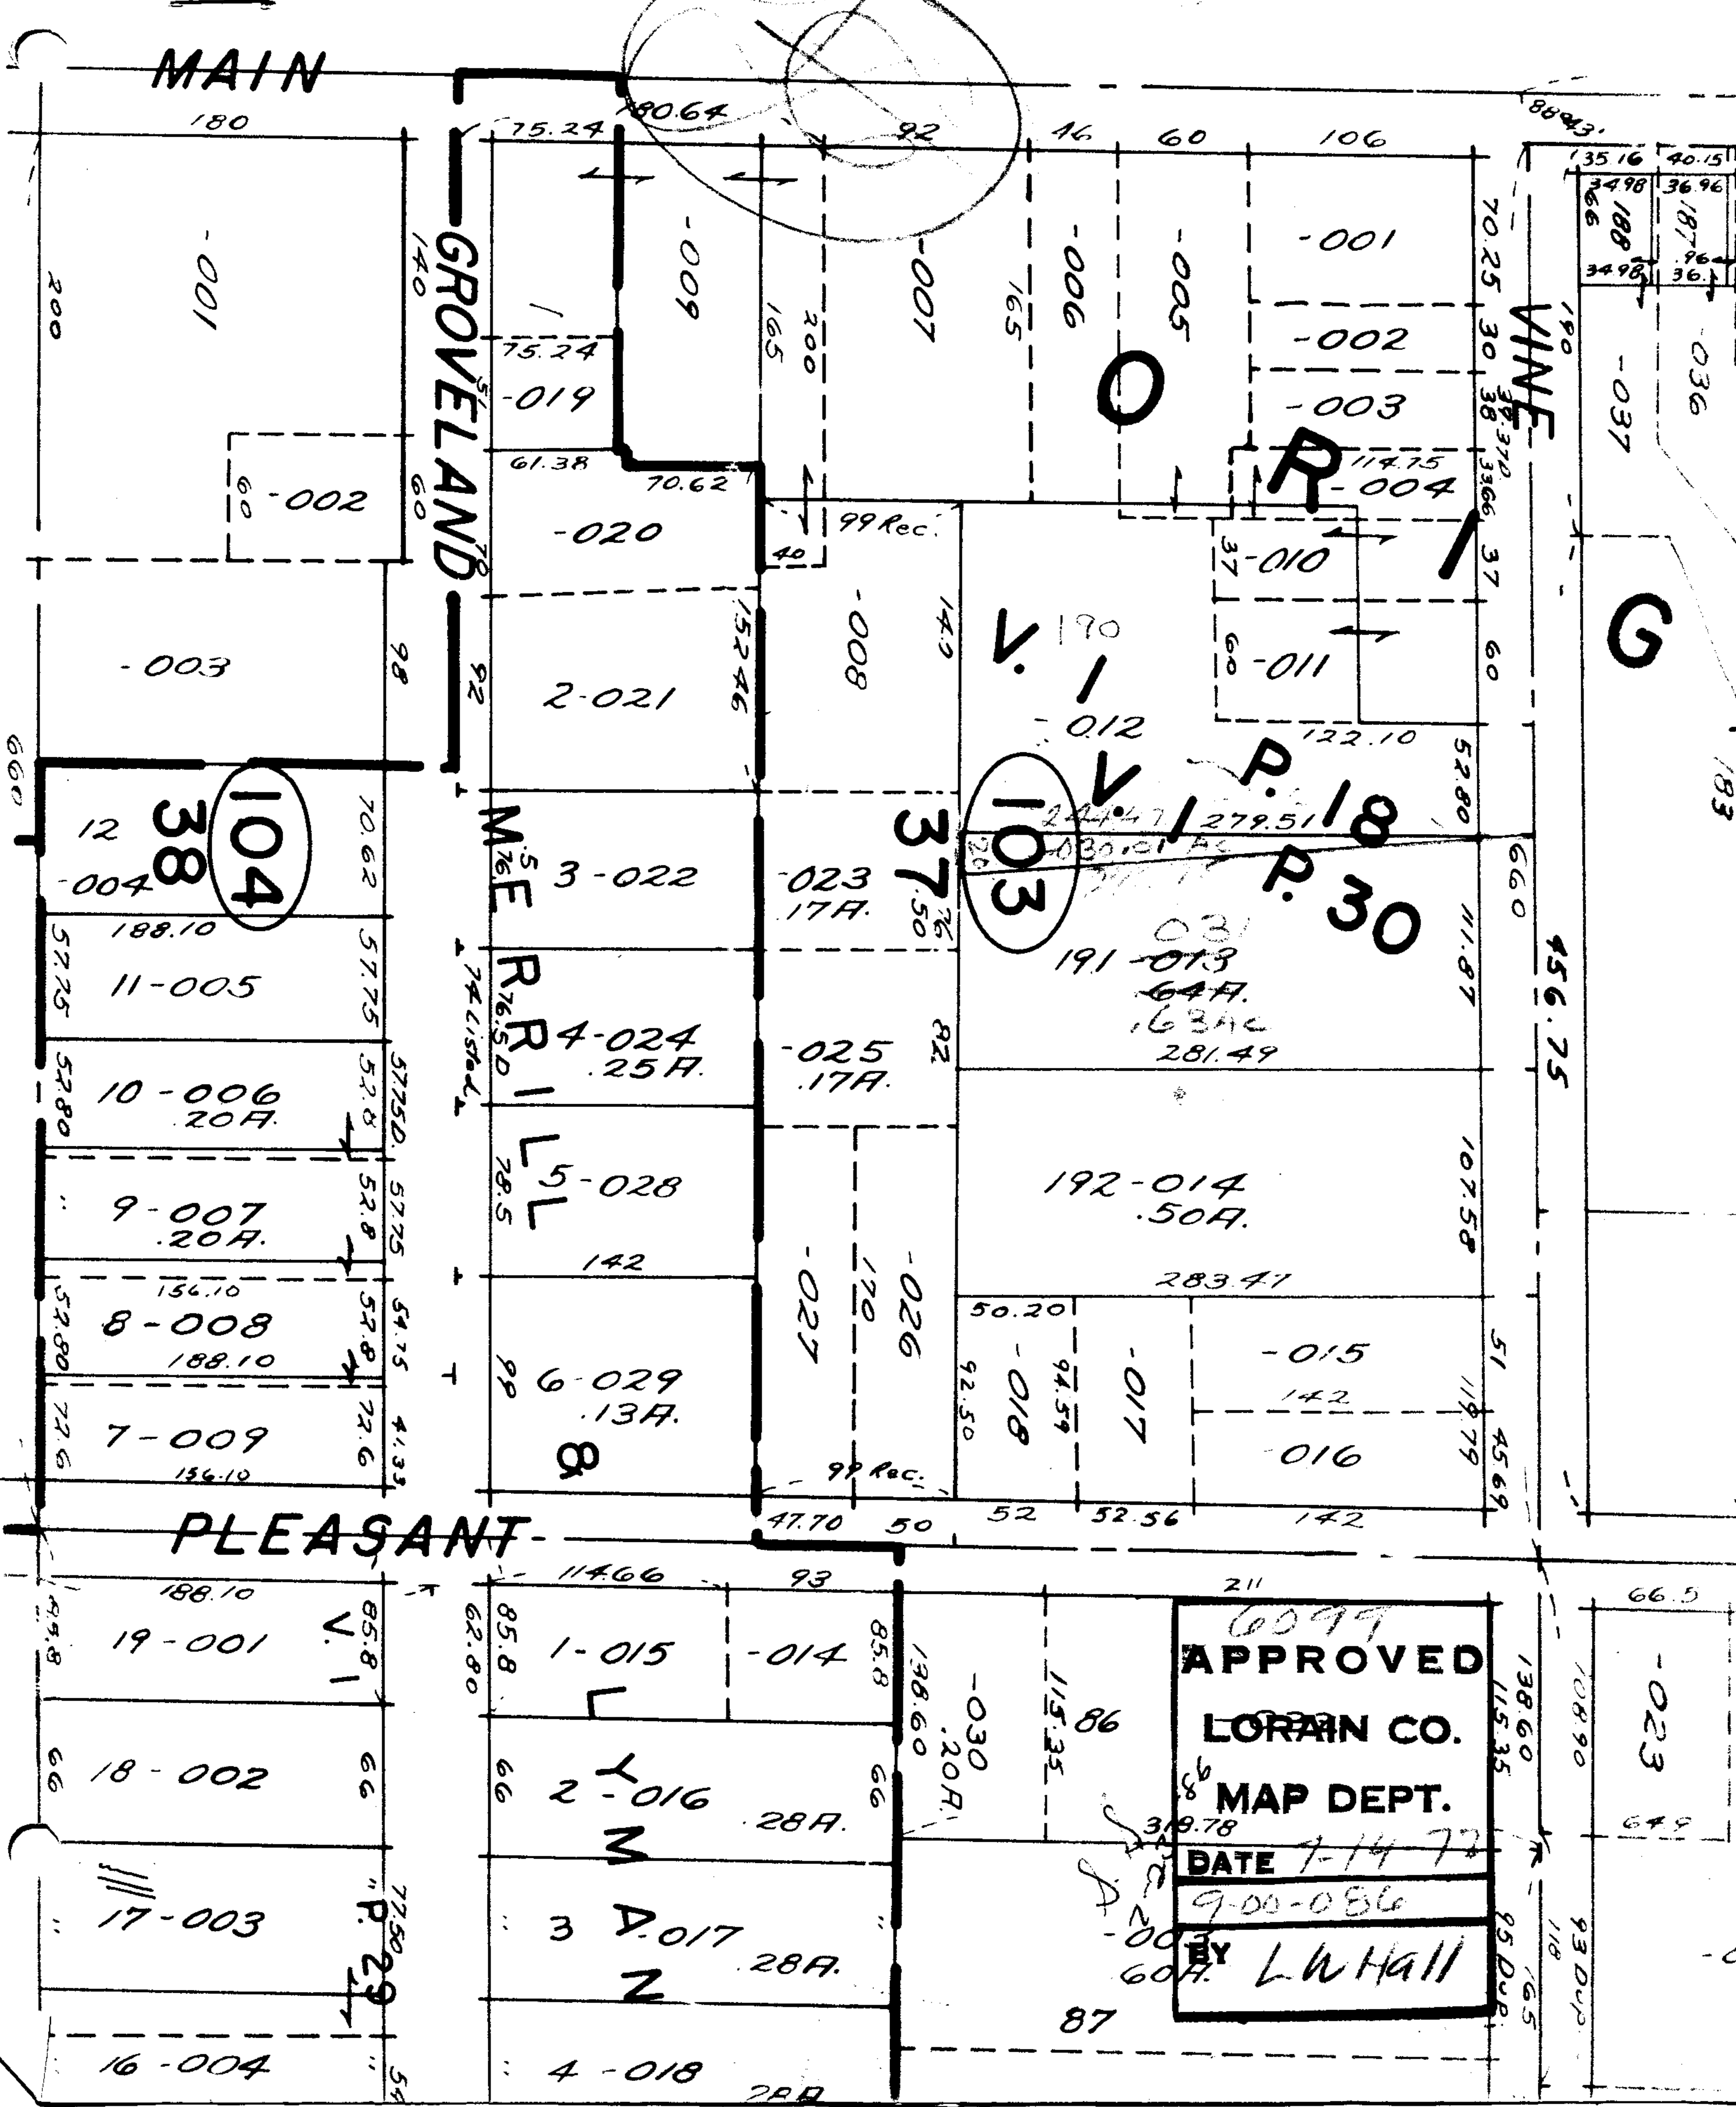

6099
APPROVED
LORAIN CO.
MAP DEPT.
 DATE 7-14-77
 9-00-056
 BY L.W. Hall

SFF 9-00-096-A