
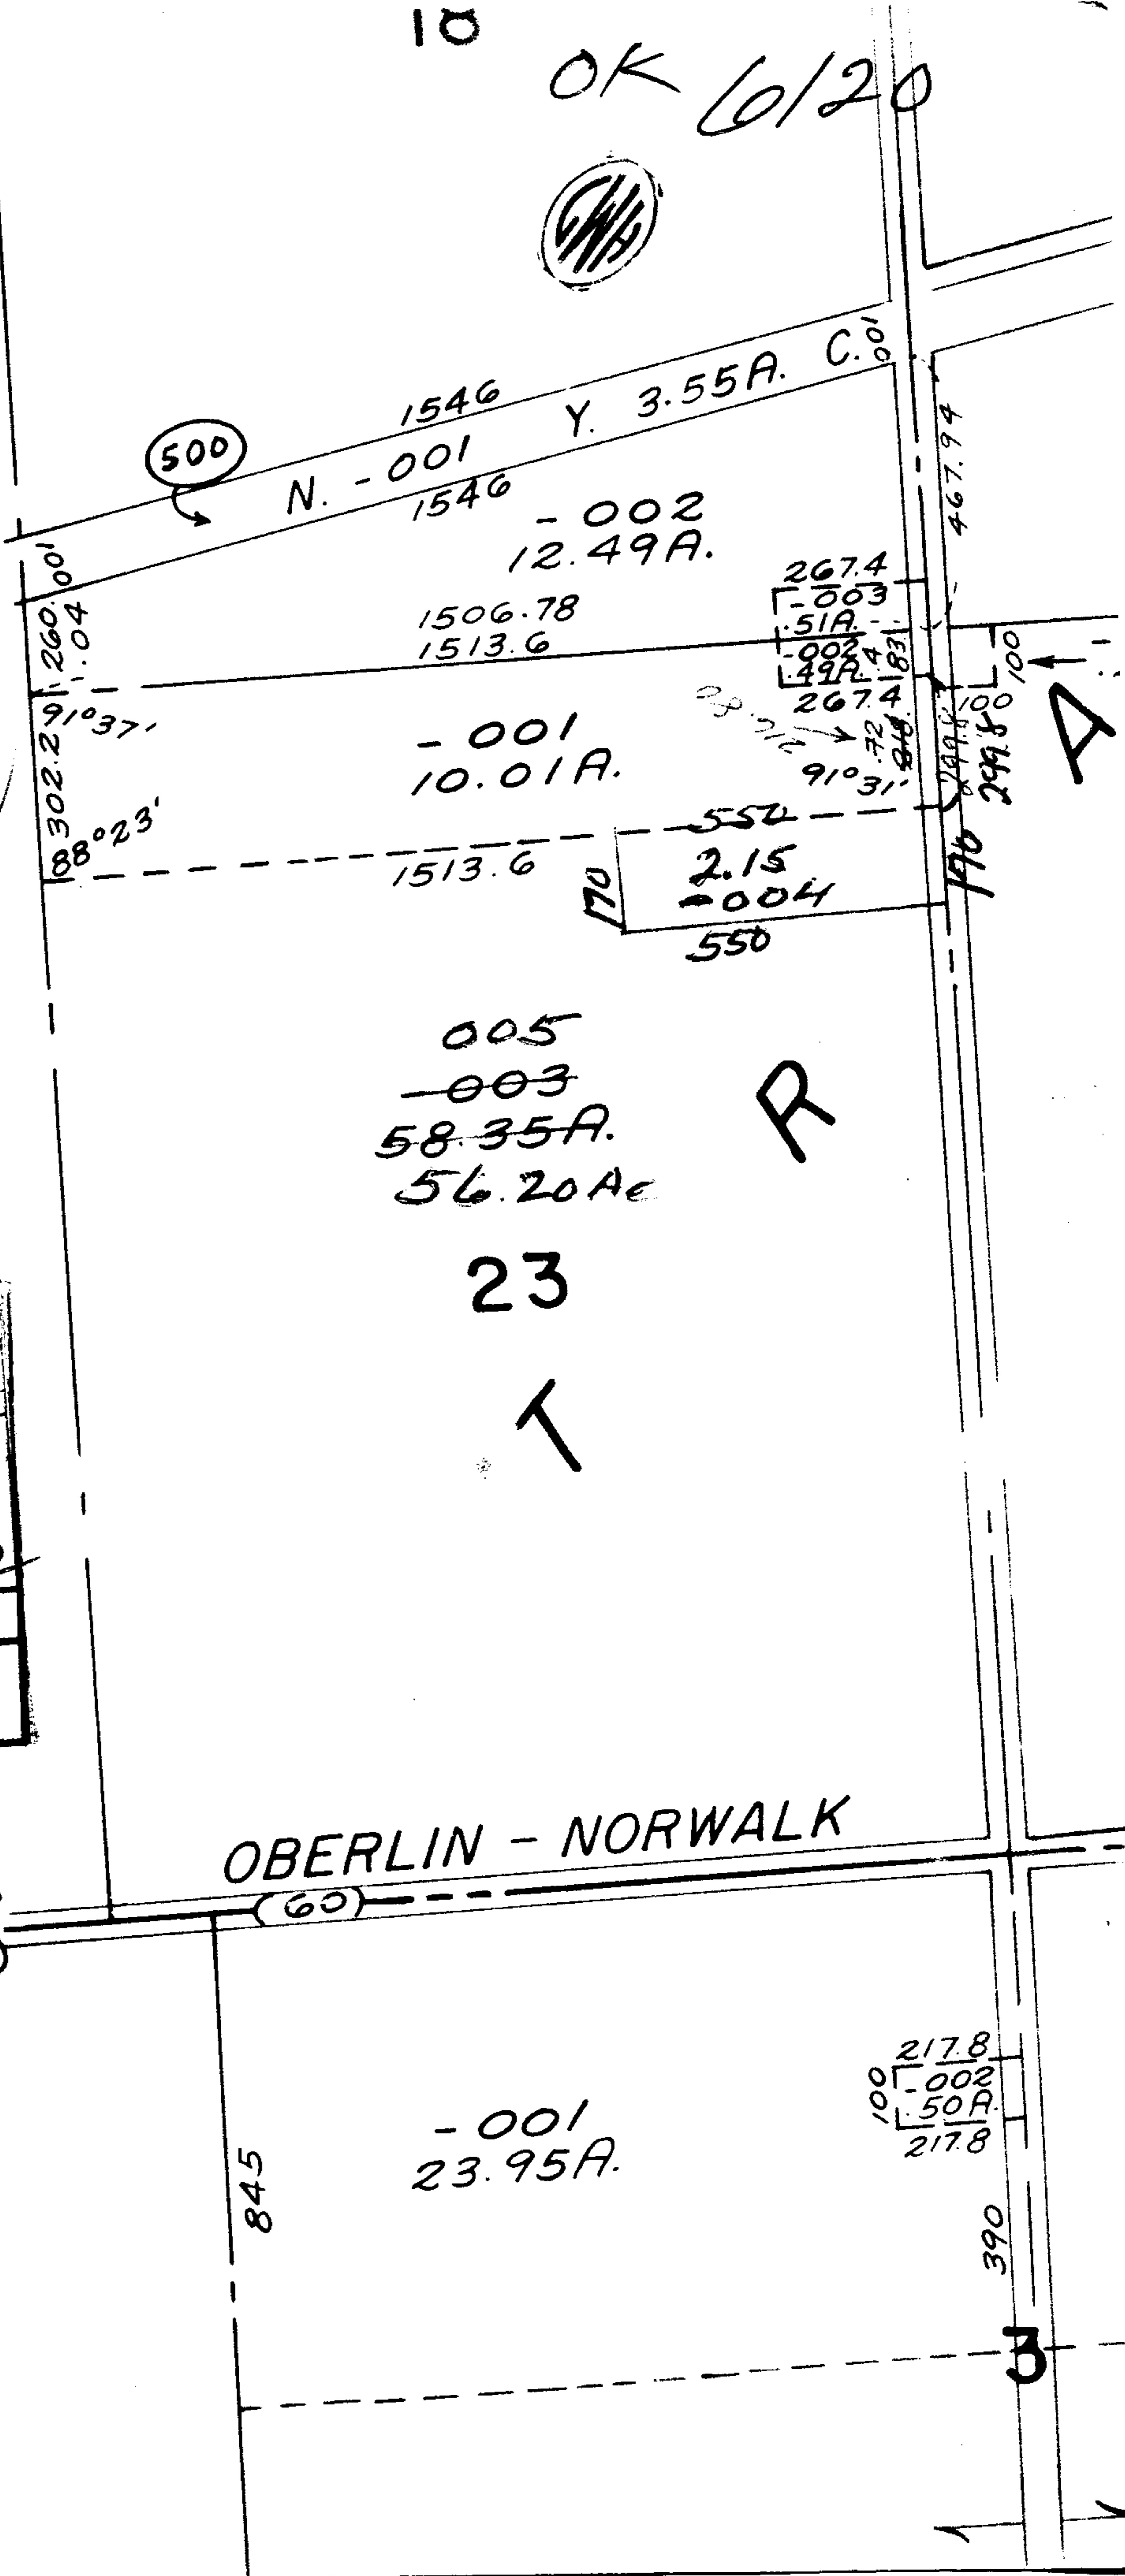


13B

10

OK 6/20

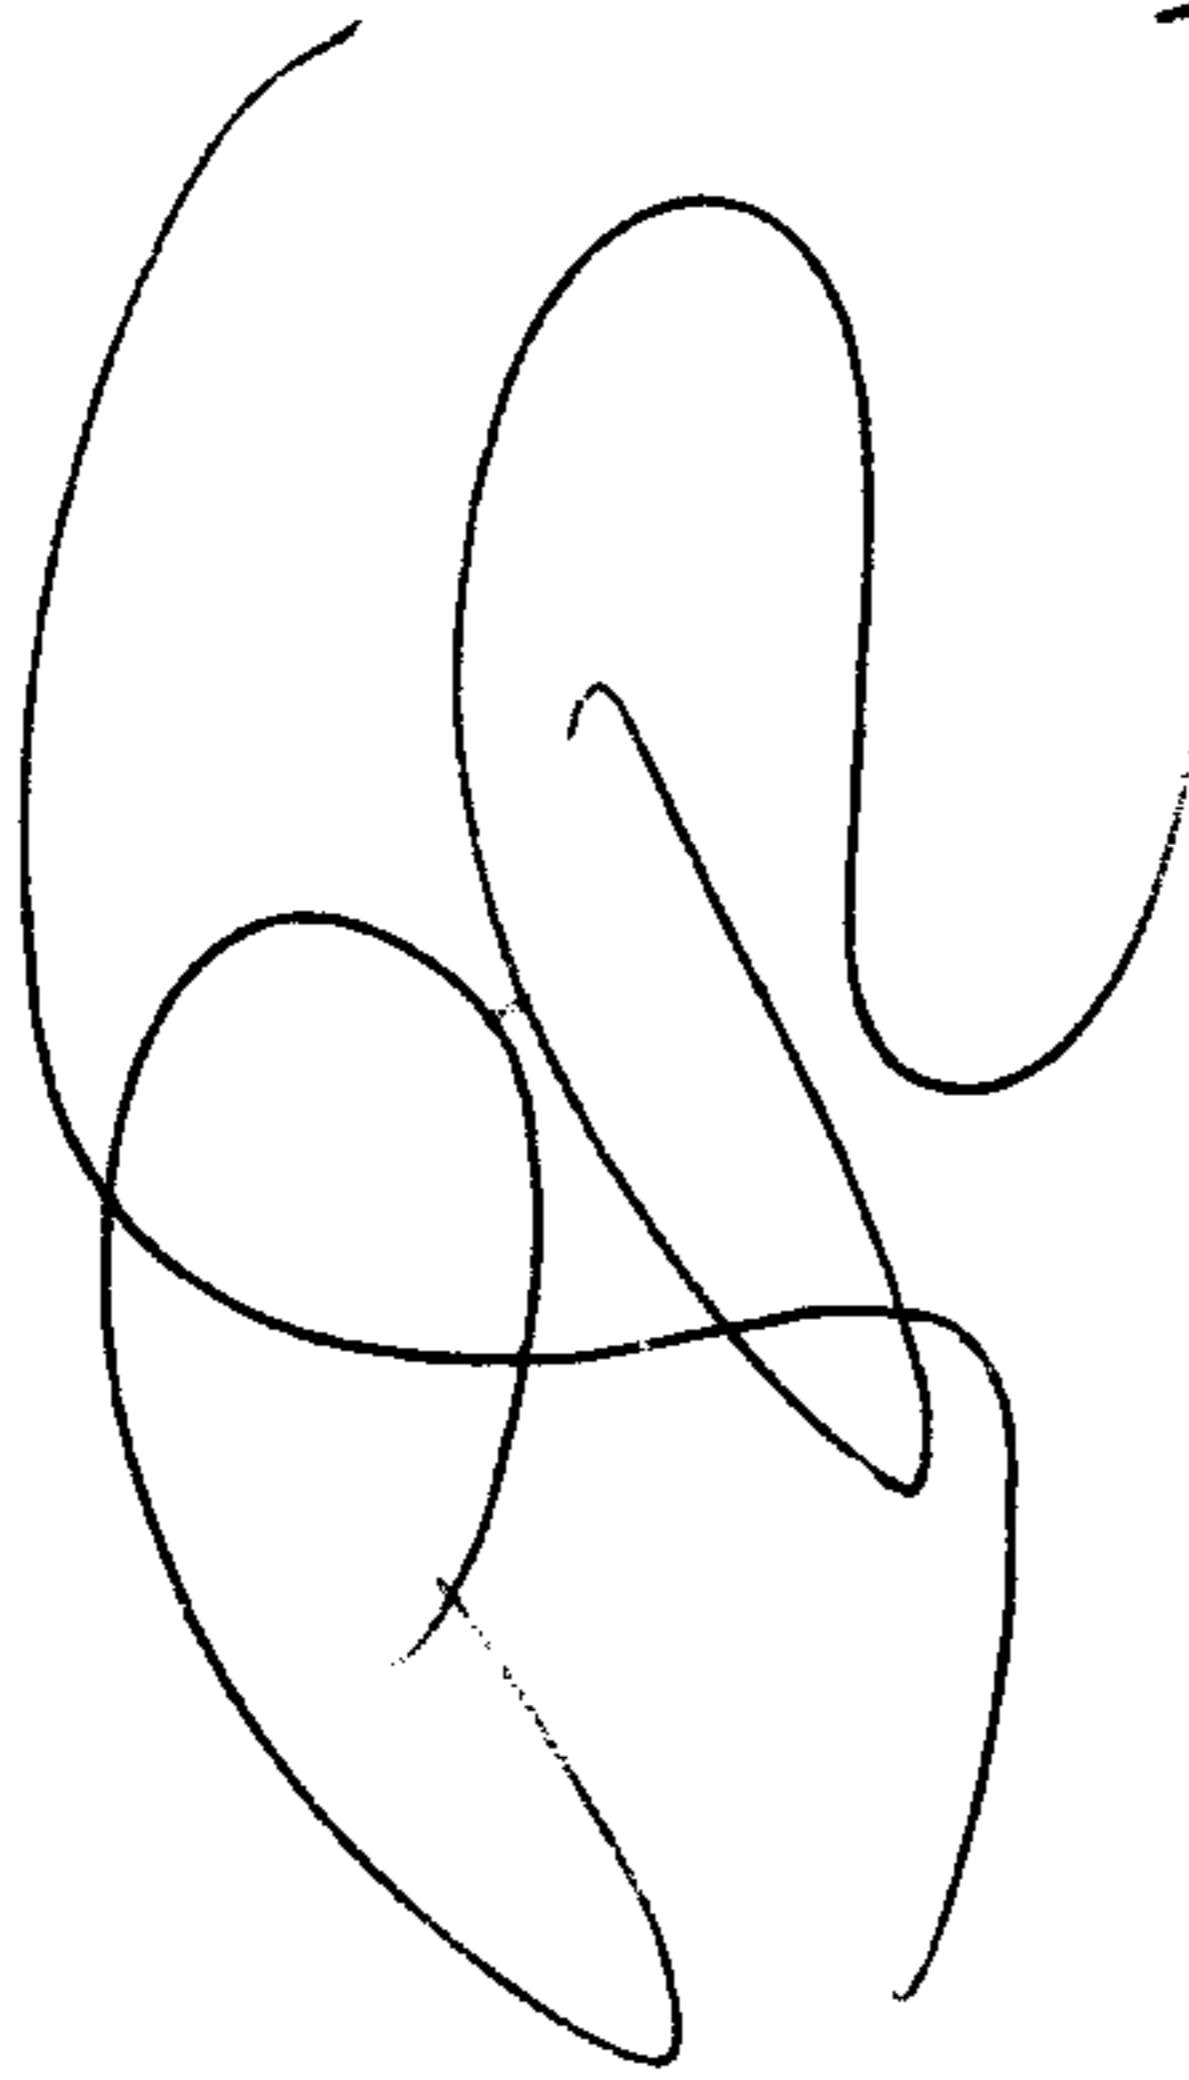

6/20

7-28-86 L.K.

APPROVE

LORAIN

MAP DEPT.

DATE 7-19-72

13B

BY L.W. Hall

OK 6/20

13B