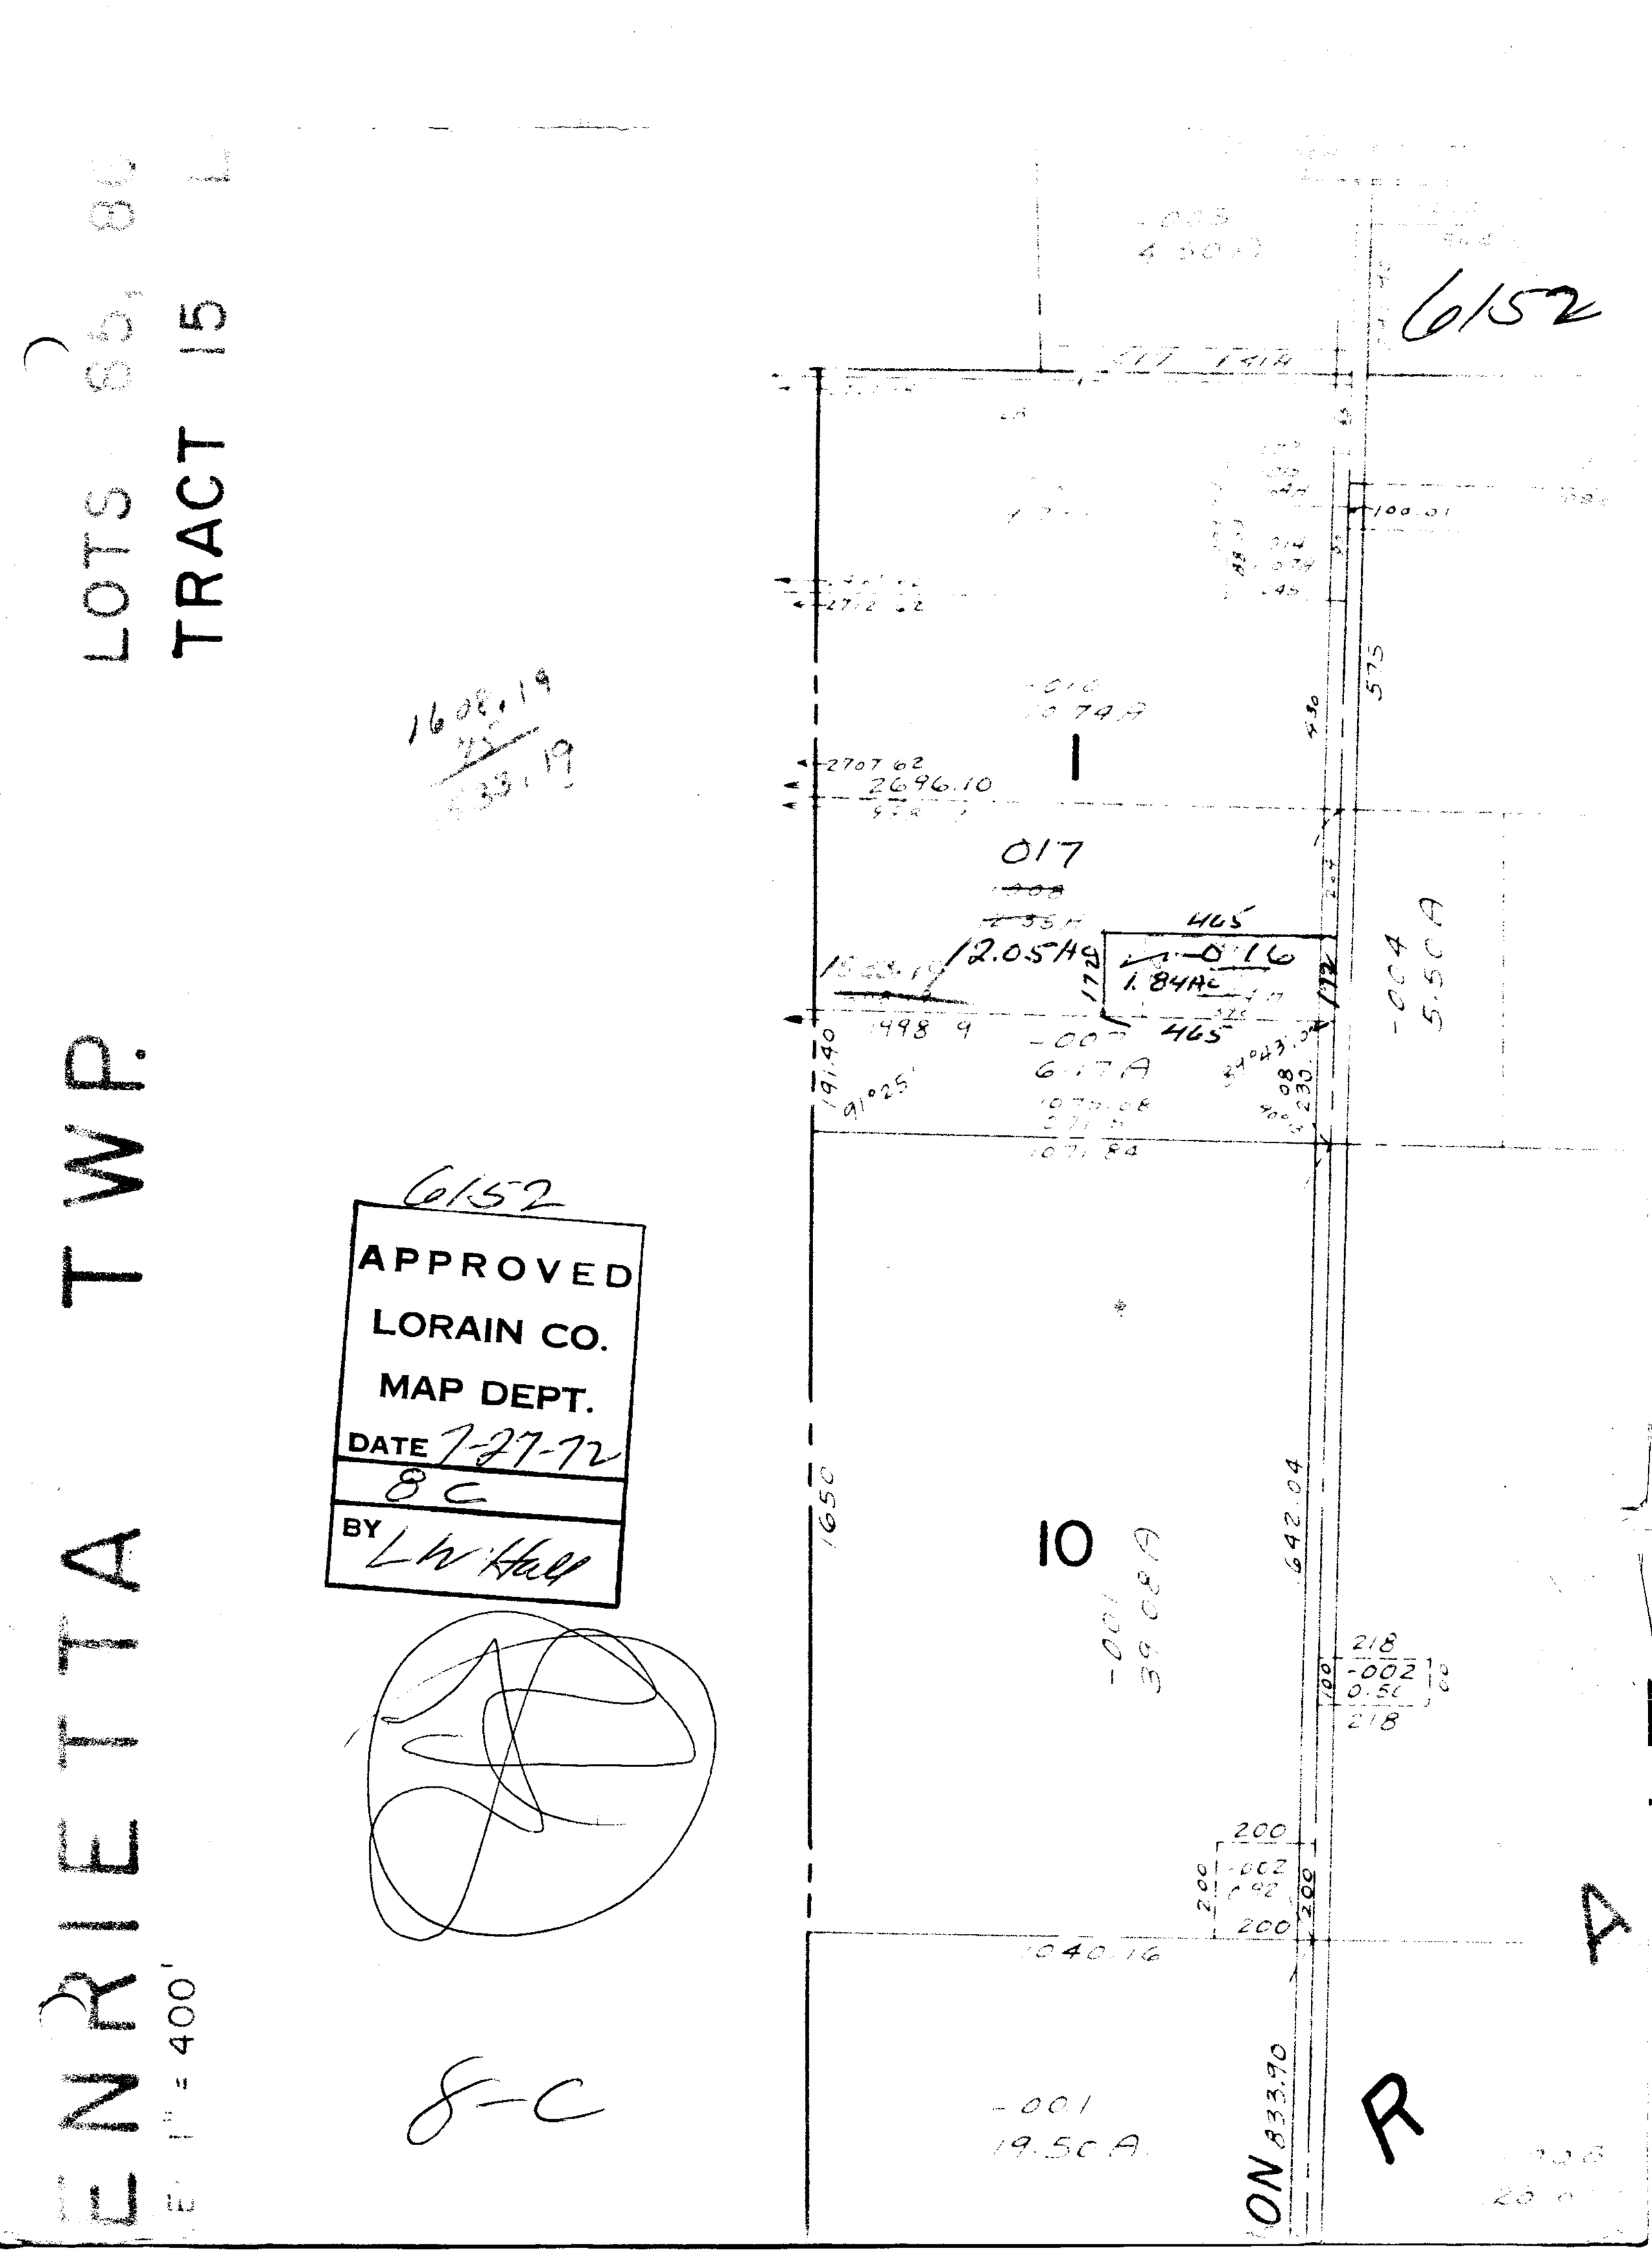

LOTS 85, 86
TRACT 15
TWP.
ENRIETTA
1" = 400'
6152
APPROVED
LORAIN CO.
MAP DEPT.
DATE 7-27-72
8 C
BY L W Hall
8-C
1608.19
2696.10
017
12.05 Ac
1.84 Ac
465
-004
5.50 A
-007
6.17 A
1650
10
-001
39.08 A
642.04
218
-002
0.56
200
-002
0.92
1040.16
-001
19.50 A
833.90
575
430
100.01