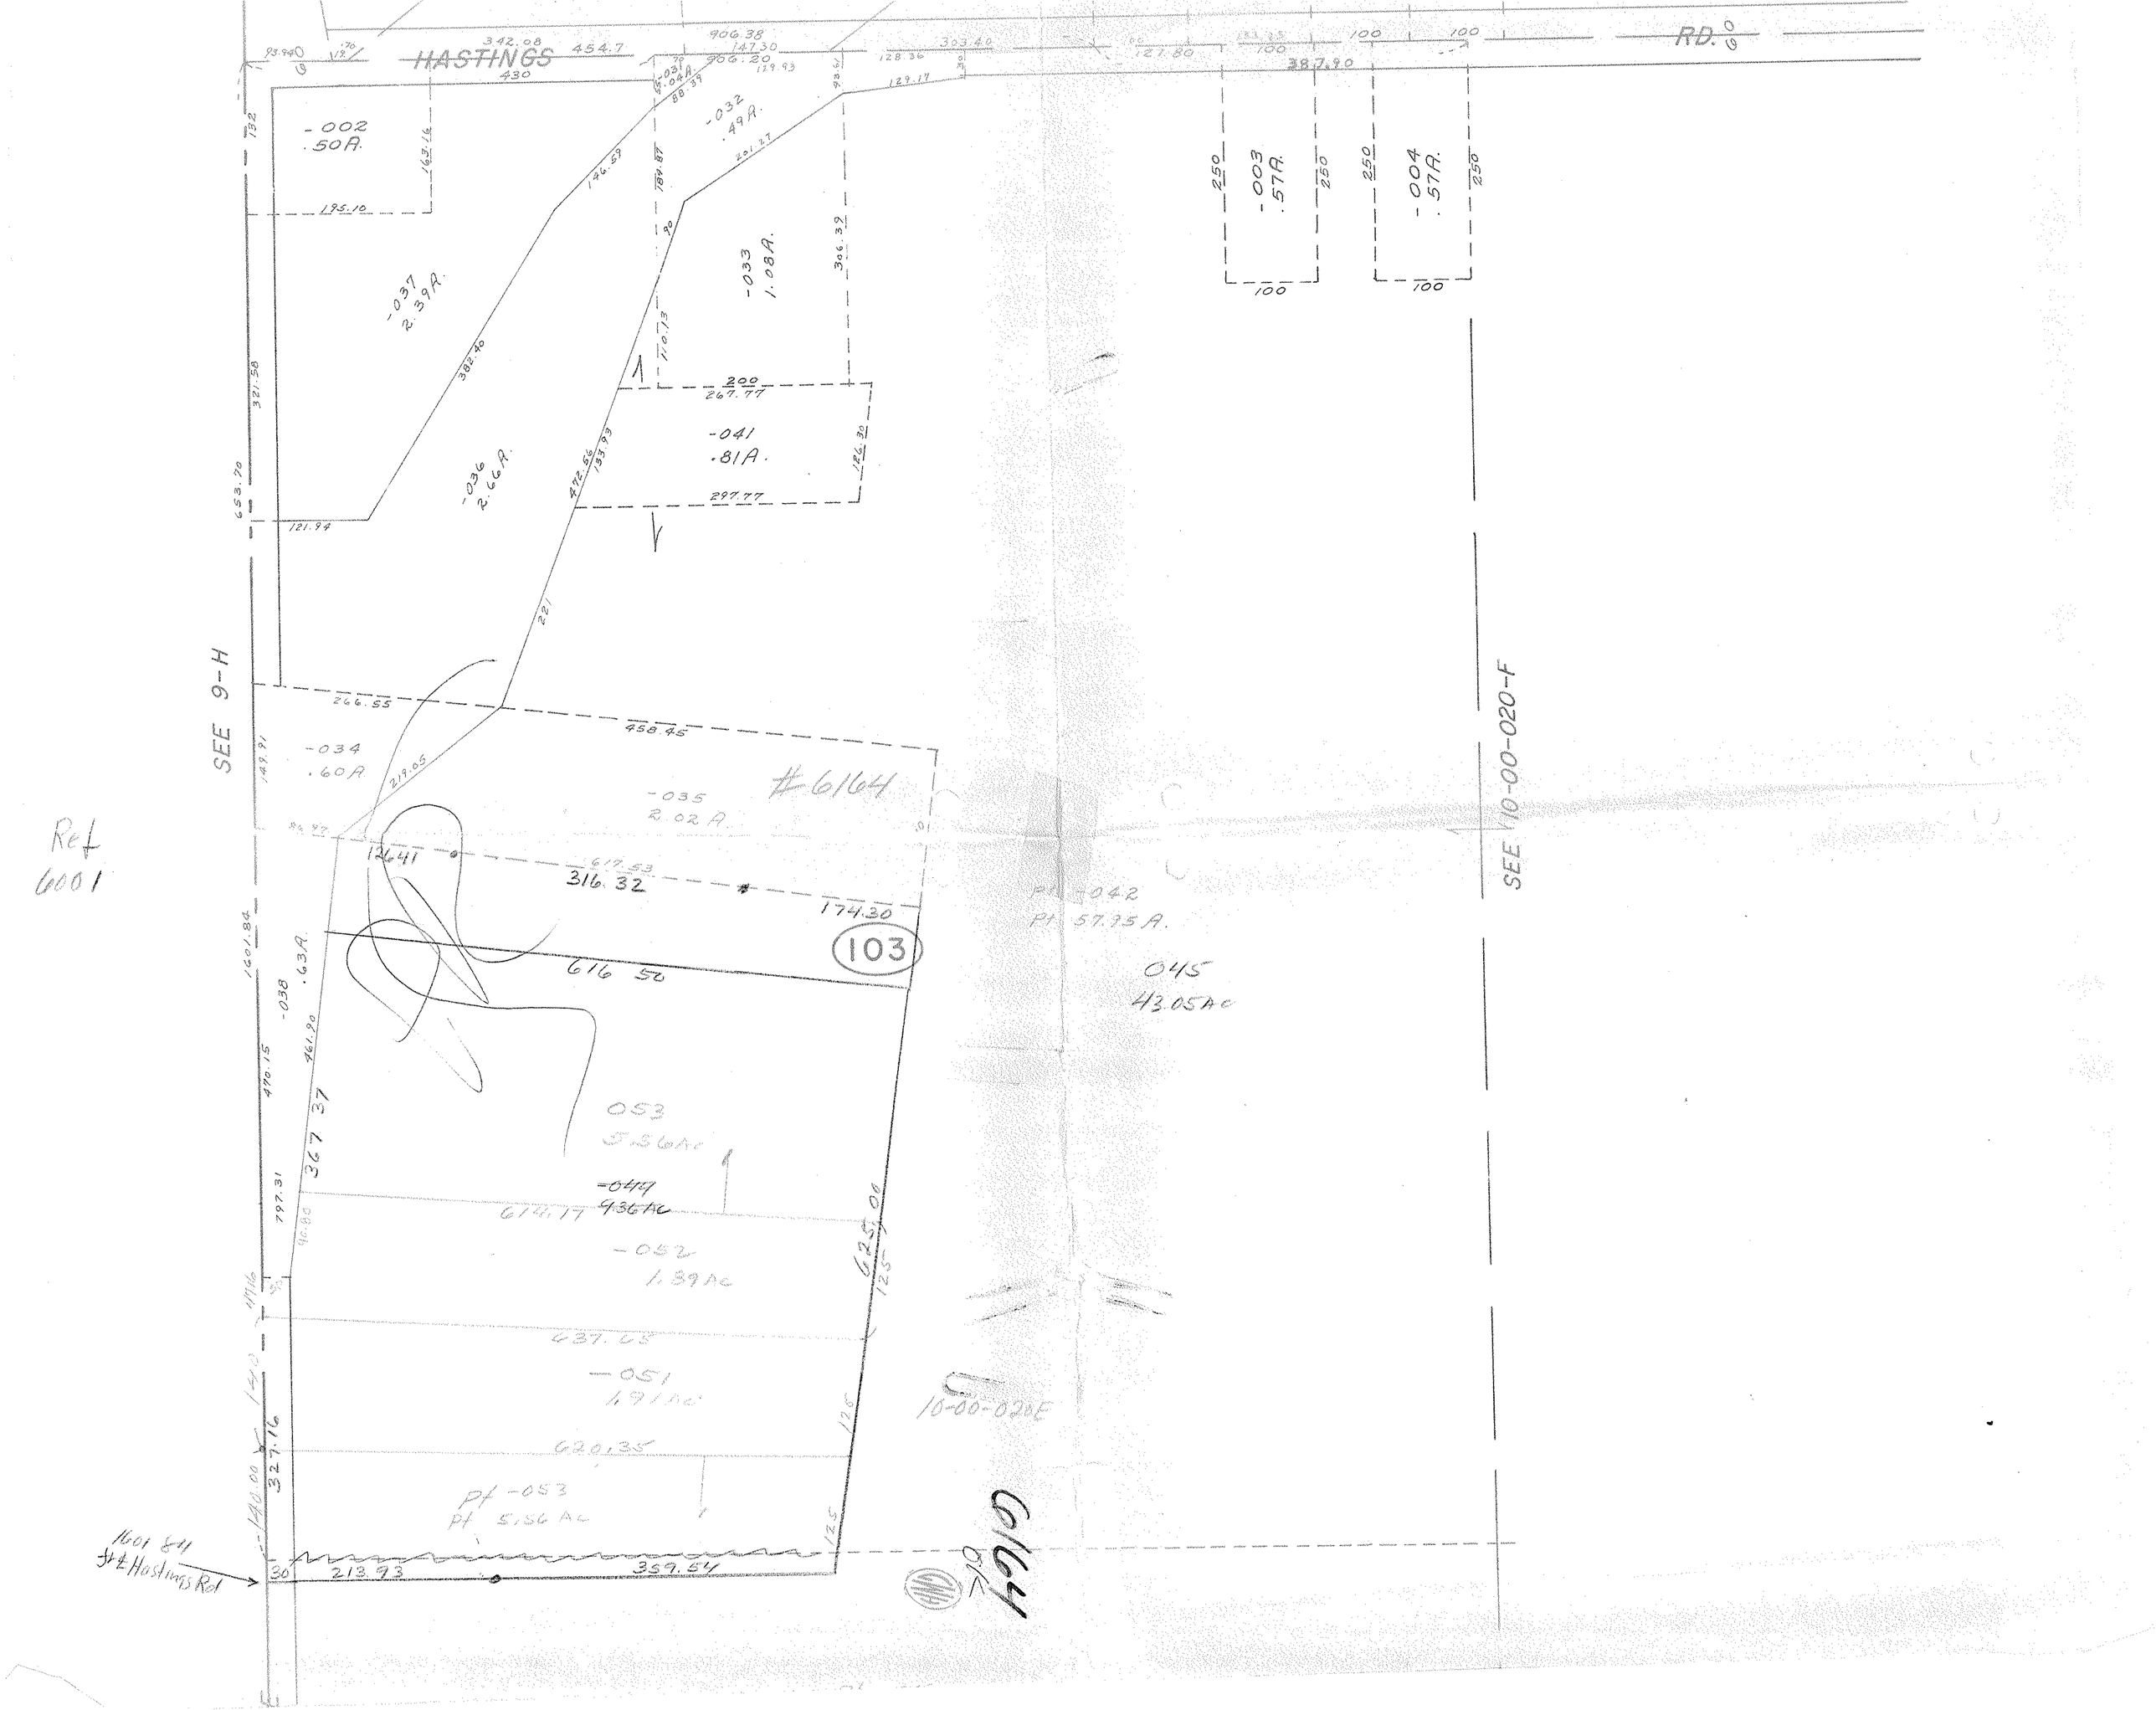
HASTINGS
RD.
SEE 9-H
SEE 10-00-020-F
-002
.50A.
-037
2.39A.
-036
2.66A.
-032
.49A.
-033
1.08A.
-041
.81A.
-003
.57A.
-004
.57A.
-034
.60A.
-035
2.02A.
#6164
103
Pt -042
Pt 57.95A.
045
43.05Ac
053
5.56Ac
-049
9.36Ac
-052
1.89Ac
-051
1.91Ac
10-00-020E
Pt -053
Pt 5.56Ac
1601.84
ft ± Hastings Rd
6164
Ref
6001