


69

6167  
Note Duplicate

6167  
APPROVED  
LORAIN CO.  
MAP DEPT.  
DATE 7-31-74  
BY [Signature]

Copy Made  
8-10-72

S.S.  
8-4-86

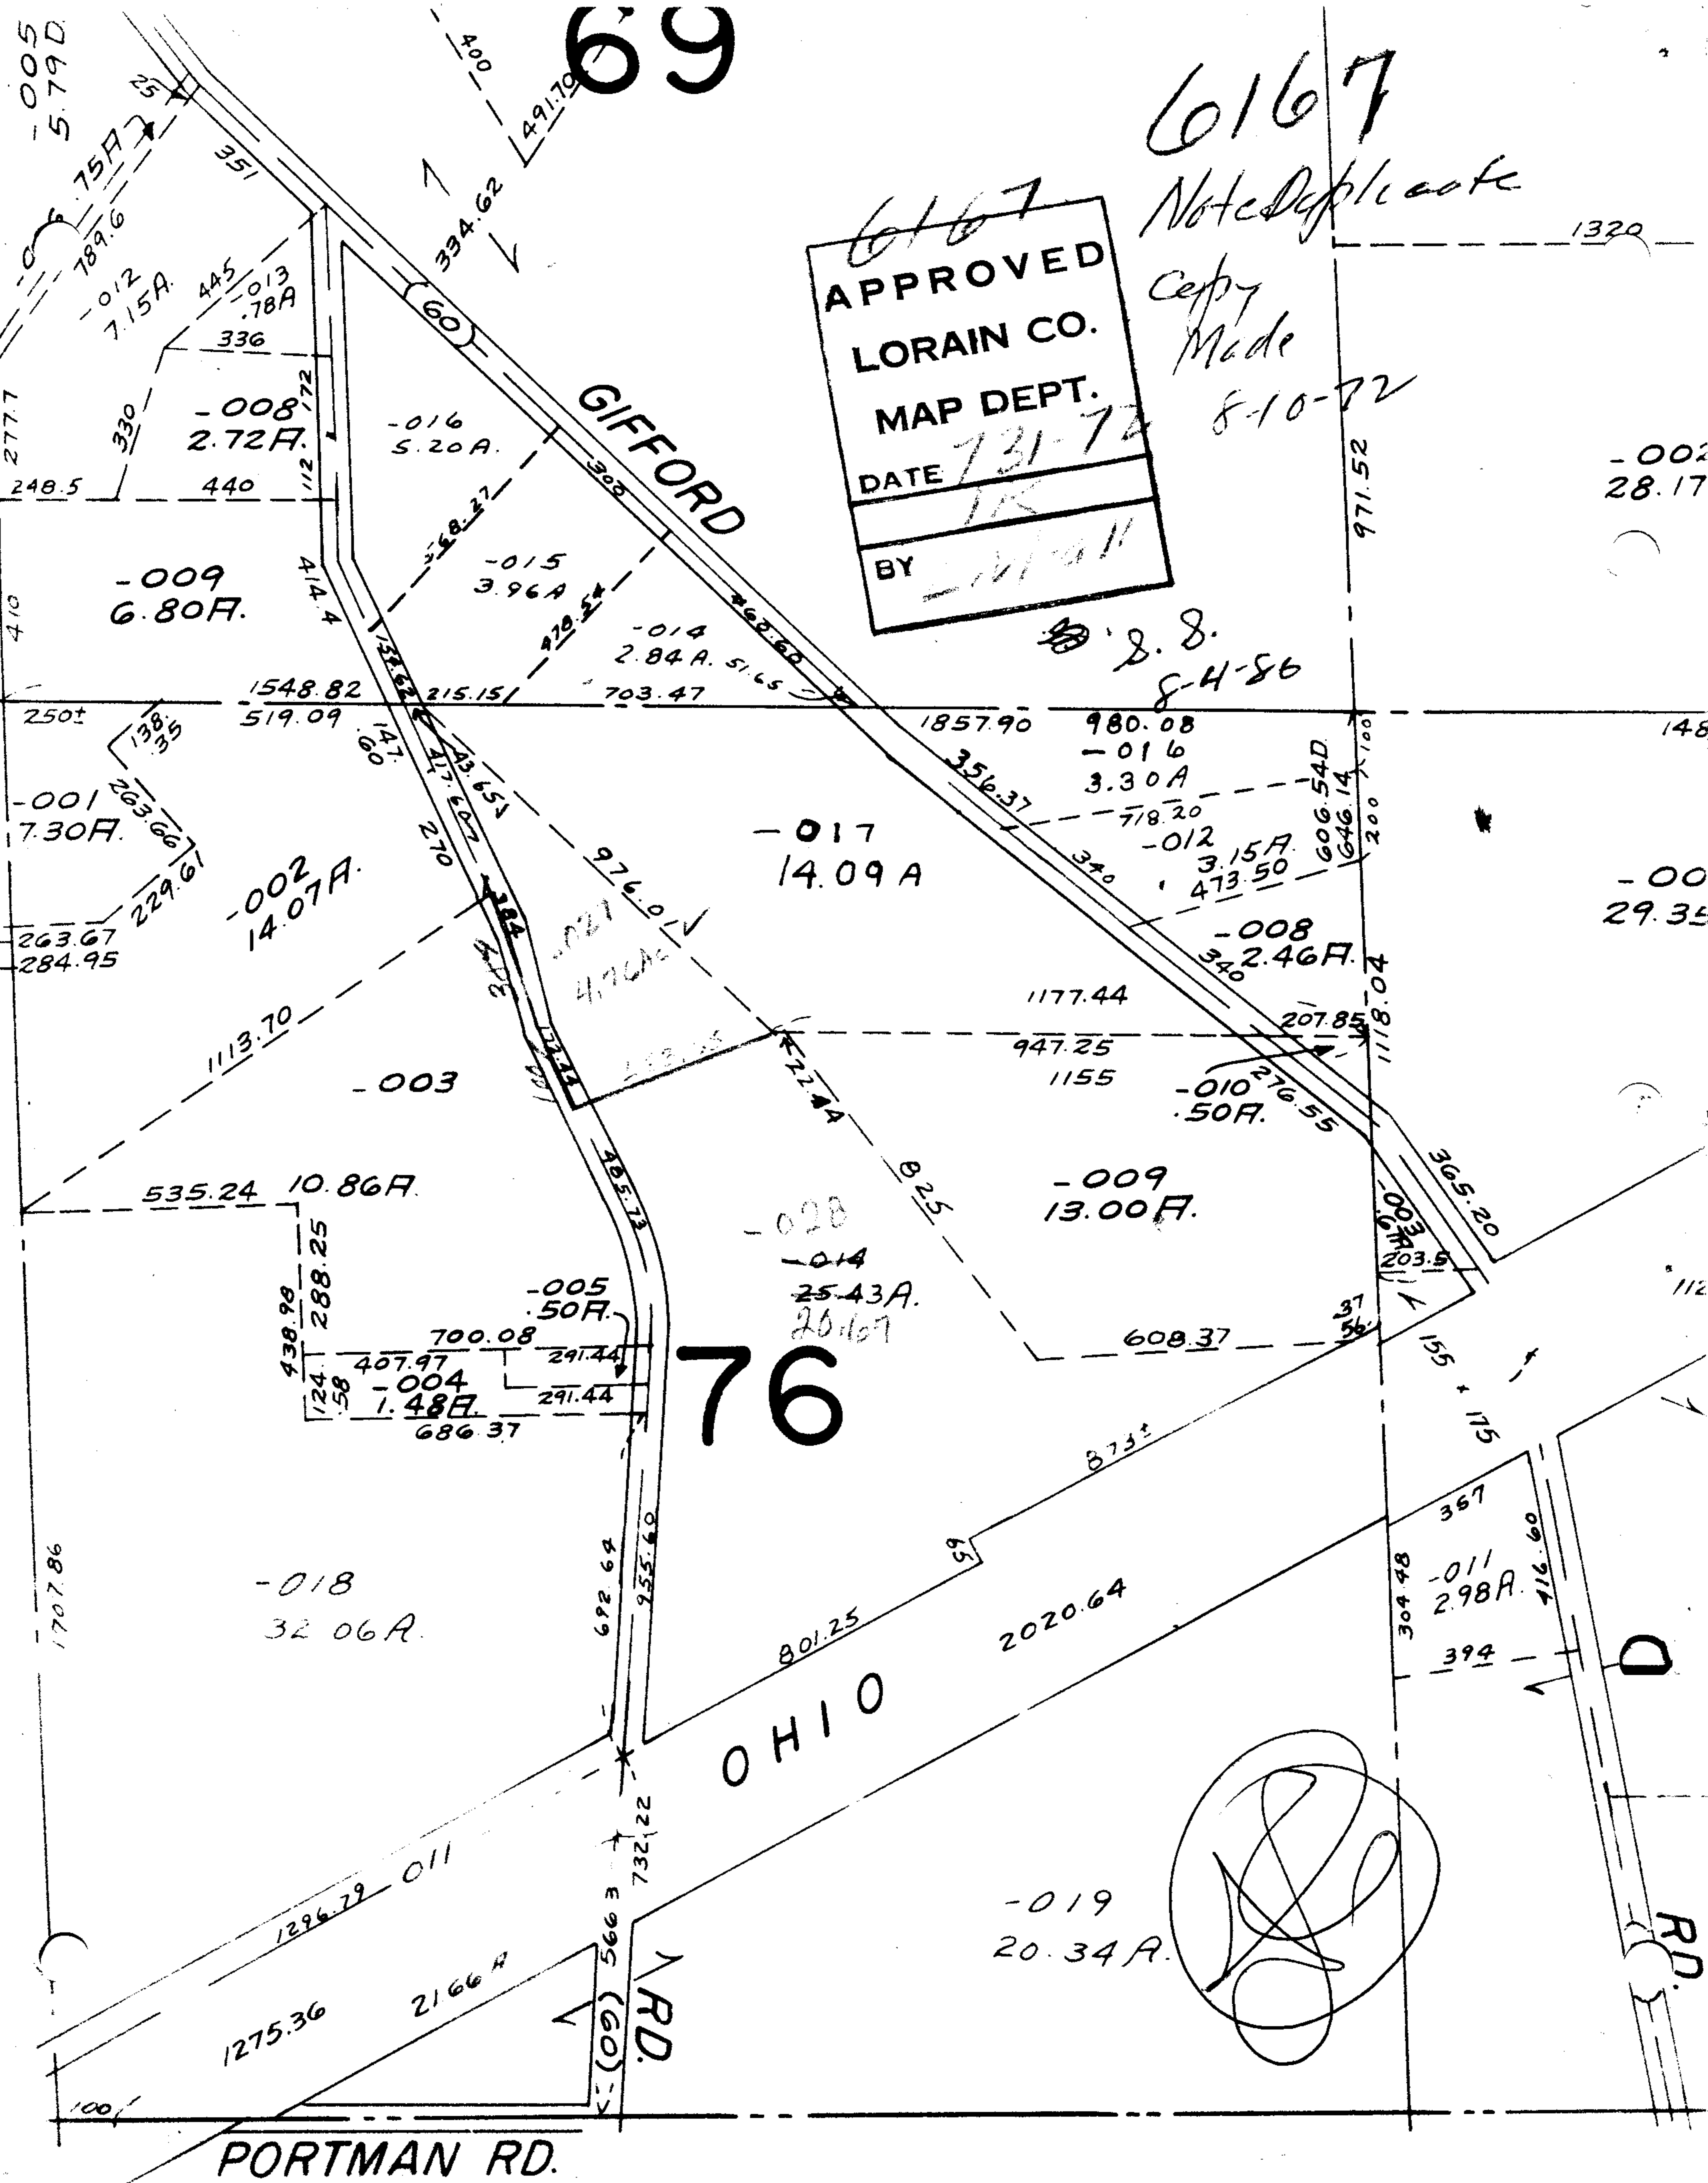

76

