


6174

6174
APPROVED
LORAIN CO.
MAP DEPT.
 DATE 8-1-72
 6-121
 BY L.W.Hall

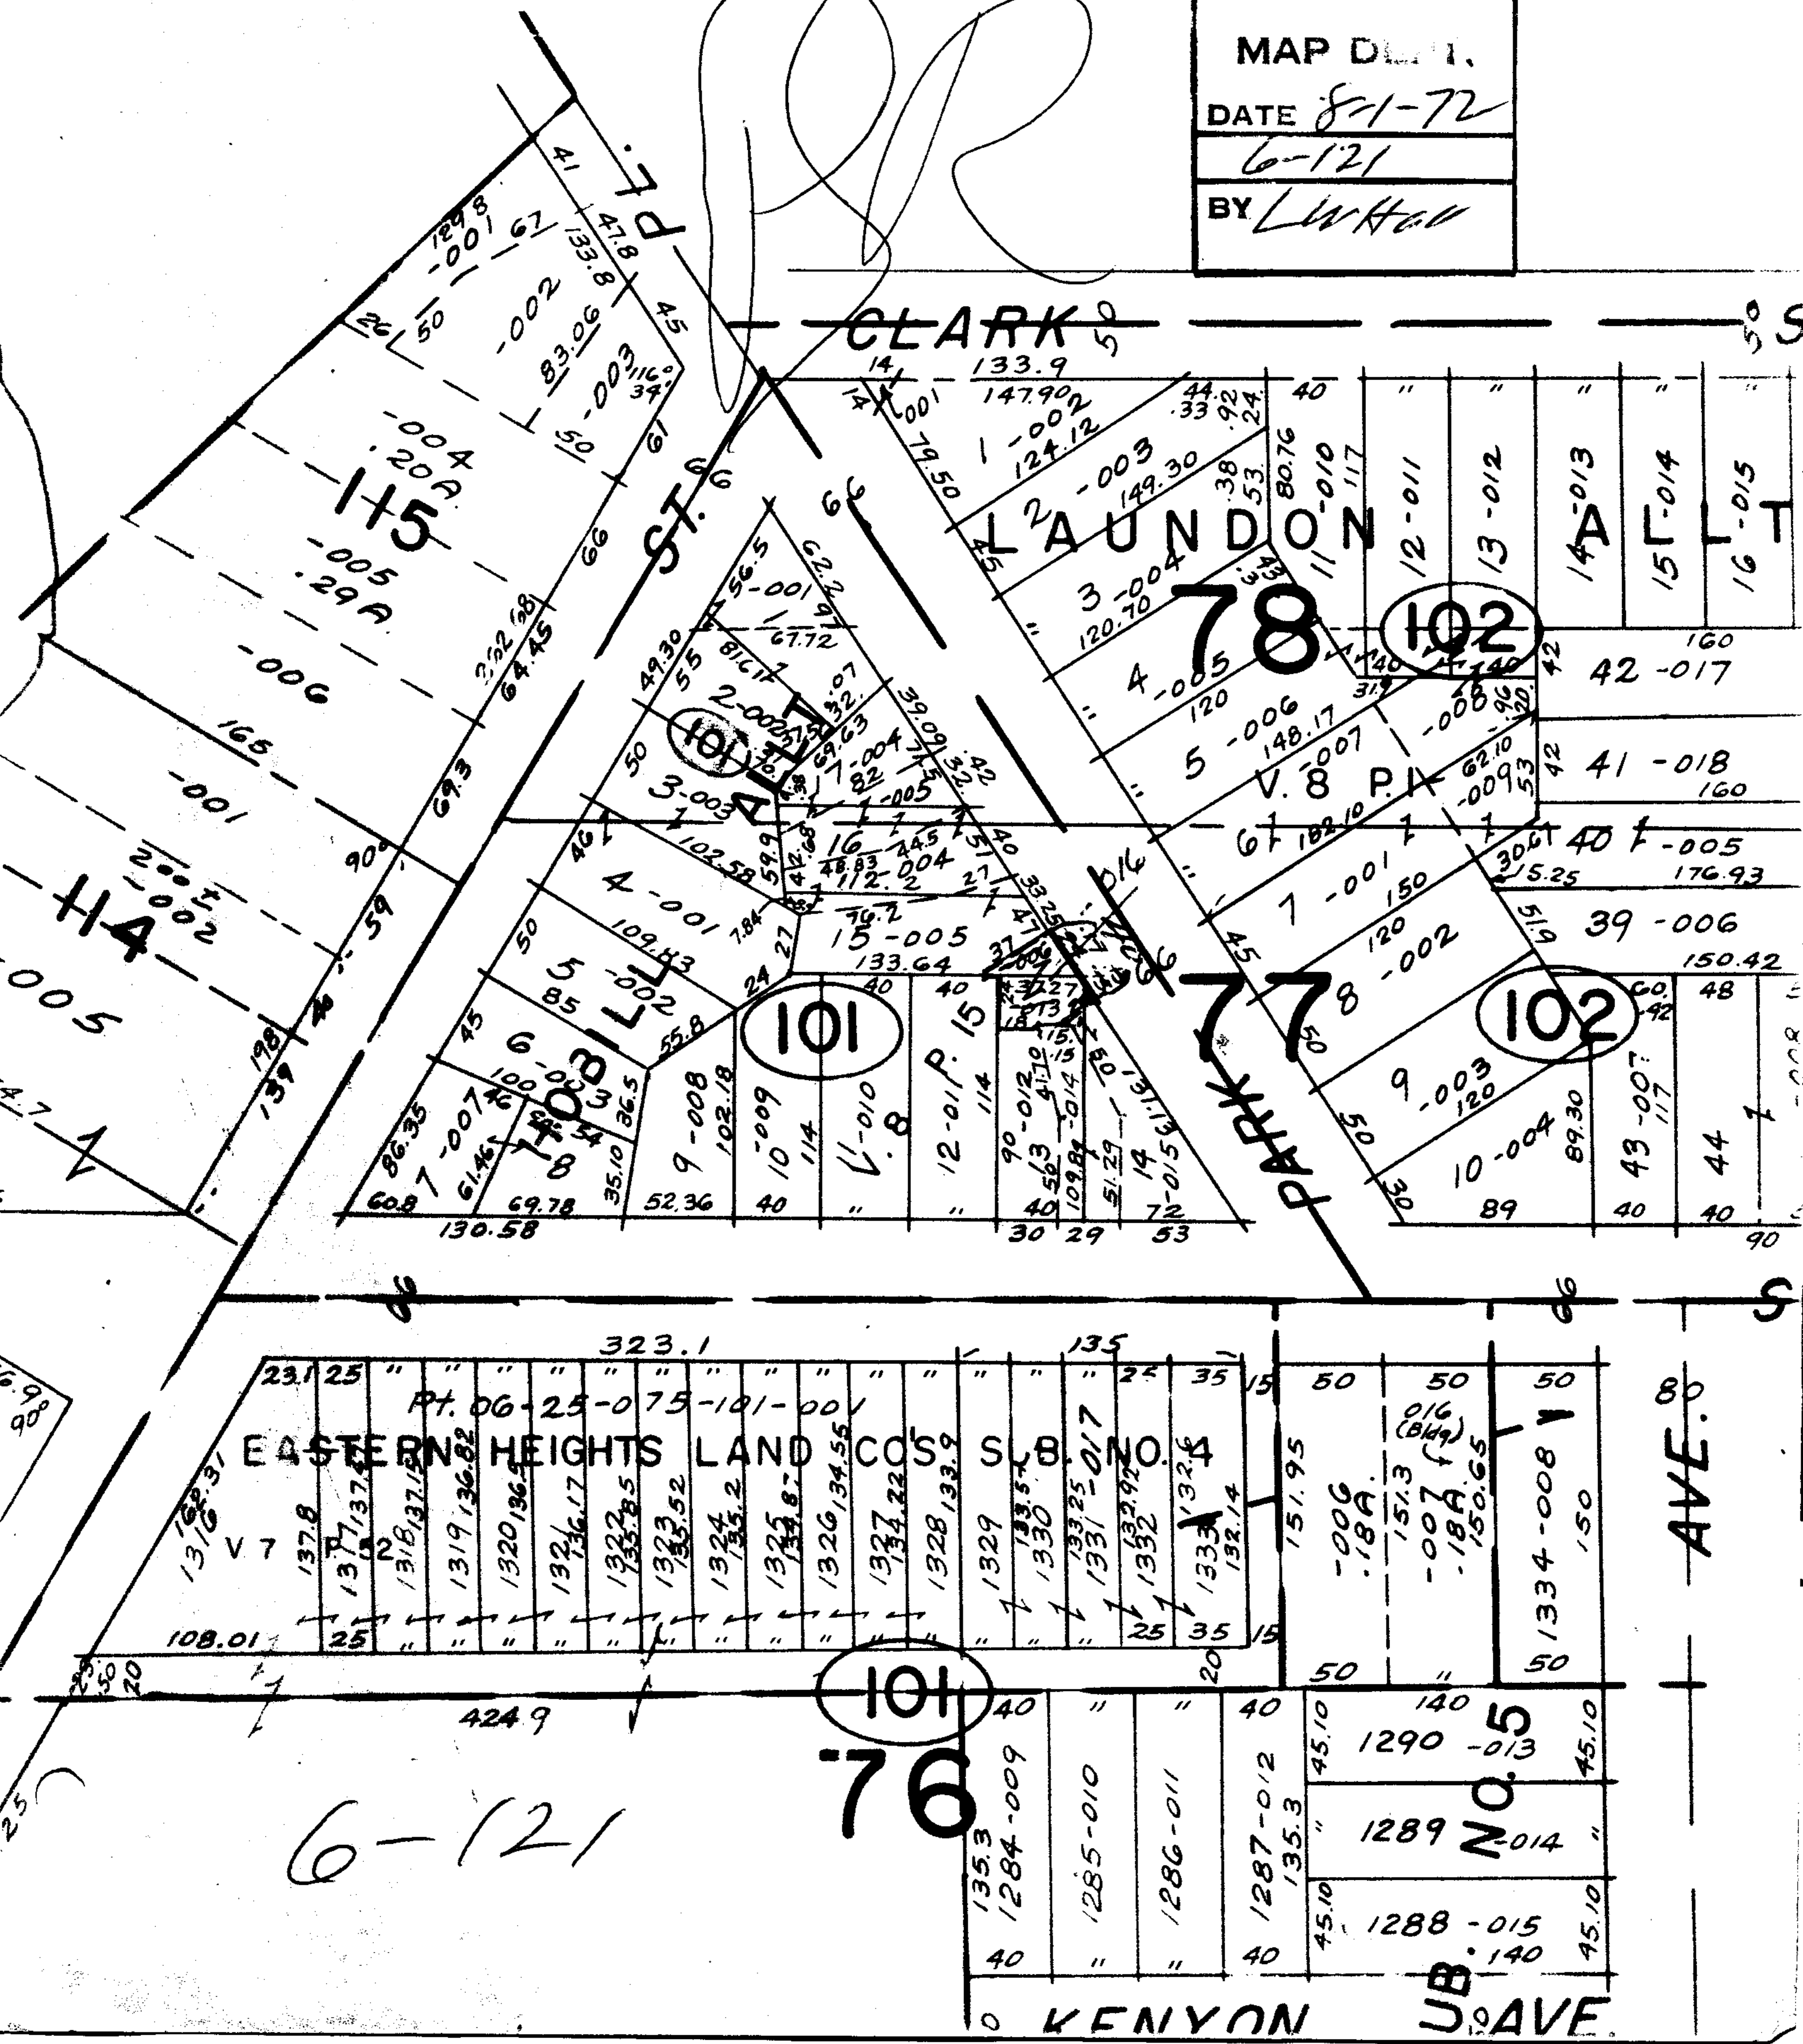

6-121

76

KENYON

JB AVE.

AVE.