


WEBBER

SEL

6192

6192  
**APPROVED**  
 CORAIN CO  
 MAP DE.  
 DATE 8-4-72  
 4-B  
 BY L. W. Hall

MOORE

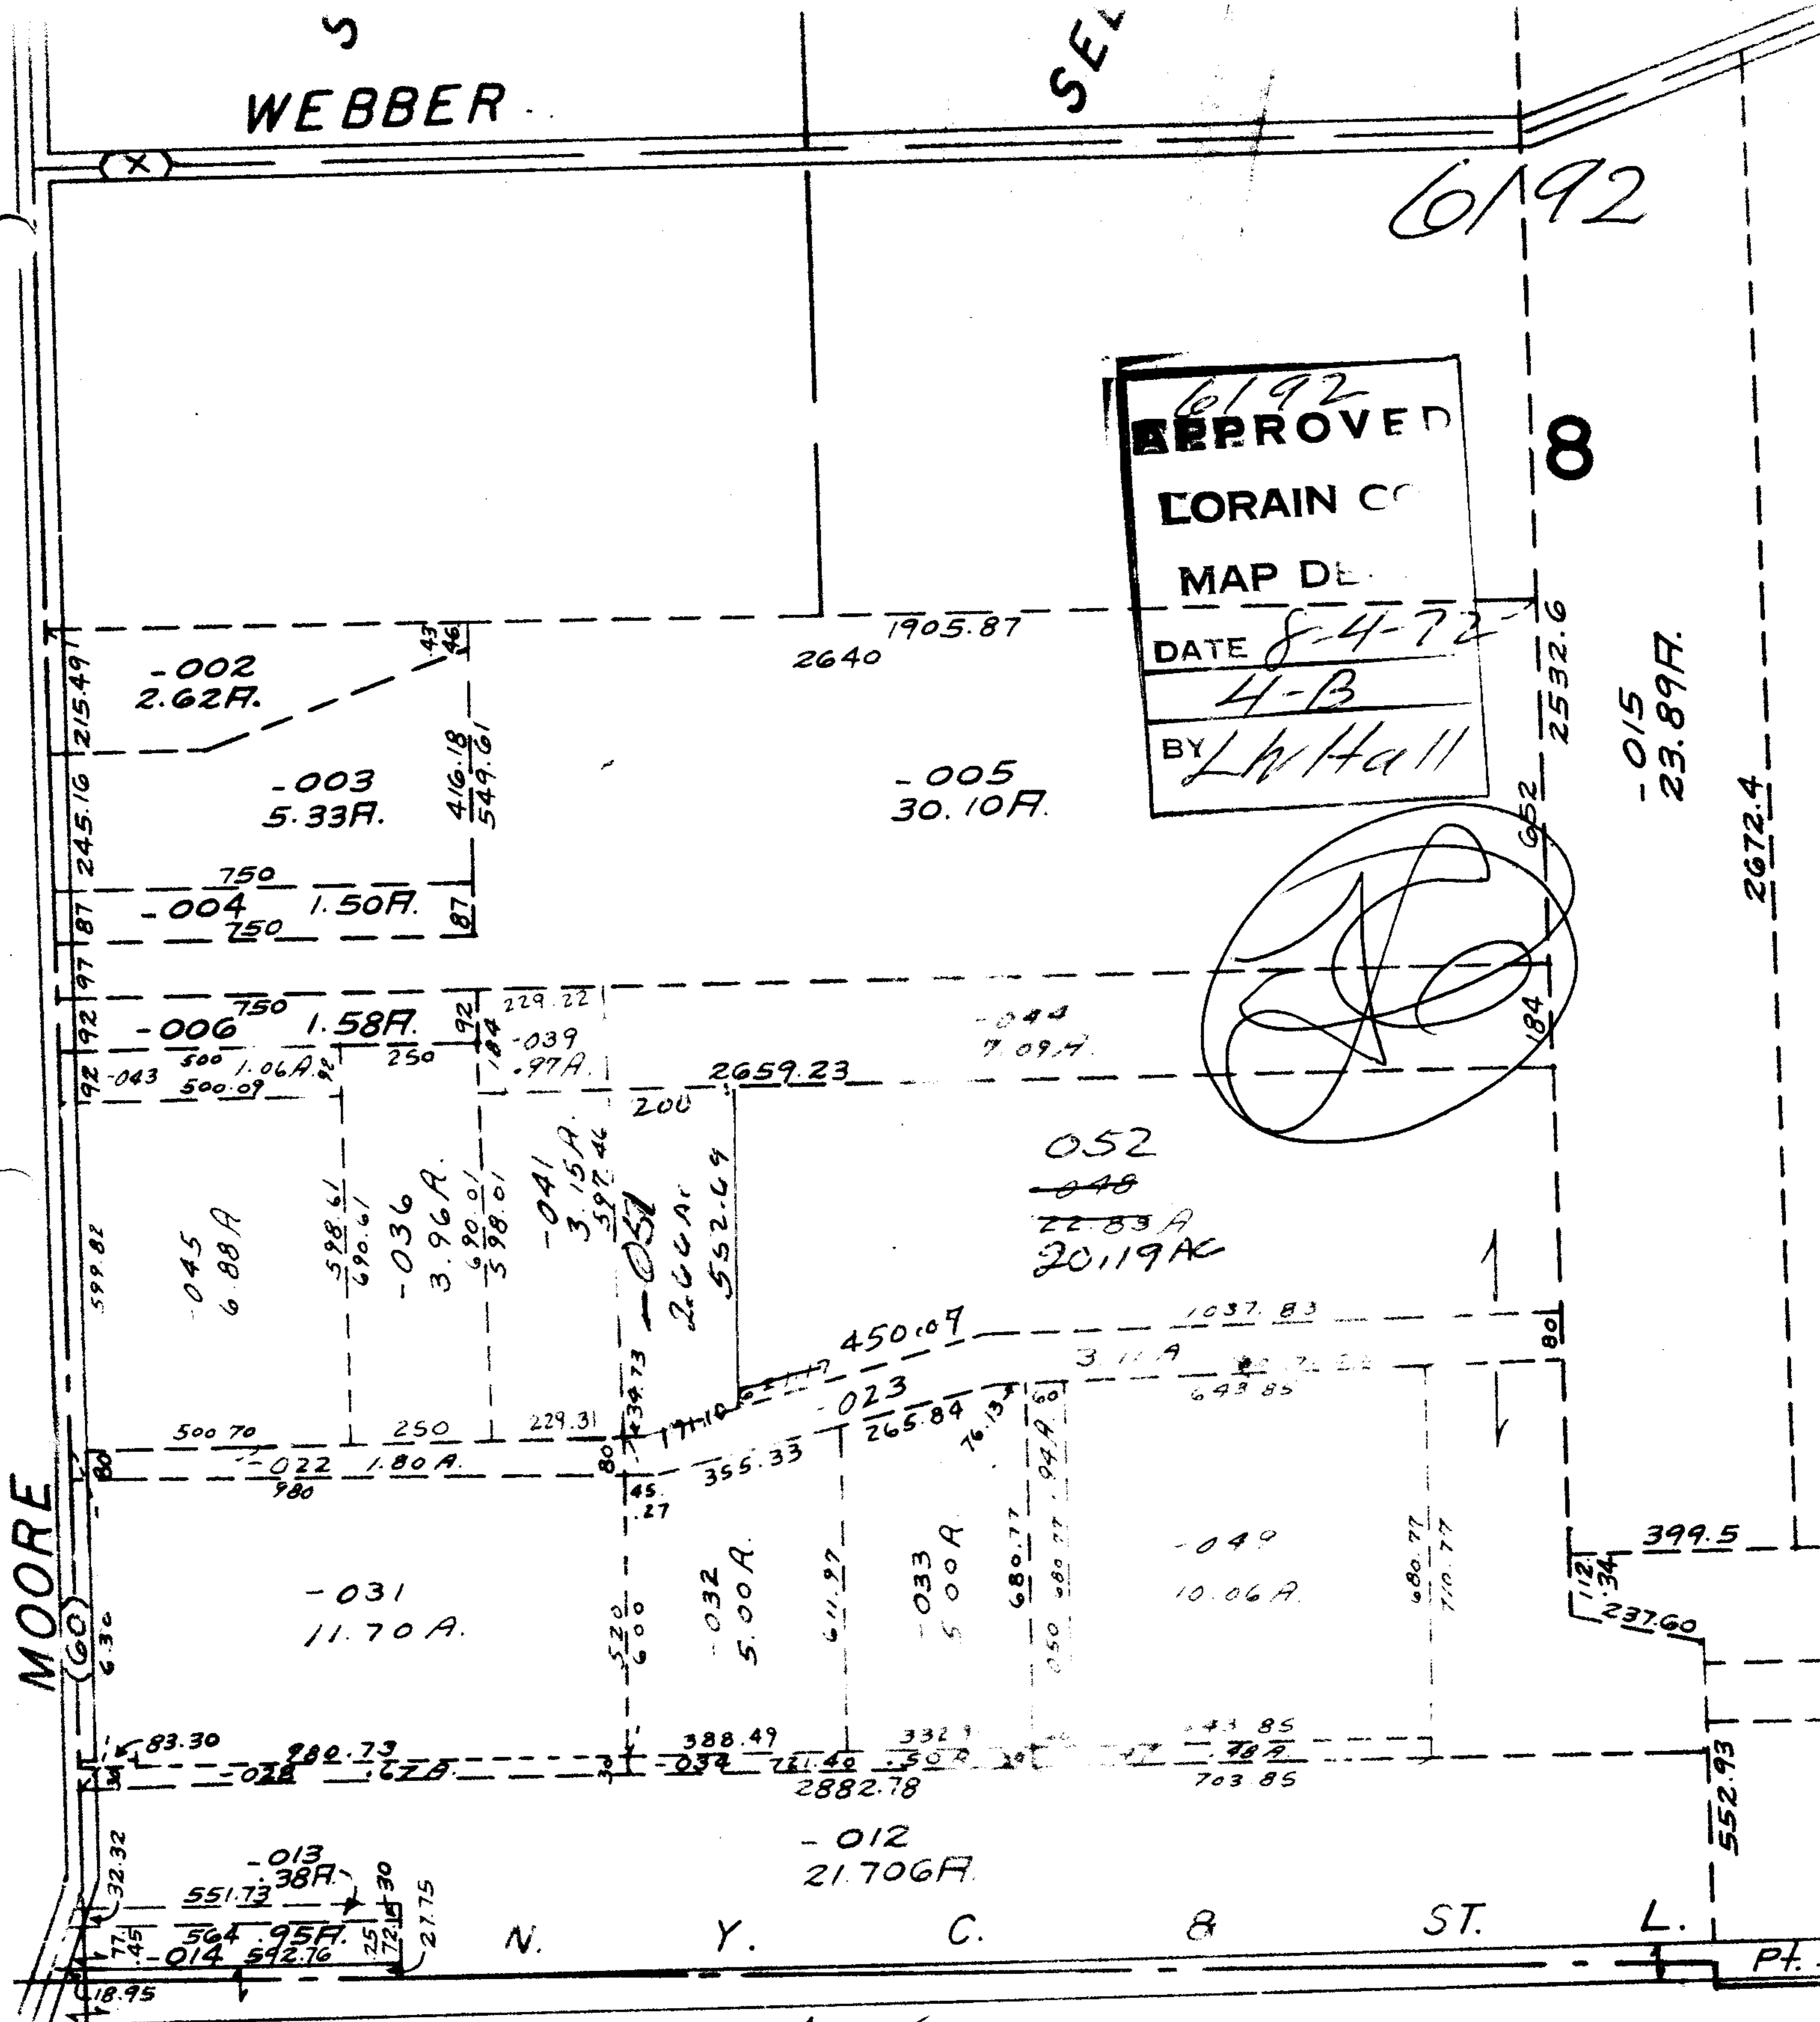

621.17  
 171.10  
 450.07

# AVON LAKE VILLAGE

SCALE: 1" = 400'