
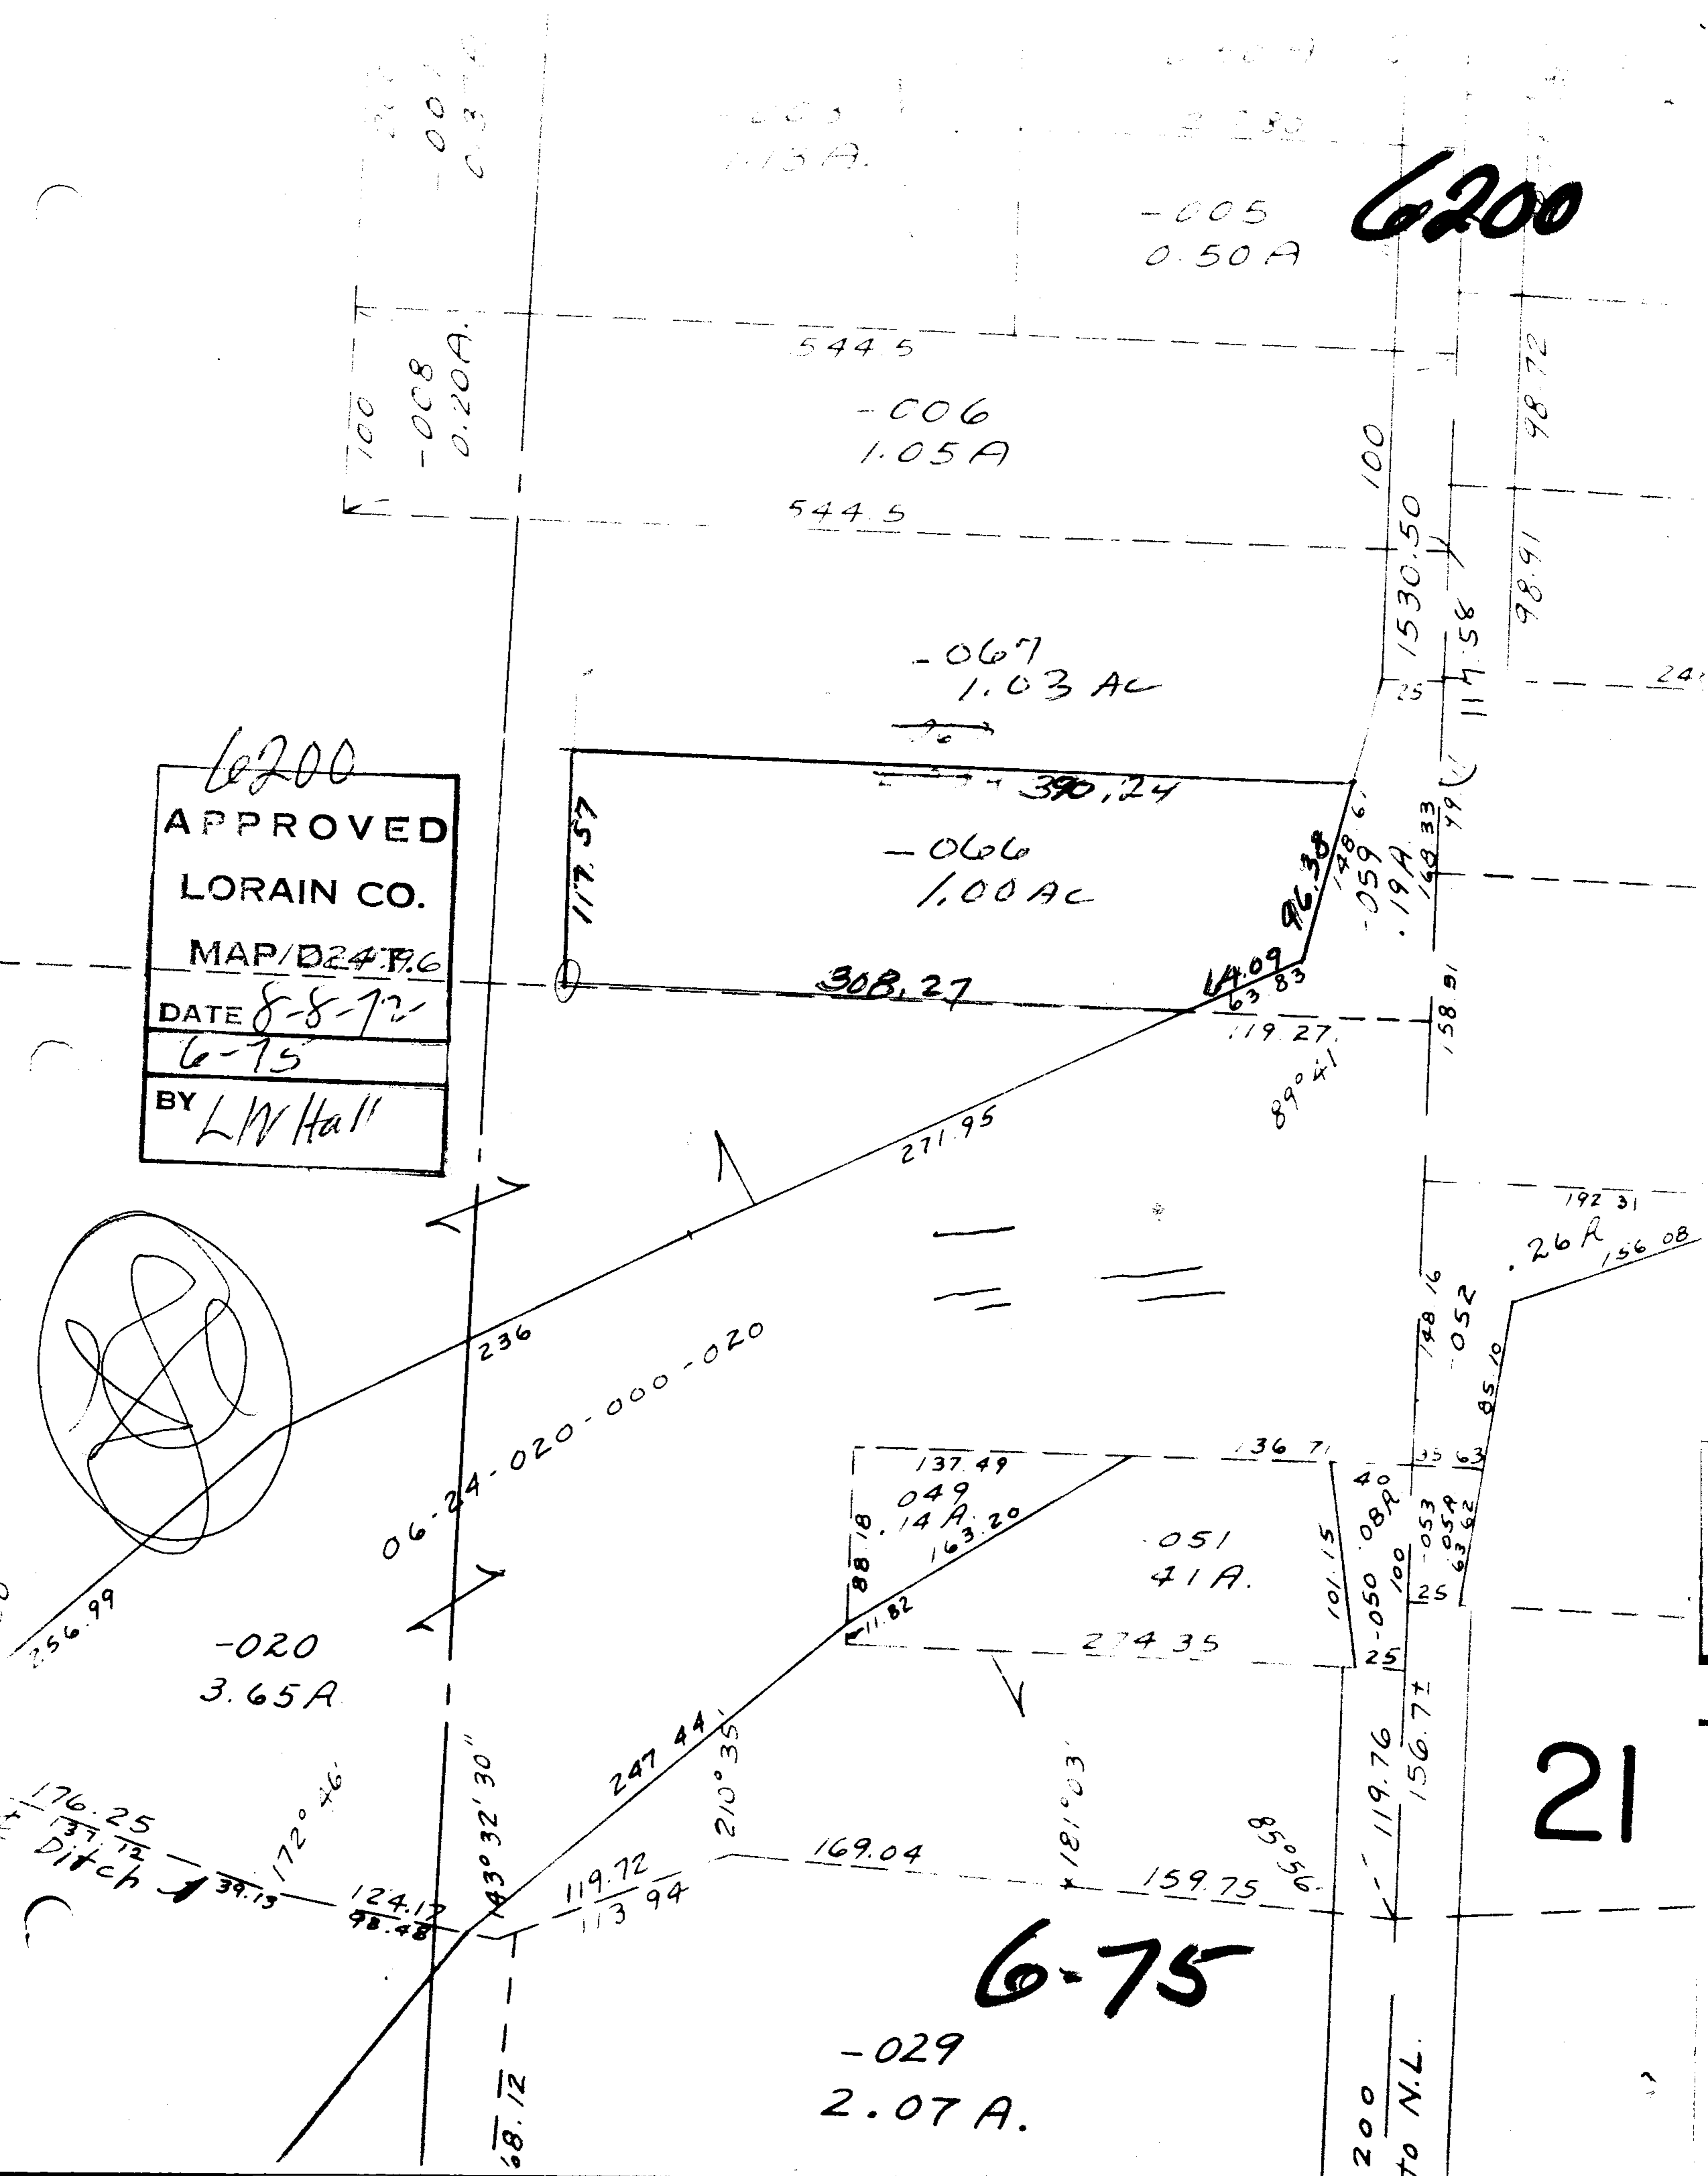


6200

6200
 APPROVED
 LORAIN CO.
 MAP 024 P. 6
 DATE 8-8-72
 6-75
 BY L.W. Hall

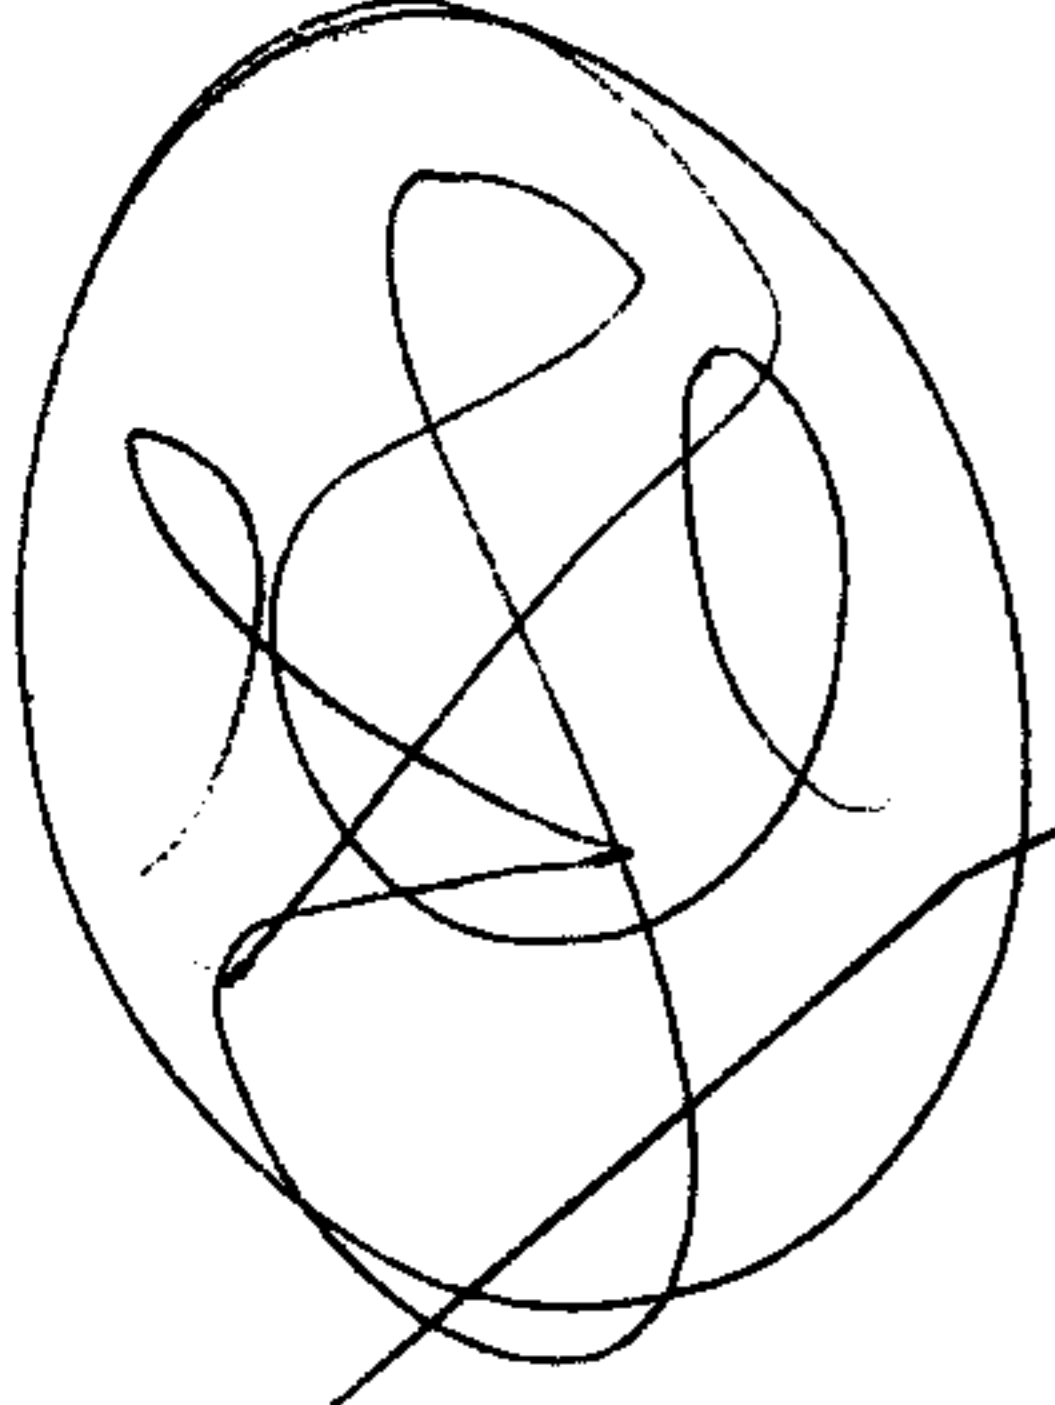

21

6-75

-029
2.07 A.

200
TO N.L.