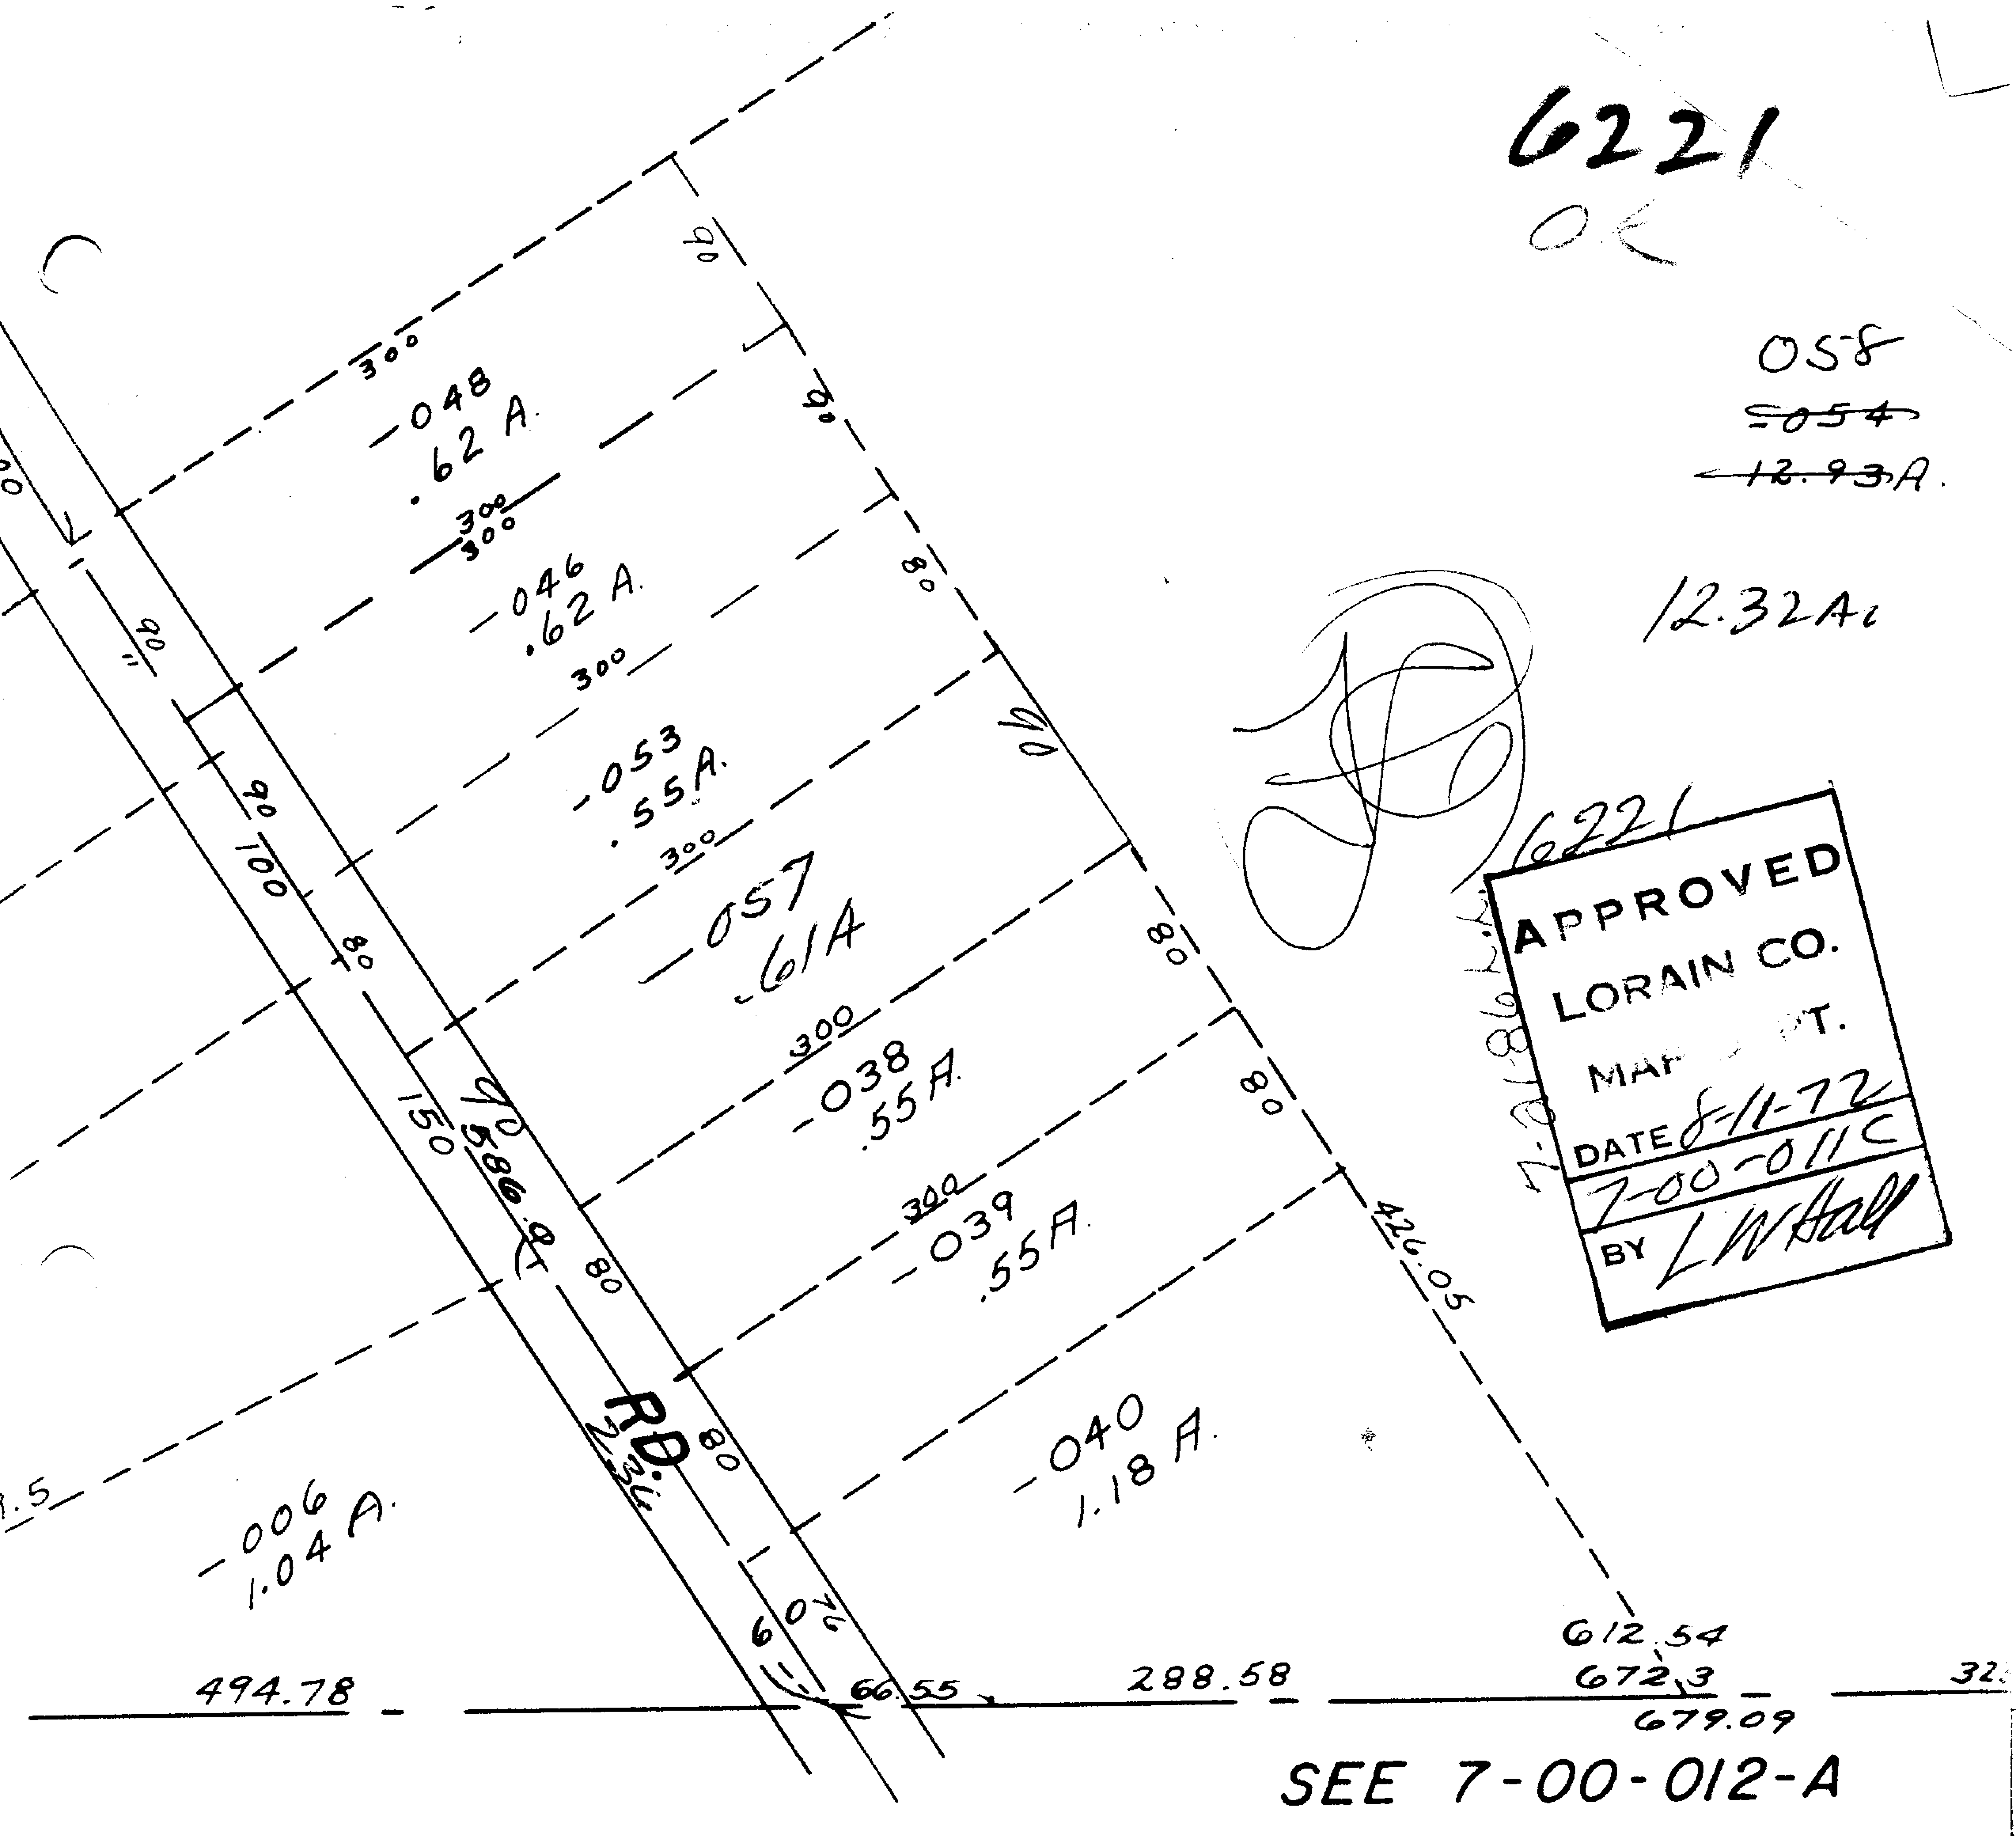

7-00-011C

RIDGEVILLE TWP.

SCALE: 1" = 100'