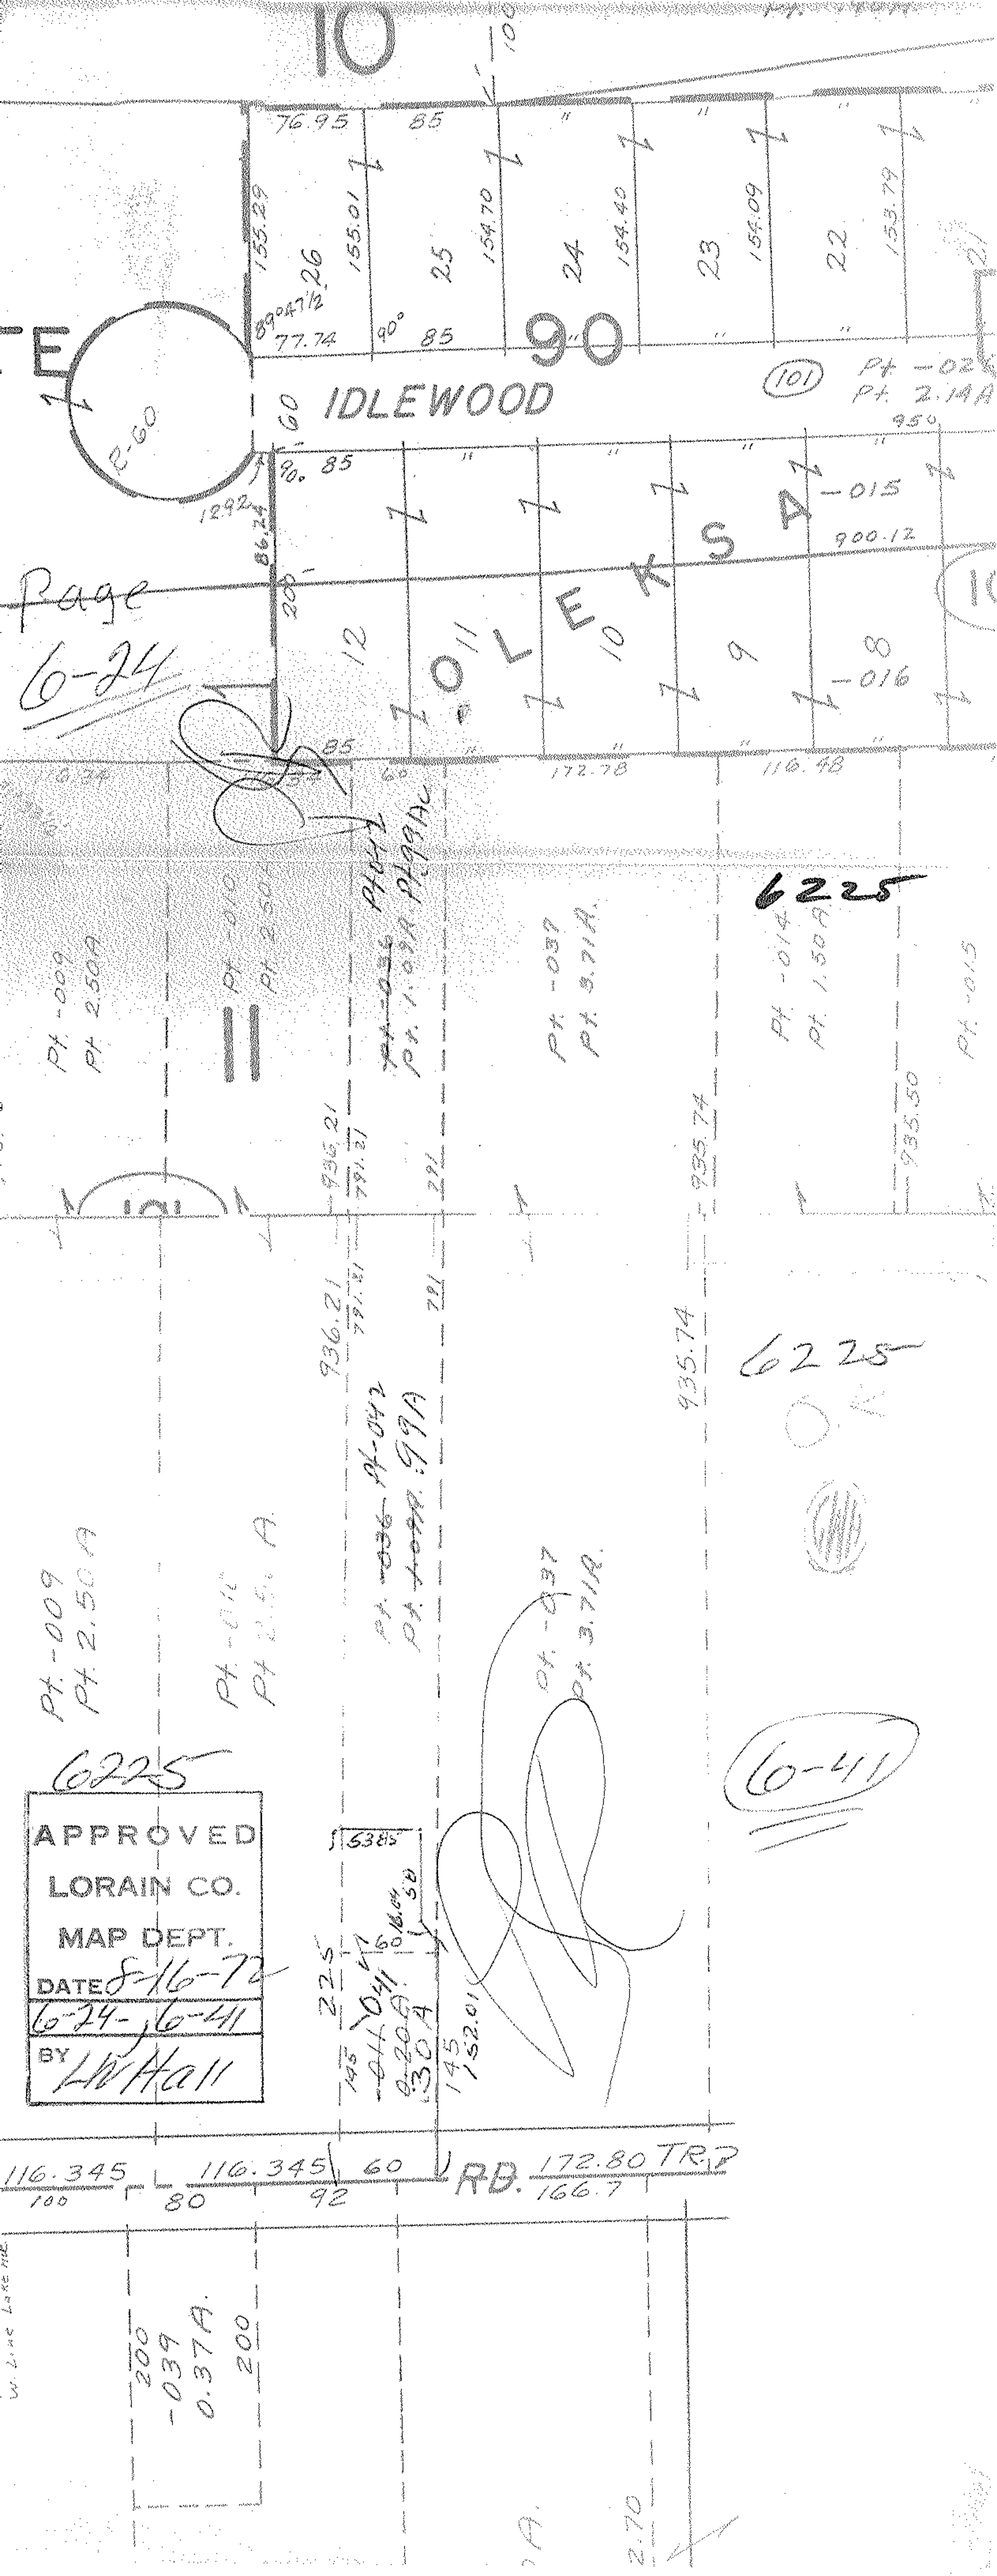
10
76.95
85
155.29
155.01
154.70
154.40
154.09
153.79
26
25
24
23
22
89°04½'
77.74
90°
85
90
IDLEWOOD
60
2.60
(101)
Pt. -026
Pt. 2.14A
95.0
90.12
86.24
208
1292
85
172.78
116.48
900.12
-015
-016
TOLEKSA
12
11
10
9
8
Page
6-24
6225
Pt. -009
Pt. 2.50A
Pt. -010
Pt. 2.50A
Pt. -035
Pt. 1.09A
Pt. -037
Pt. 3.71A.
Pt. -014
Pt. 1.50A
Pt. -015
935.21
791.81
791
935.74
935.50
936.21
791.81
791
935.74
Pt. -036
Pt. 1.09A
Pt. -037
Pt. 3.71A.
6225
6-41
APPROVED
LORAIN CO.
MAP DEPT.
DATE 8-16-72
6-24, 6-41
BY LW Hall
5385
225
145
60
116.345
100
116.345
80
60
92
RD. 172.80
166.7
TR.?
200
-039
0.37A.
200
2.70