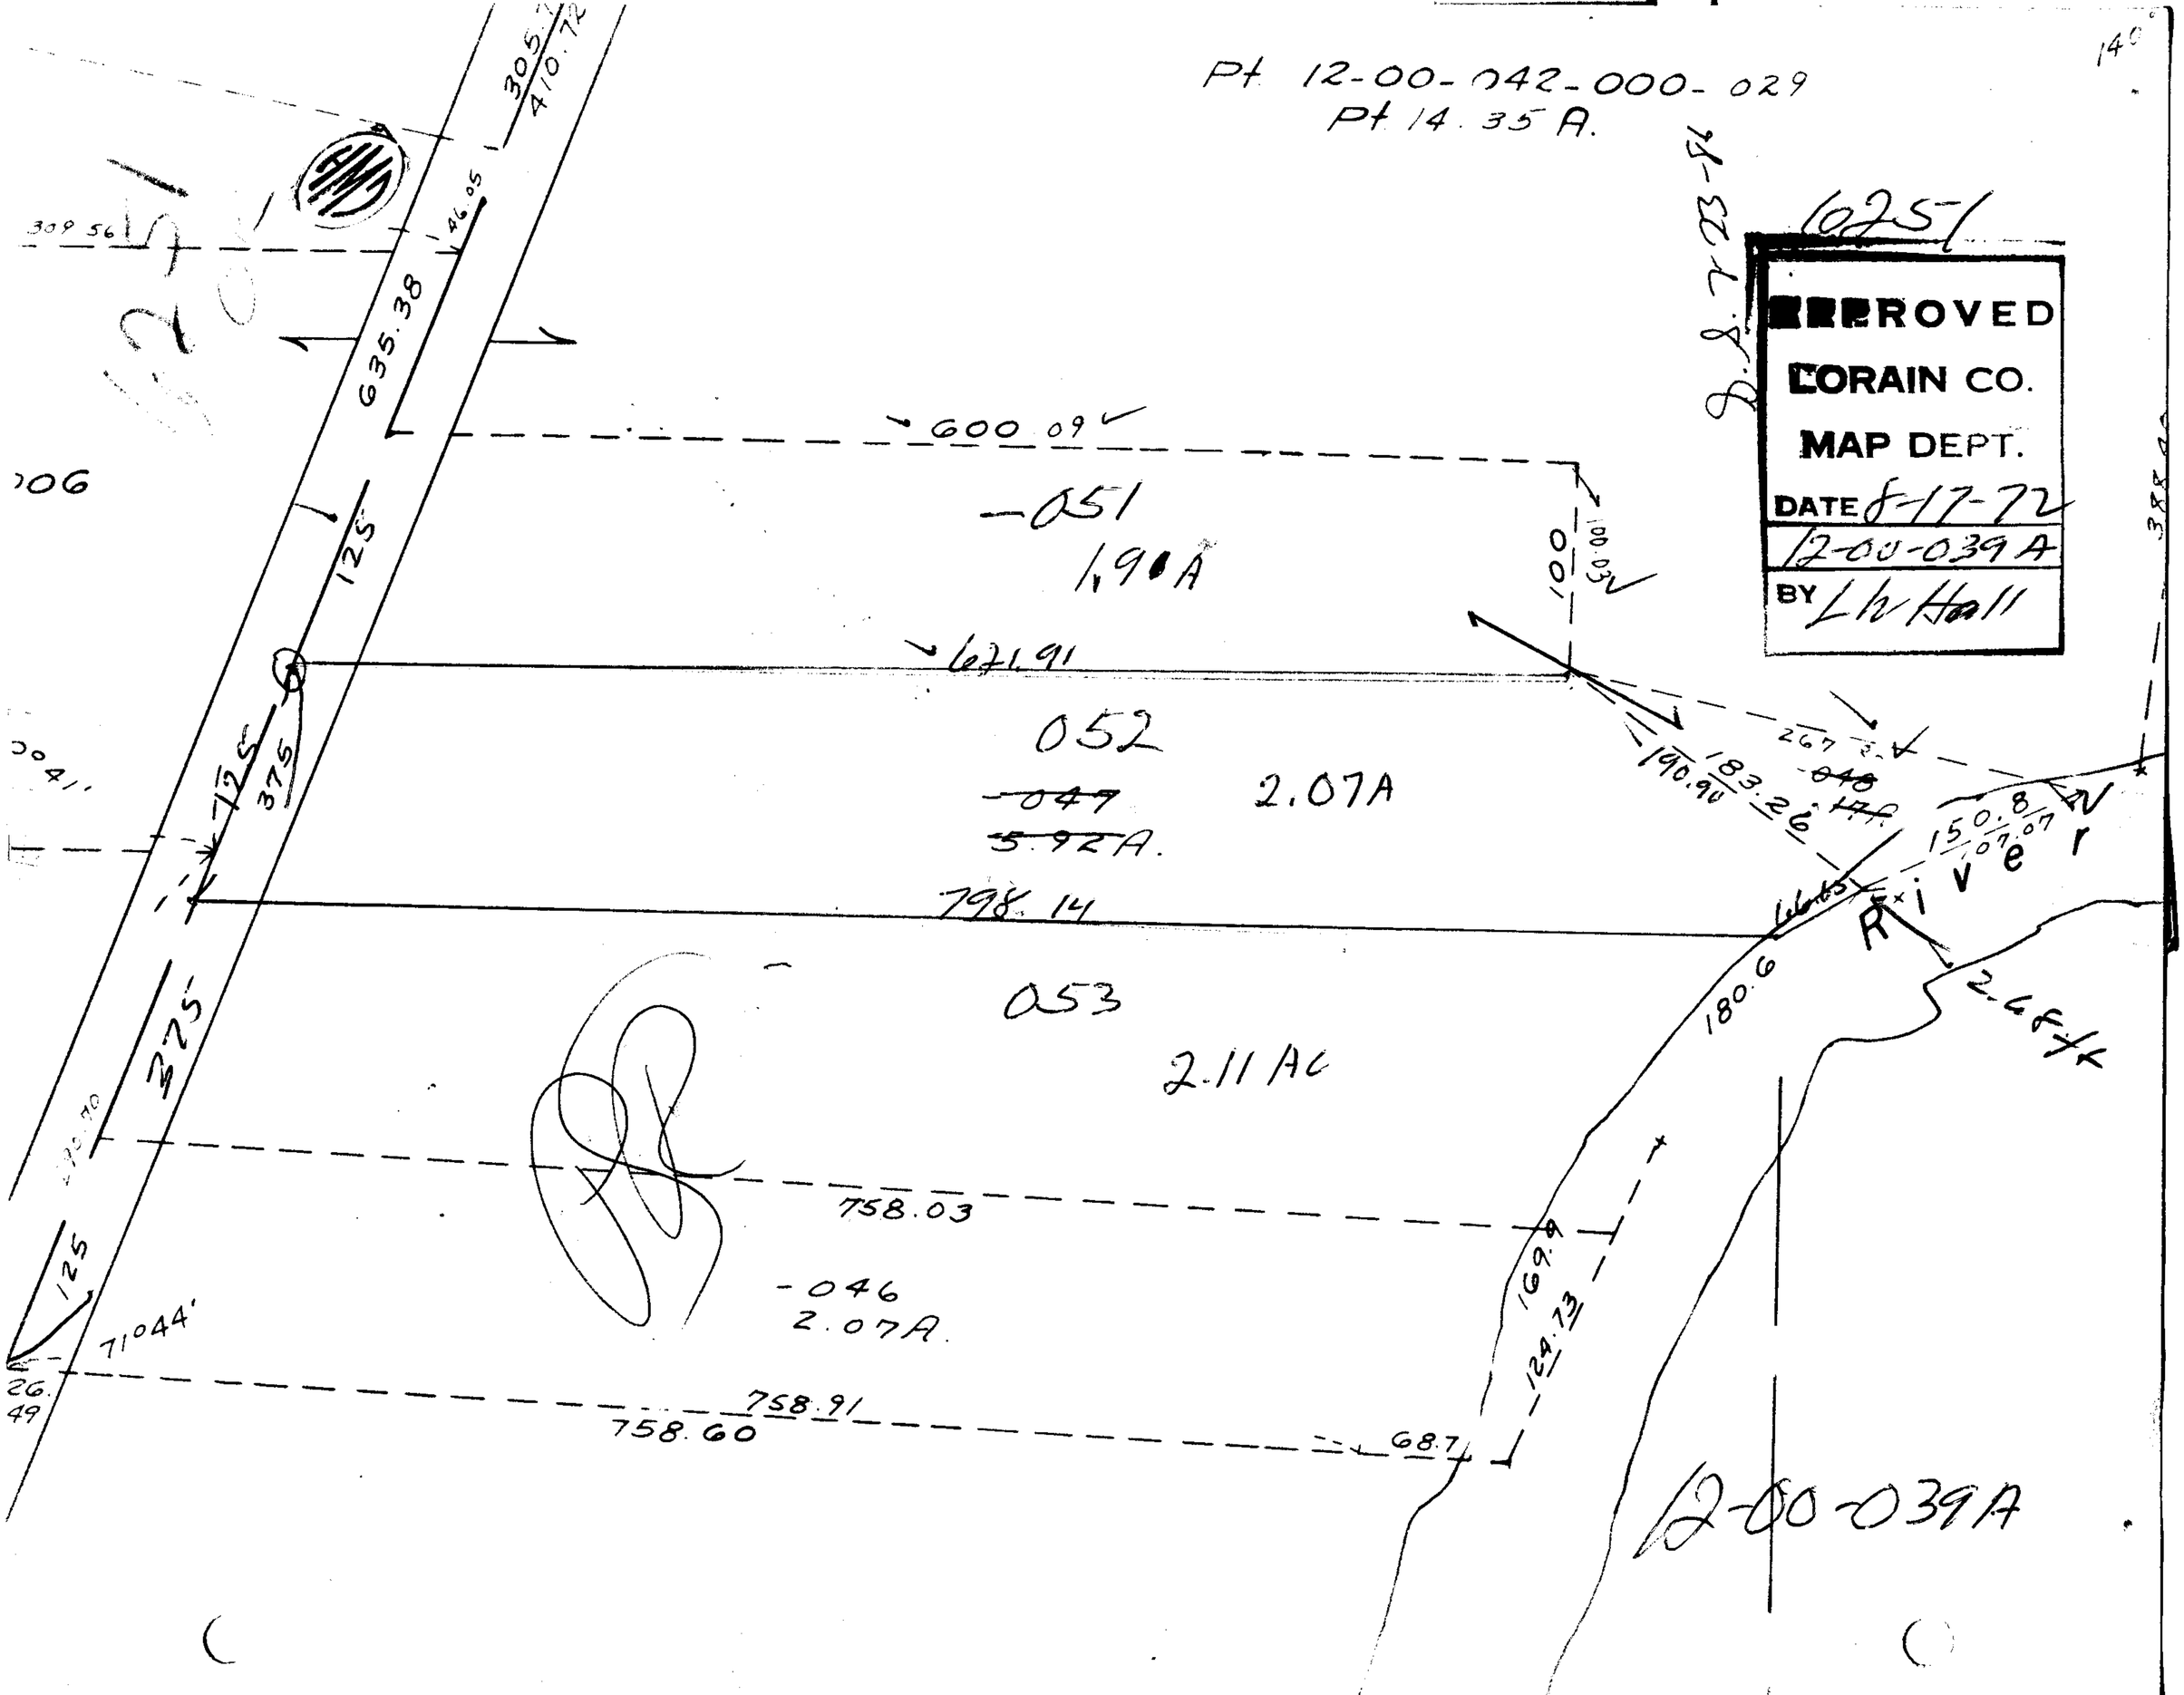

Pt. 12-00-042-000-029
Pt. 14.35 A.
10251
APPROVED
LORAIN CO.
MAP DEPT.
DATE 8-17-72
12-00-039 A
BY L.W. Hall
305.7
410.72
46.05
635.38
309.56
600.09
-051
1.90 A
100
100.03
621.91
052
2.07A
-047
5.92 A.
798.14
053
2.11 AC
758.03
-046
2.07A.
758.91
758.60
68.7
169.9
124.73
180.6
150.8
107.07
183.26
190.90
267.2
-048
River
2.68 ft
12-00-039A