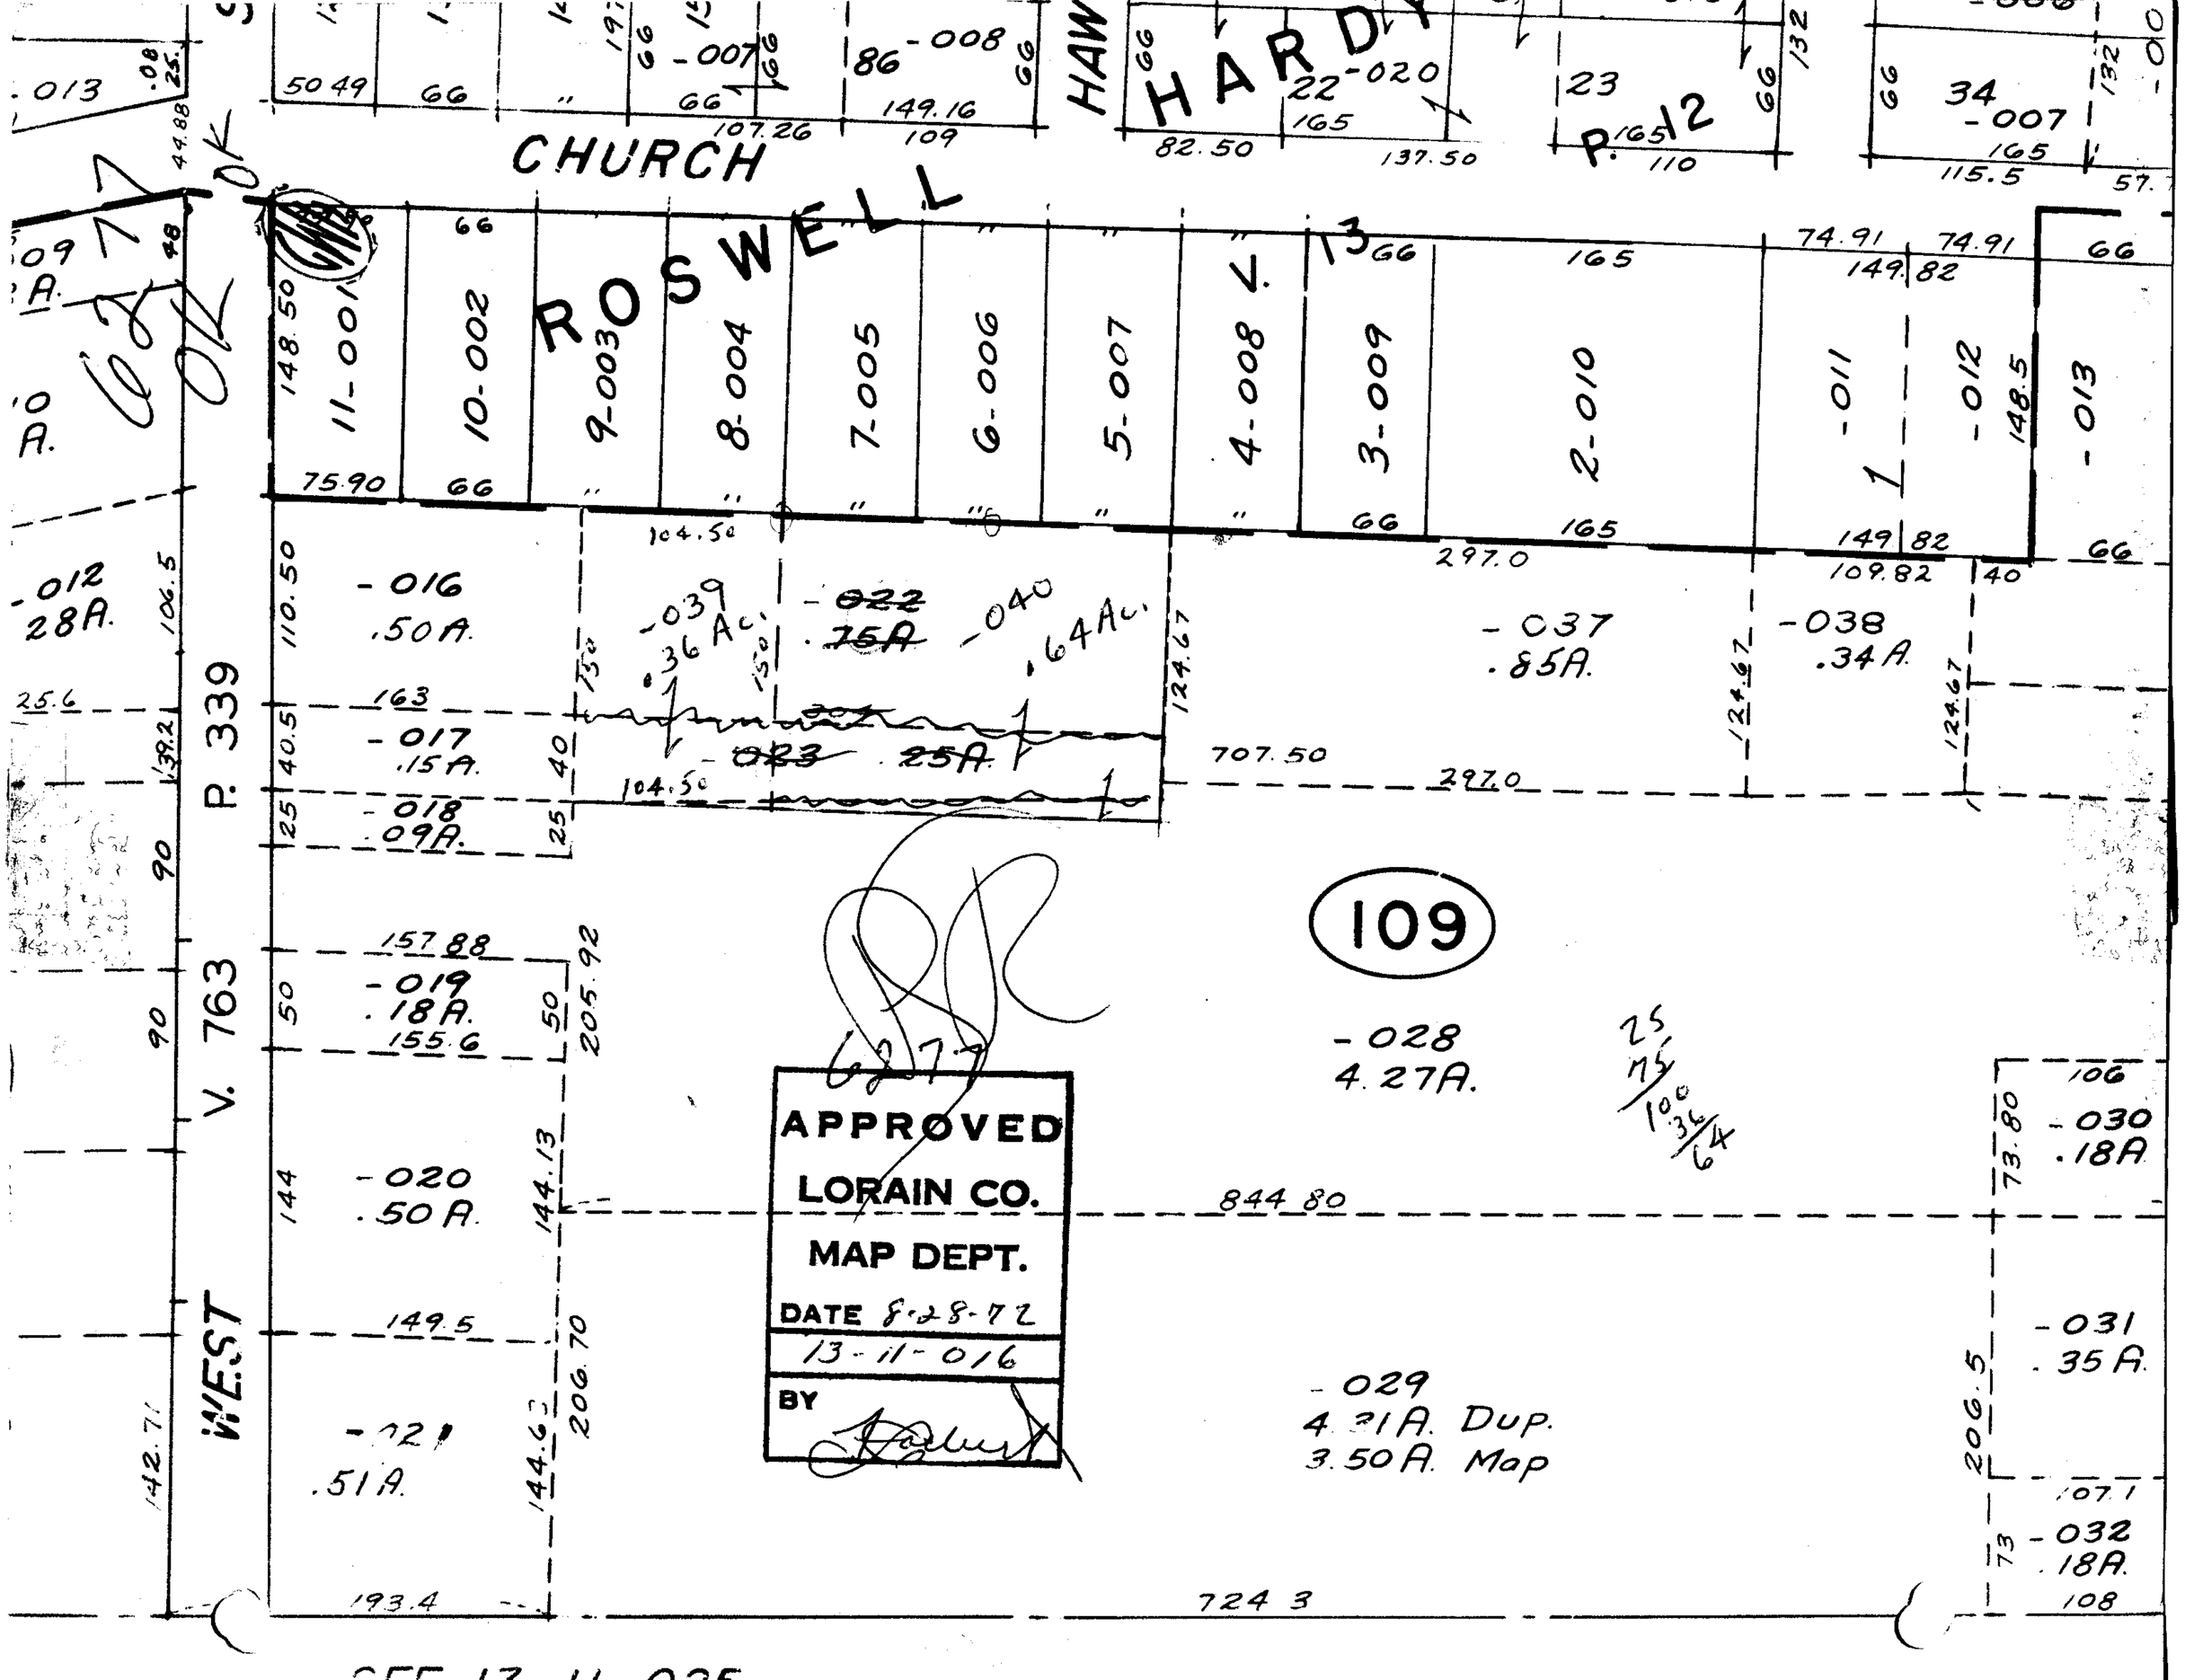

CHURCH
ROSWELL
HARDY
HAW
P. 12
V. 13
P. 339
V. 763
WEST
109
APPROVED
LORAIN CO.
MAP DEPT.
DATE 8-28-72
13-11-016
BY