


SEE 6-54

6280
OK

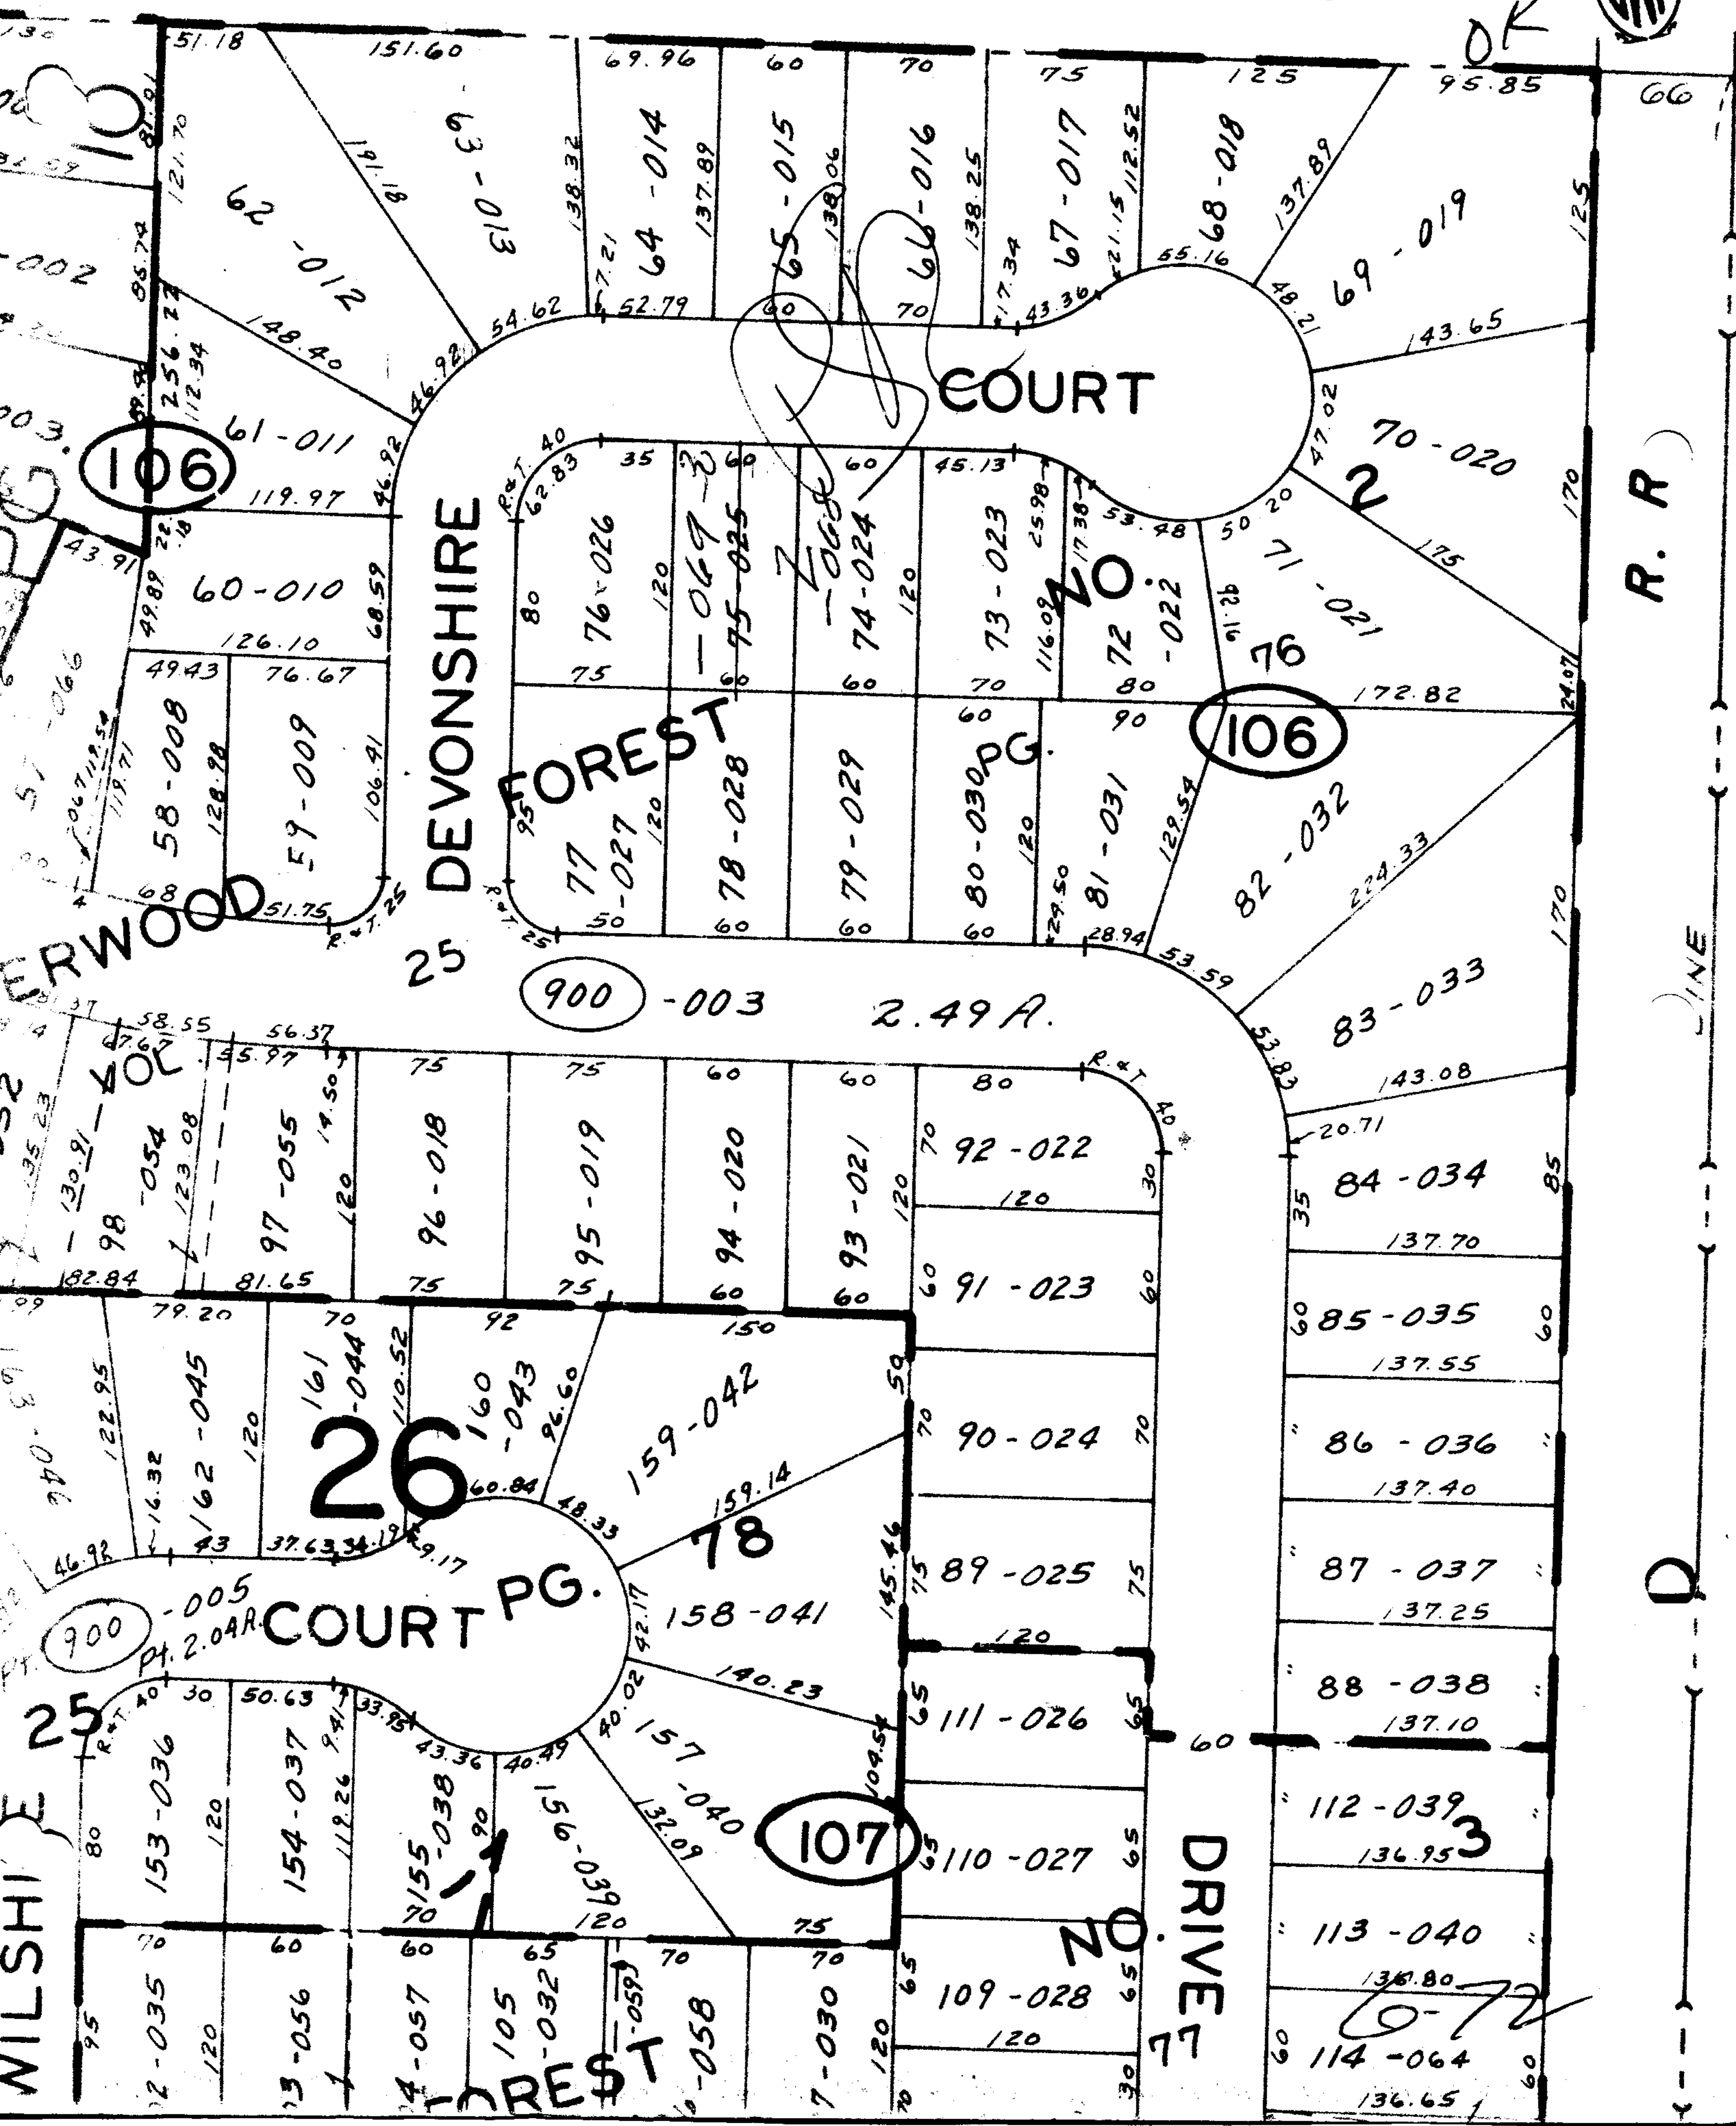

10

106

25 DEVONSHIRE

FOREST

COURT

106

900 -003

2.49 A.

26

COURT PG.

107

DRIVE

R. R.

LINE

D

WILSHIRE

6-72