


250-028

Comb  
-007  
2.45A.

101

6293

15 150  
13 100  
150  
43 33

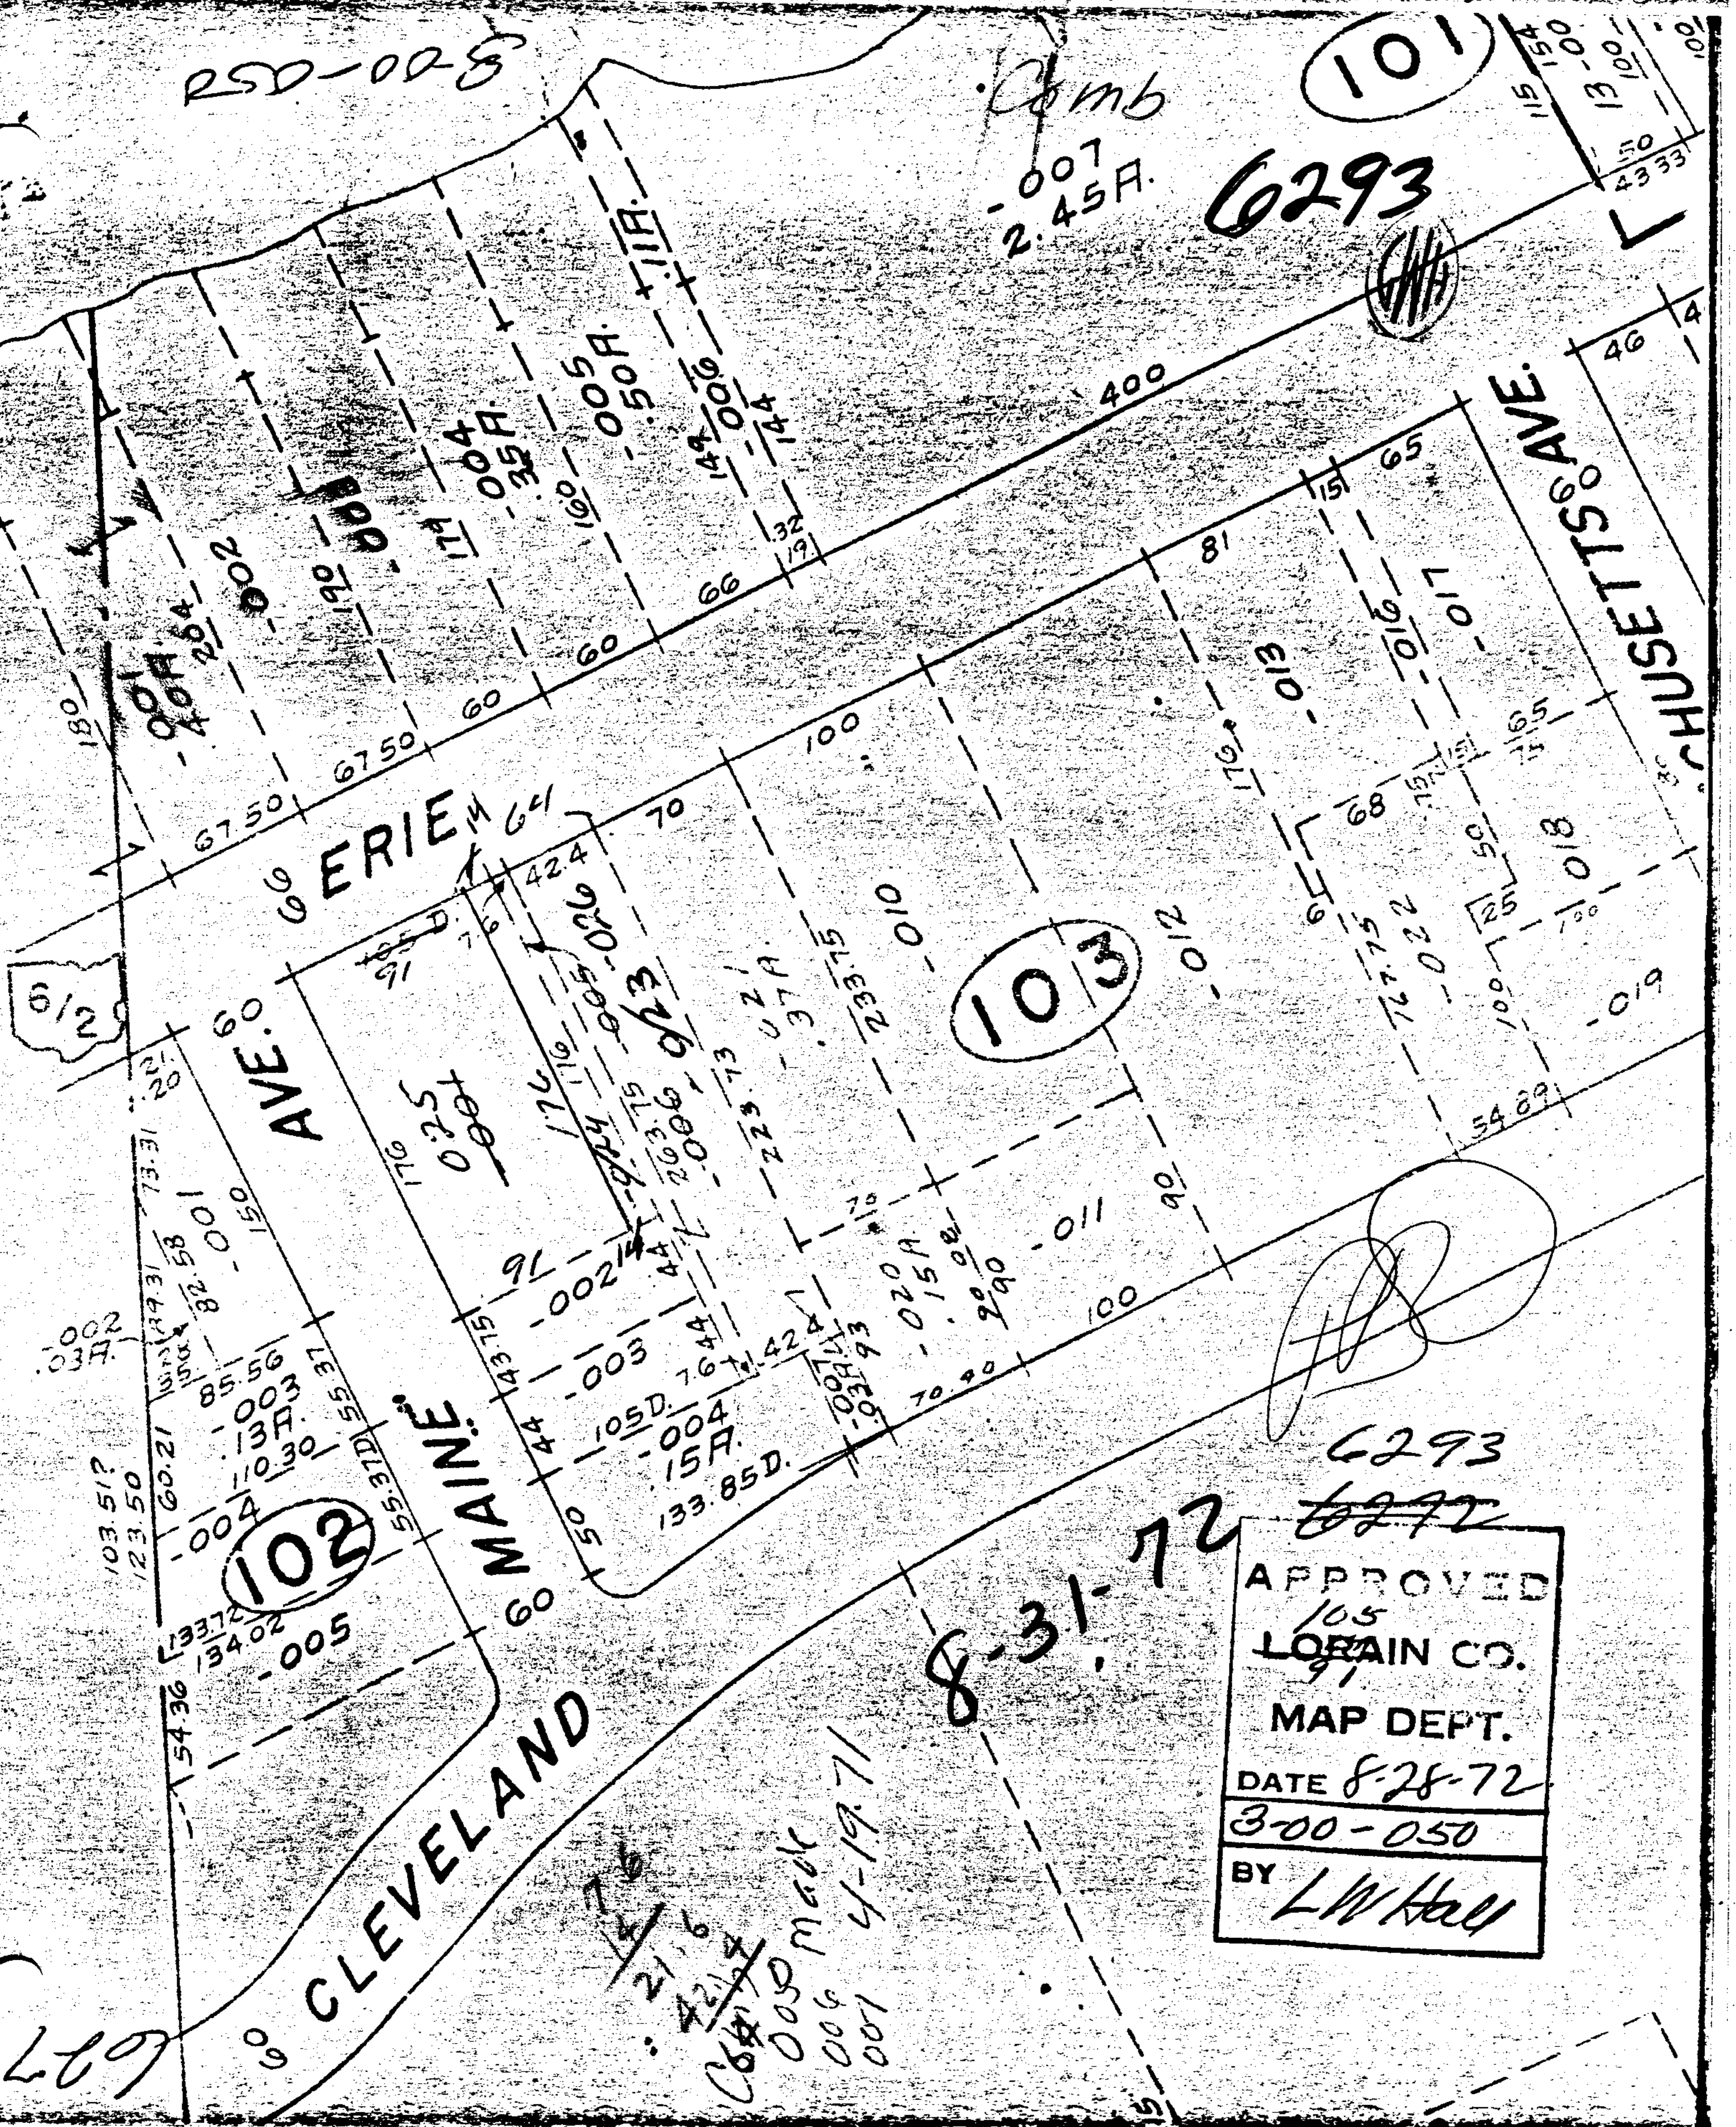

APPROVED  
 105  
 LORAIN CO.  
 91  
 MAP DEPT.  
 DATE 8-28-72  
 300-050  
 BY L.W. Hall