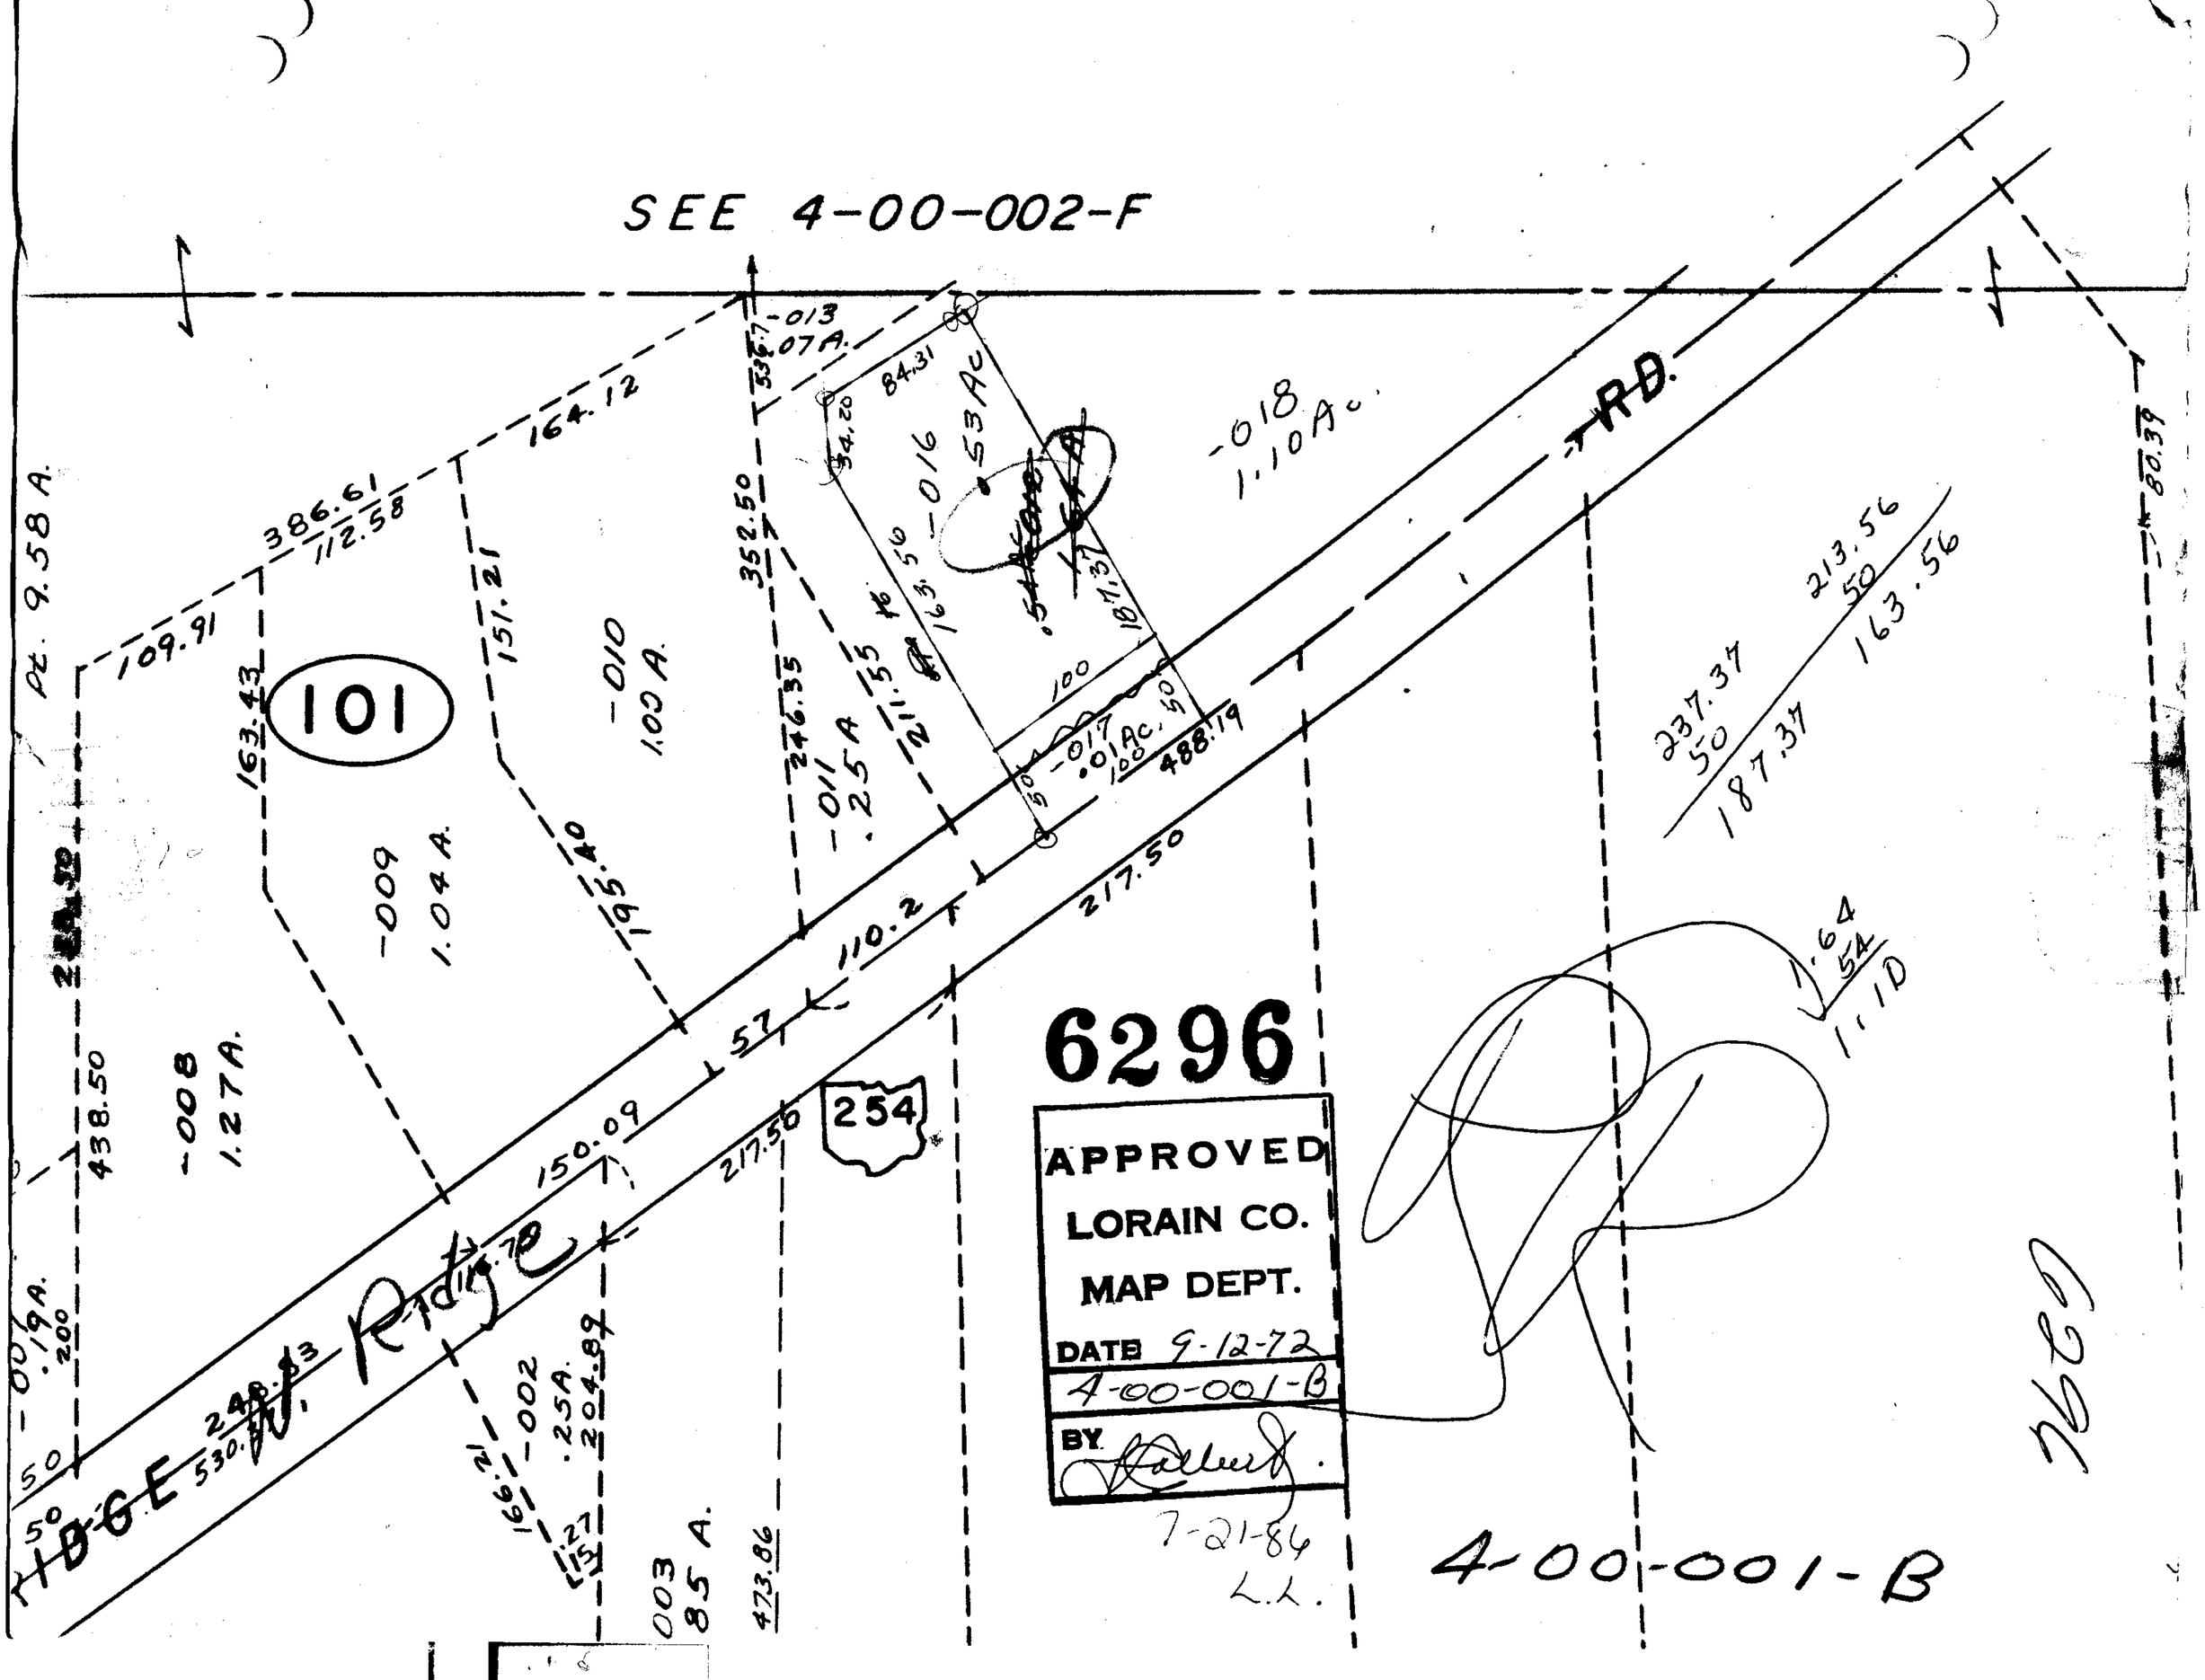
SEE 4-00-002-F
101
254
RD.
RIDGE
Ridge
-018
1.10 Ac.
-016
.53 Ac
-017
.01 Ac.
-010
1.00 A.
-009
1.04 A.
-008
1.27 A.
-002
.25 A.
-003
85 A.
-013
.07 A.
-011
.25 A
-019
.19 A.
Pt. 9.58 A.
386.61
112.58
109.91
164.12
163.43
151.21
195.40
352.50
246.35
211.55
84.31
34.20
163.56
187.37
100
50
488.19
217.50
110.2
57
150.09
217.50
438.50
248.83
530.
166.21
204.89
473.86
237.37
50
187.37
213.56
50
163.56
80.39
1.64
54
1.10
6296
APPROVED
LORAIN CO.
MAP DEPT.
DATE 9-12-72
4-00-001-B
BY
7-21-84
L.L.
4-00-001-B
6296