


SEE

6299

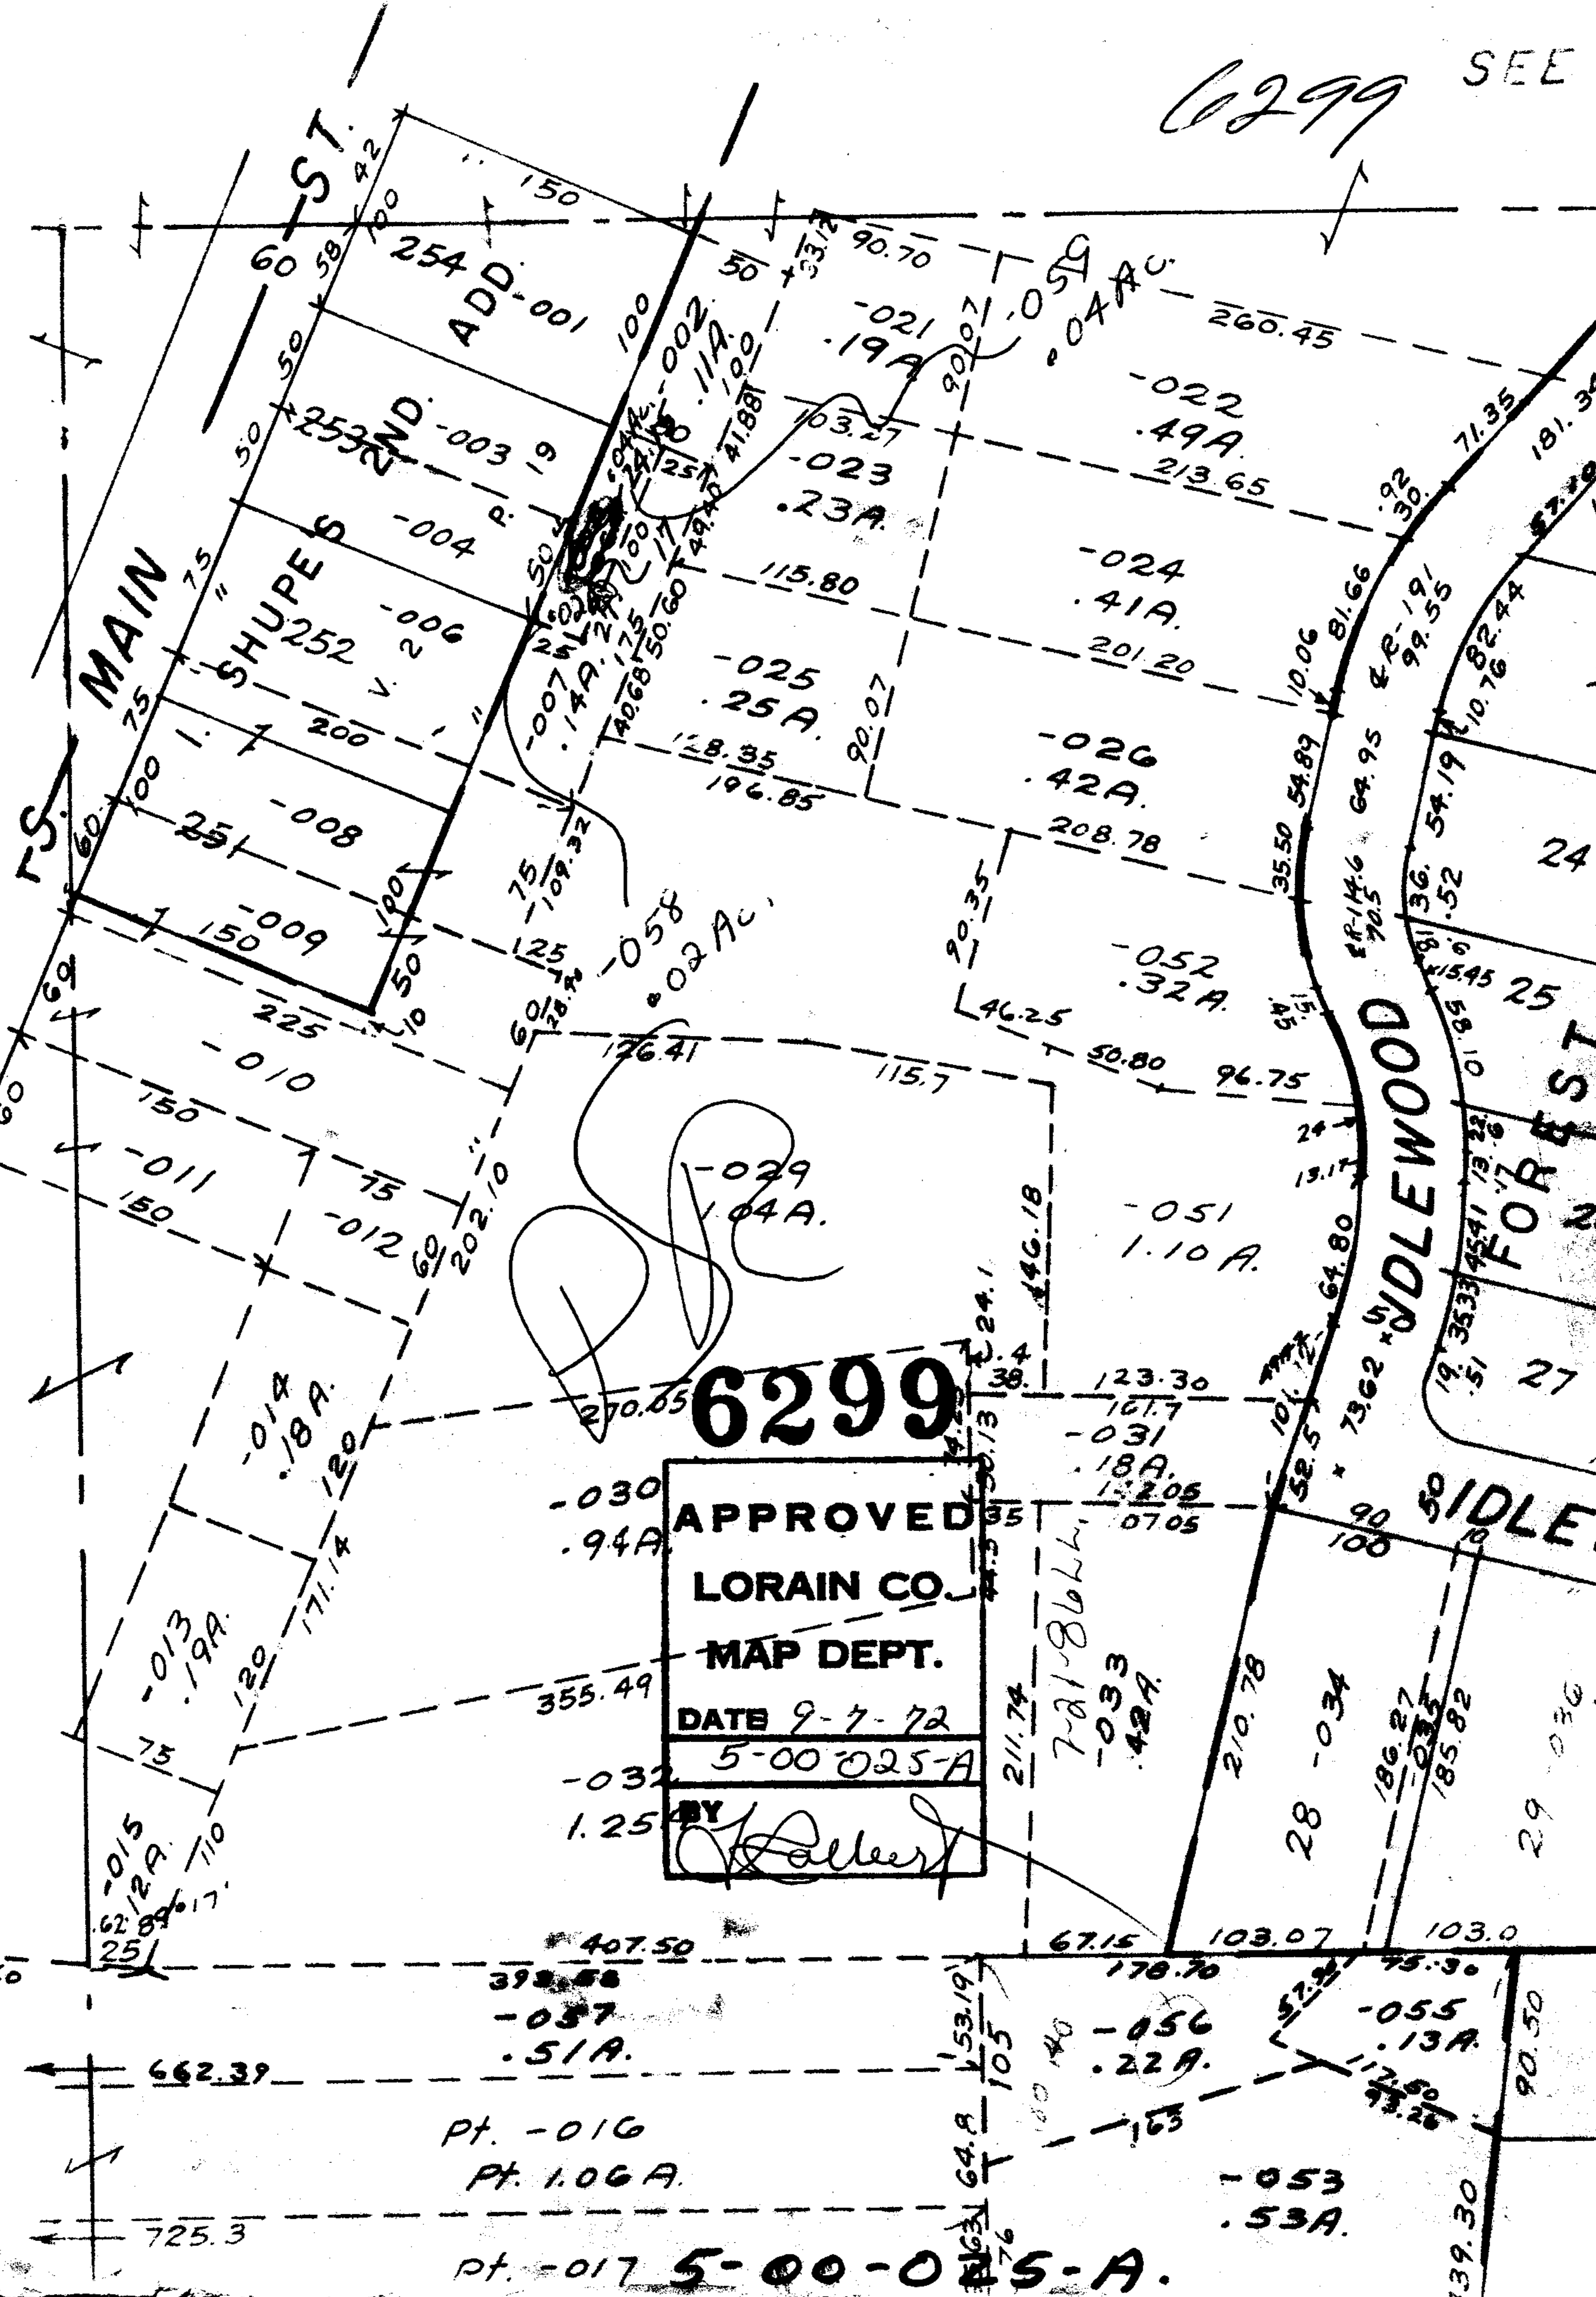

5-B