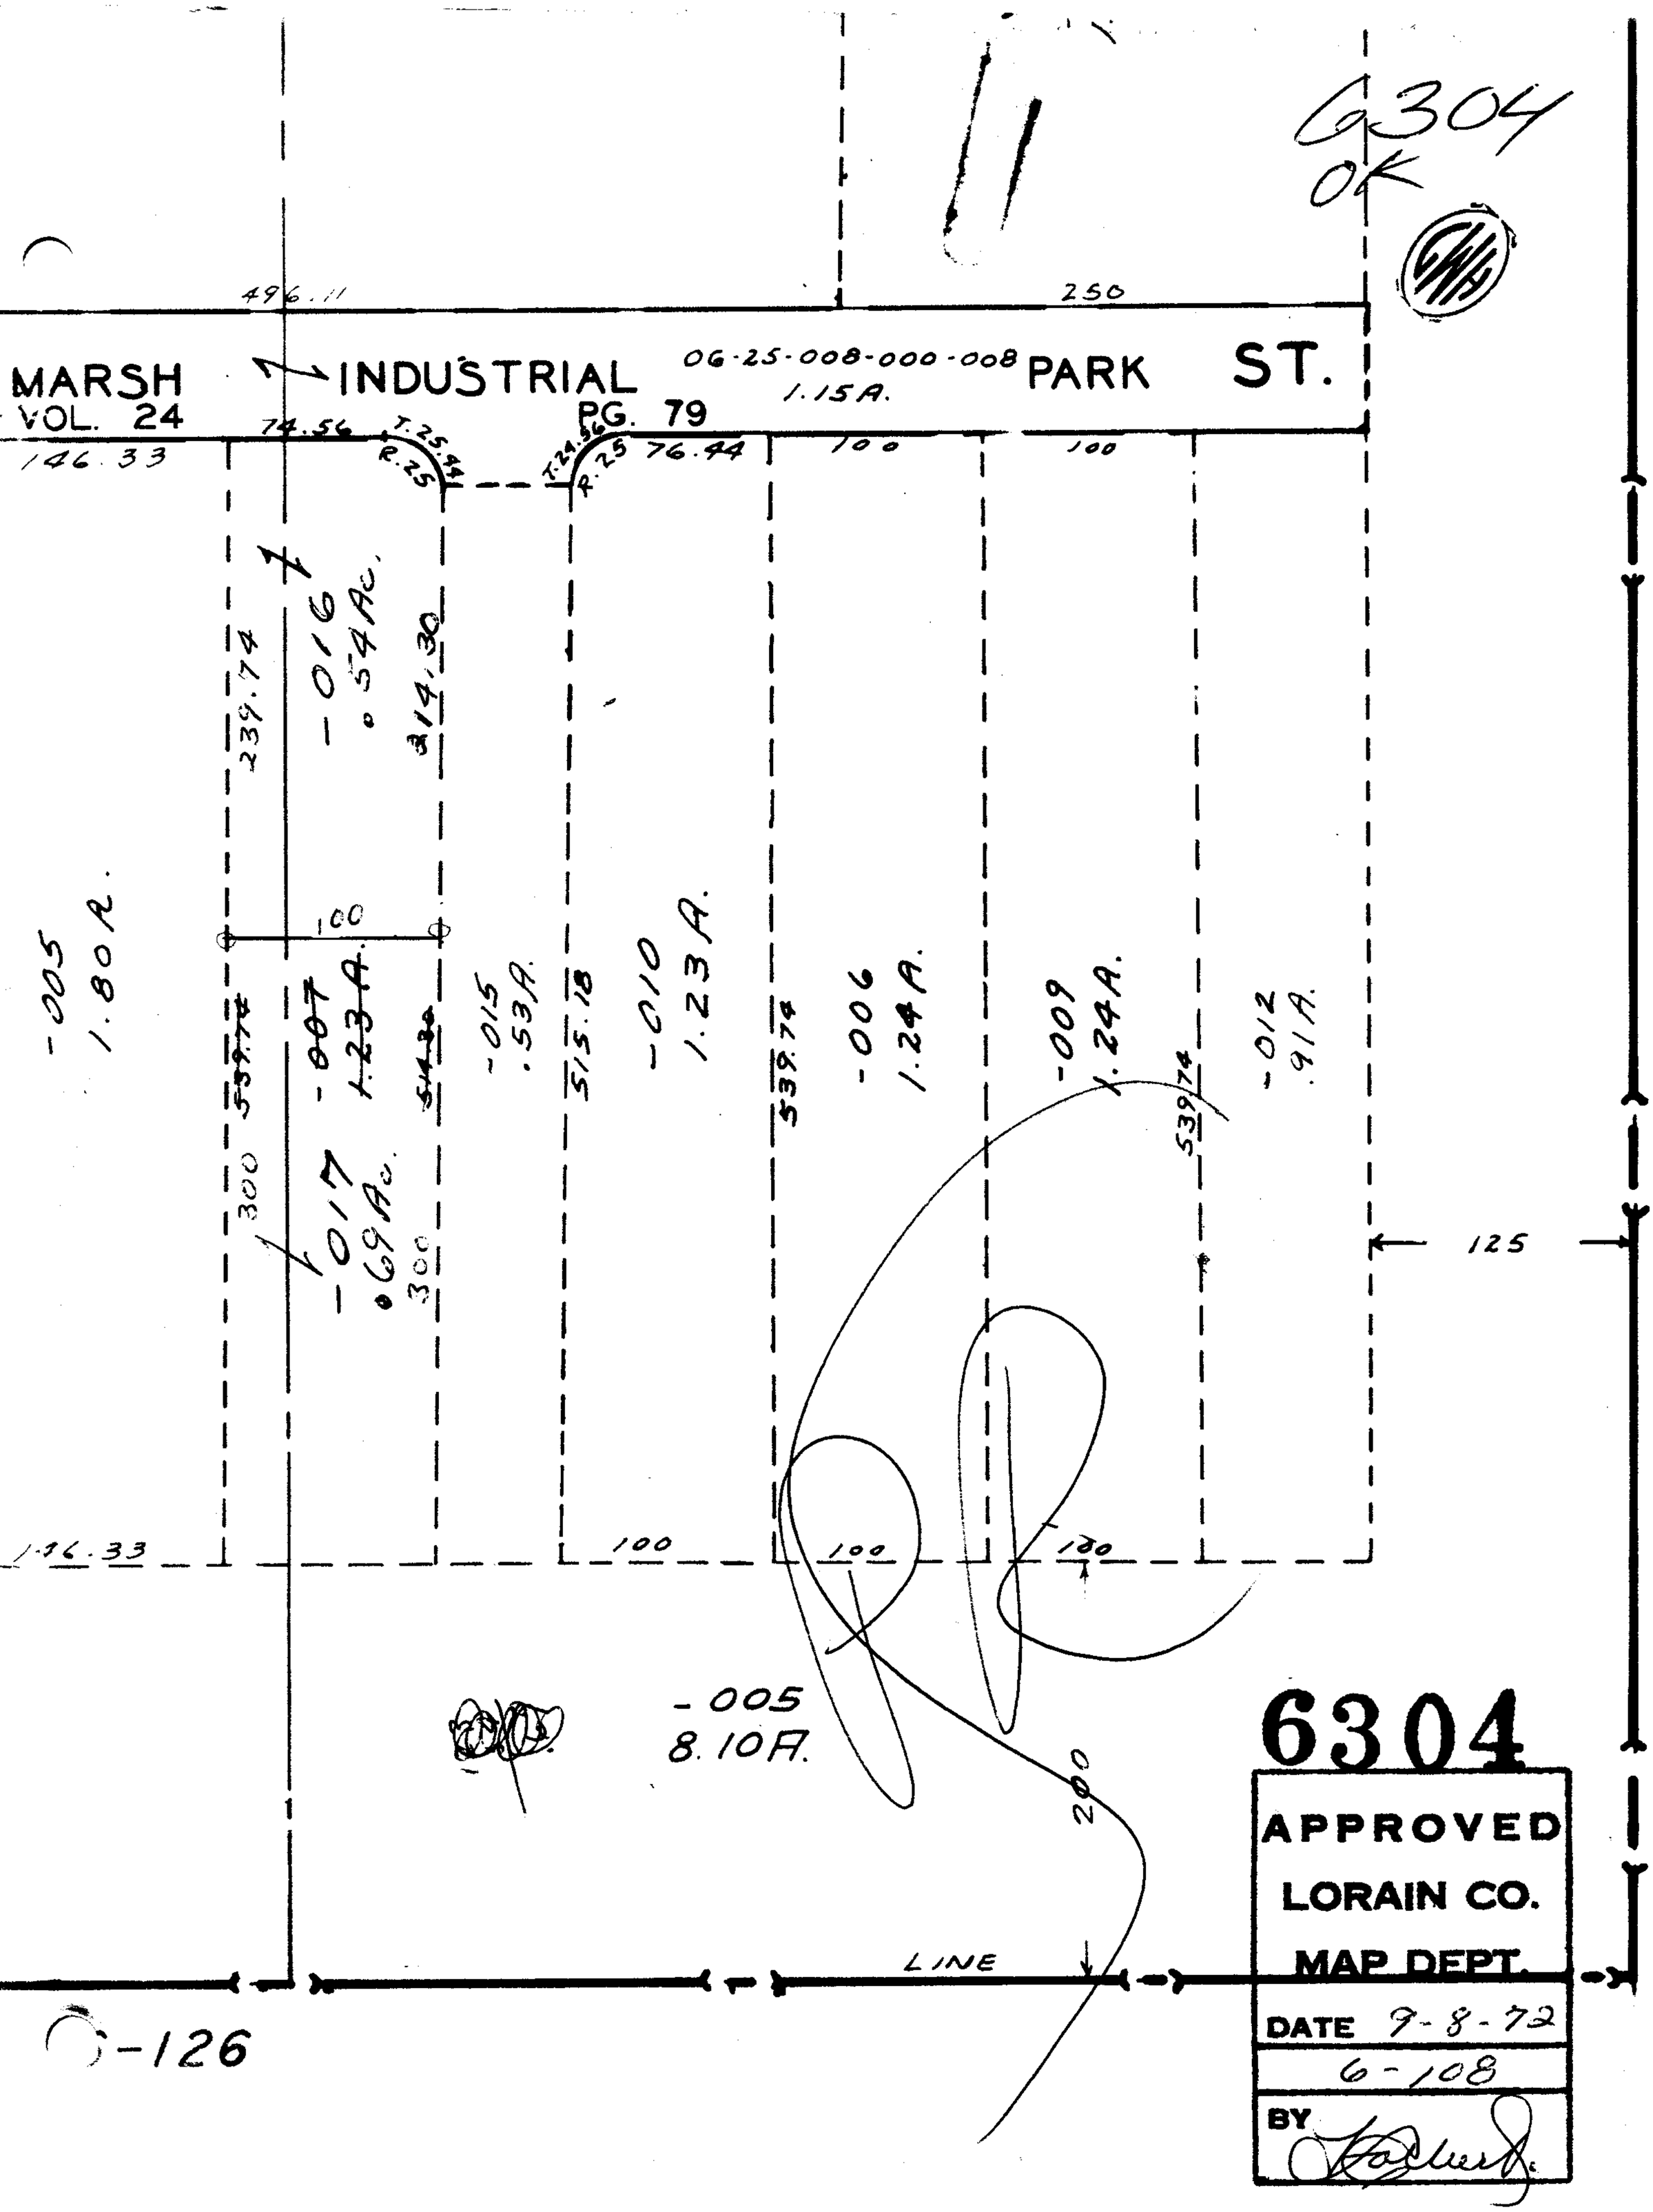
6304
OK
496.11
250
MARSH
VOL. 24
INDUSTRIAL
PG. 79
06-25-008-000-008
1.15A.
PARK
ST.
146.33
74.56
T.25.44
R.25
T.24.56
R.25
76.44
100
100
239.74
-016
.54Ac.
314.30
100
-005
1.80A.
539.74
-007
1.23A.
514.30
-015
.53A.
515.18
-010
1.23A.
539.74
-006
1.24A.
-009
1.24A.
539.74
-012
.91A.
300
-017
.69Ac.
300
125
146.33
100
100
100
-005
8.10A.
200
LINE
APPROVED
LORAIN CO.
MAP DEPT.
DATE 9-8-72
6-108
BY
-126