


6305
OK 

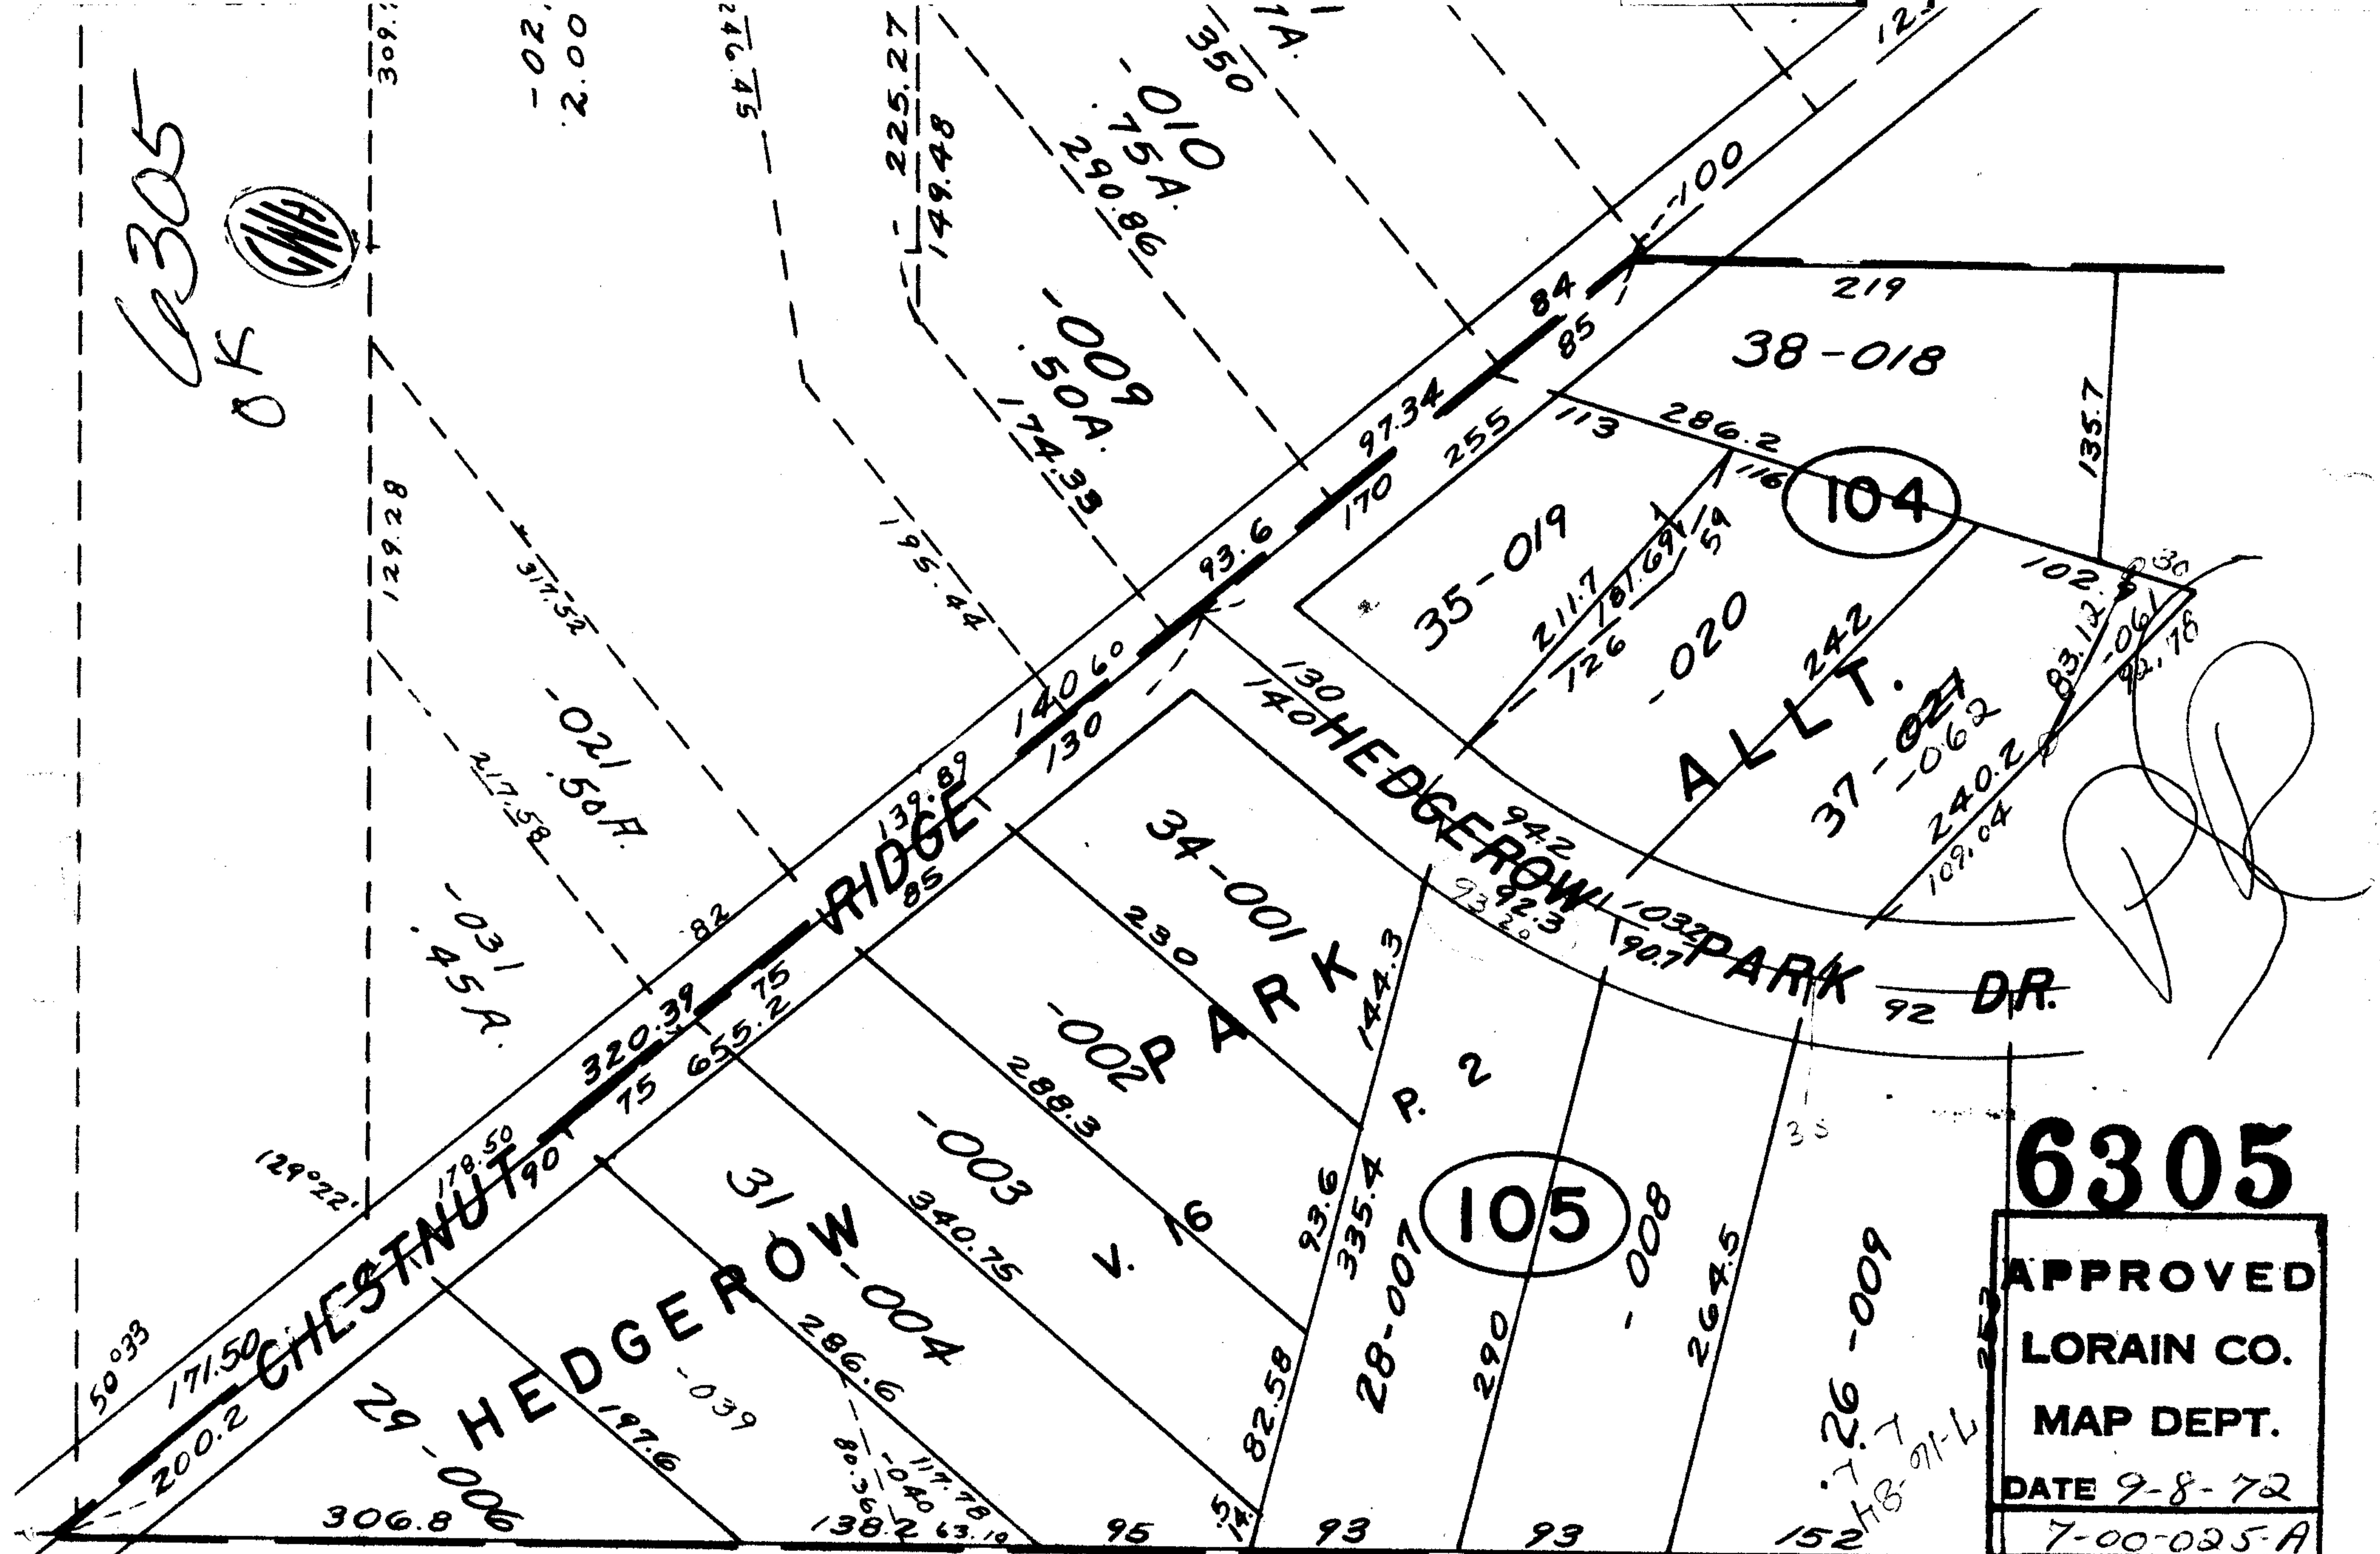

6305
APPROVED
LORAIN CO.
MAP DEPT.
DATE 9-8-72
7-00-025-A
BY *[Signature]*

7-00-025-A