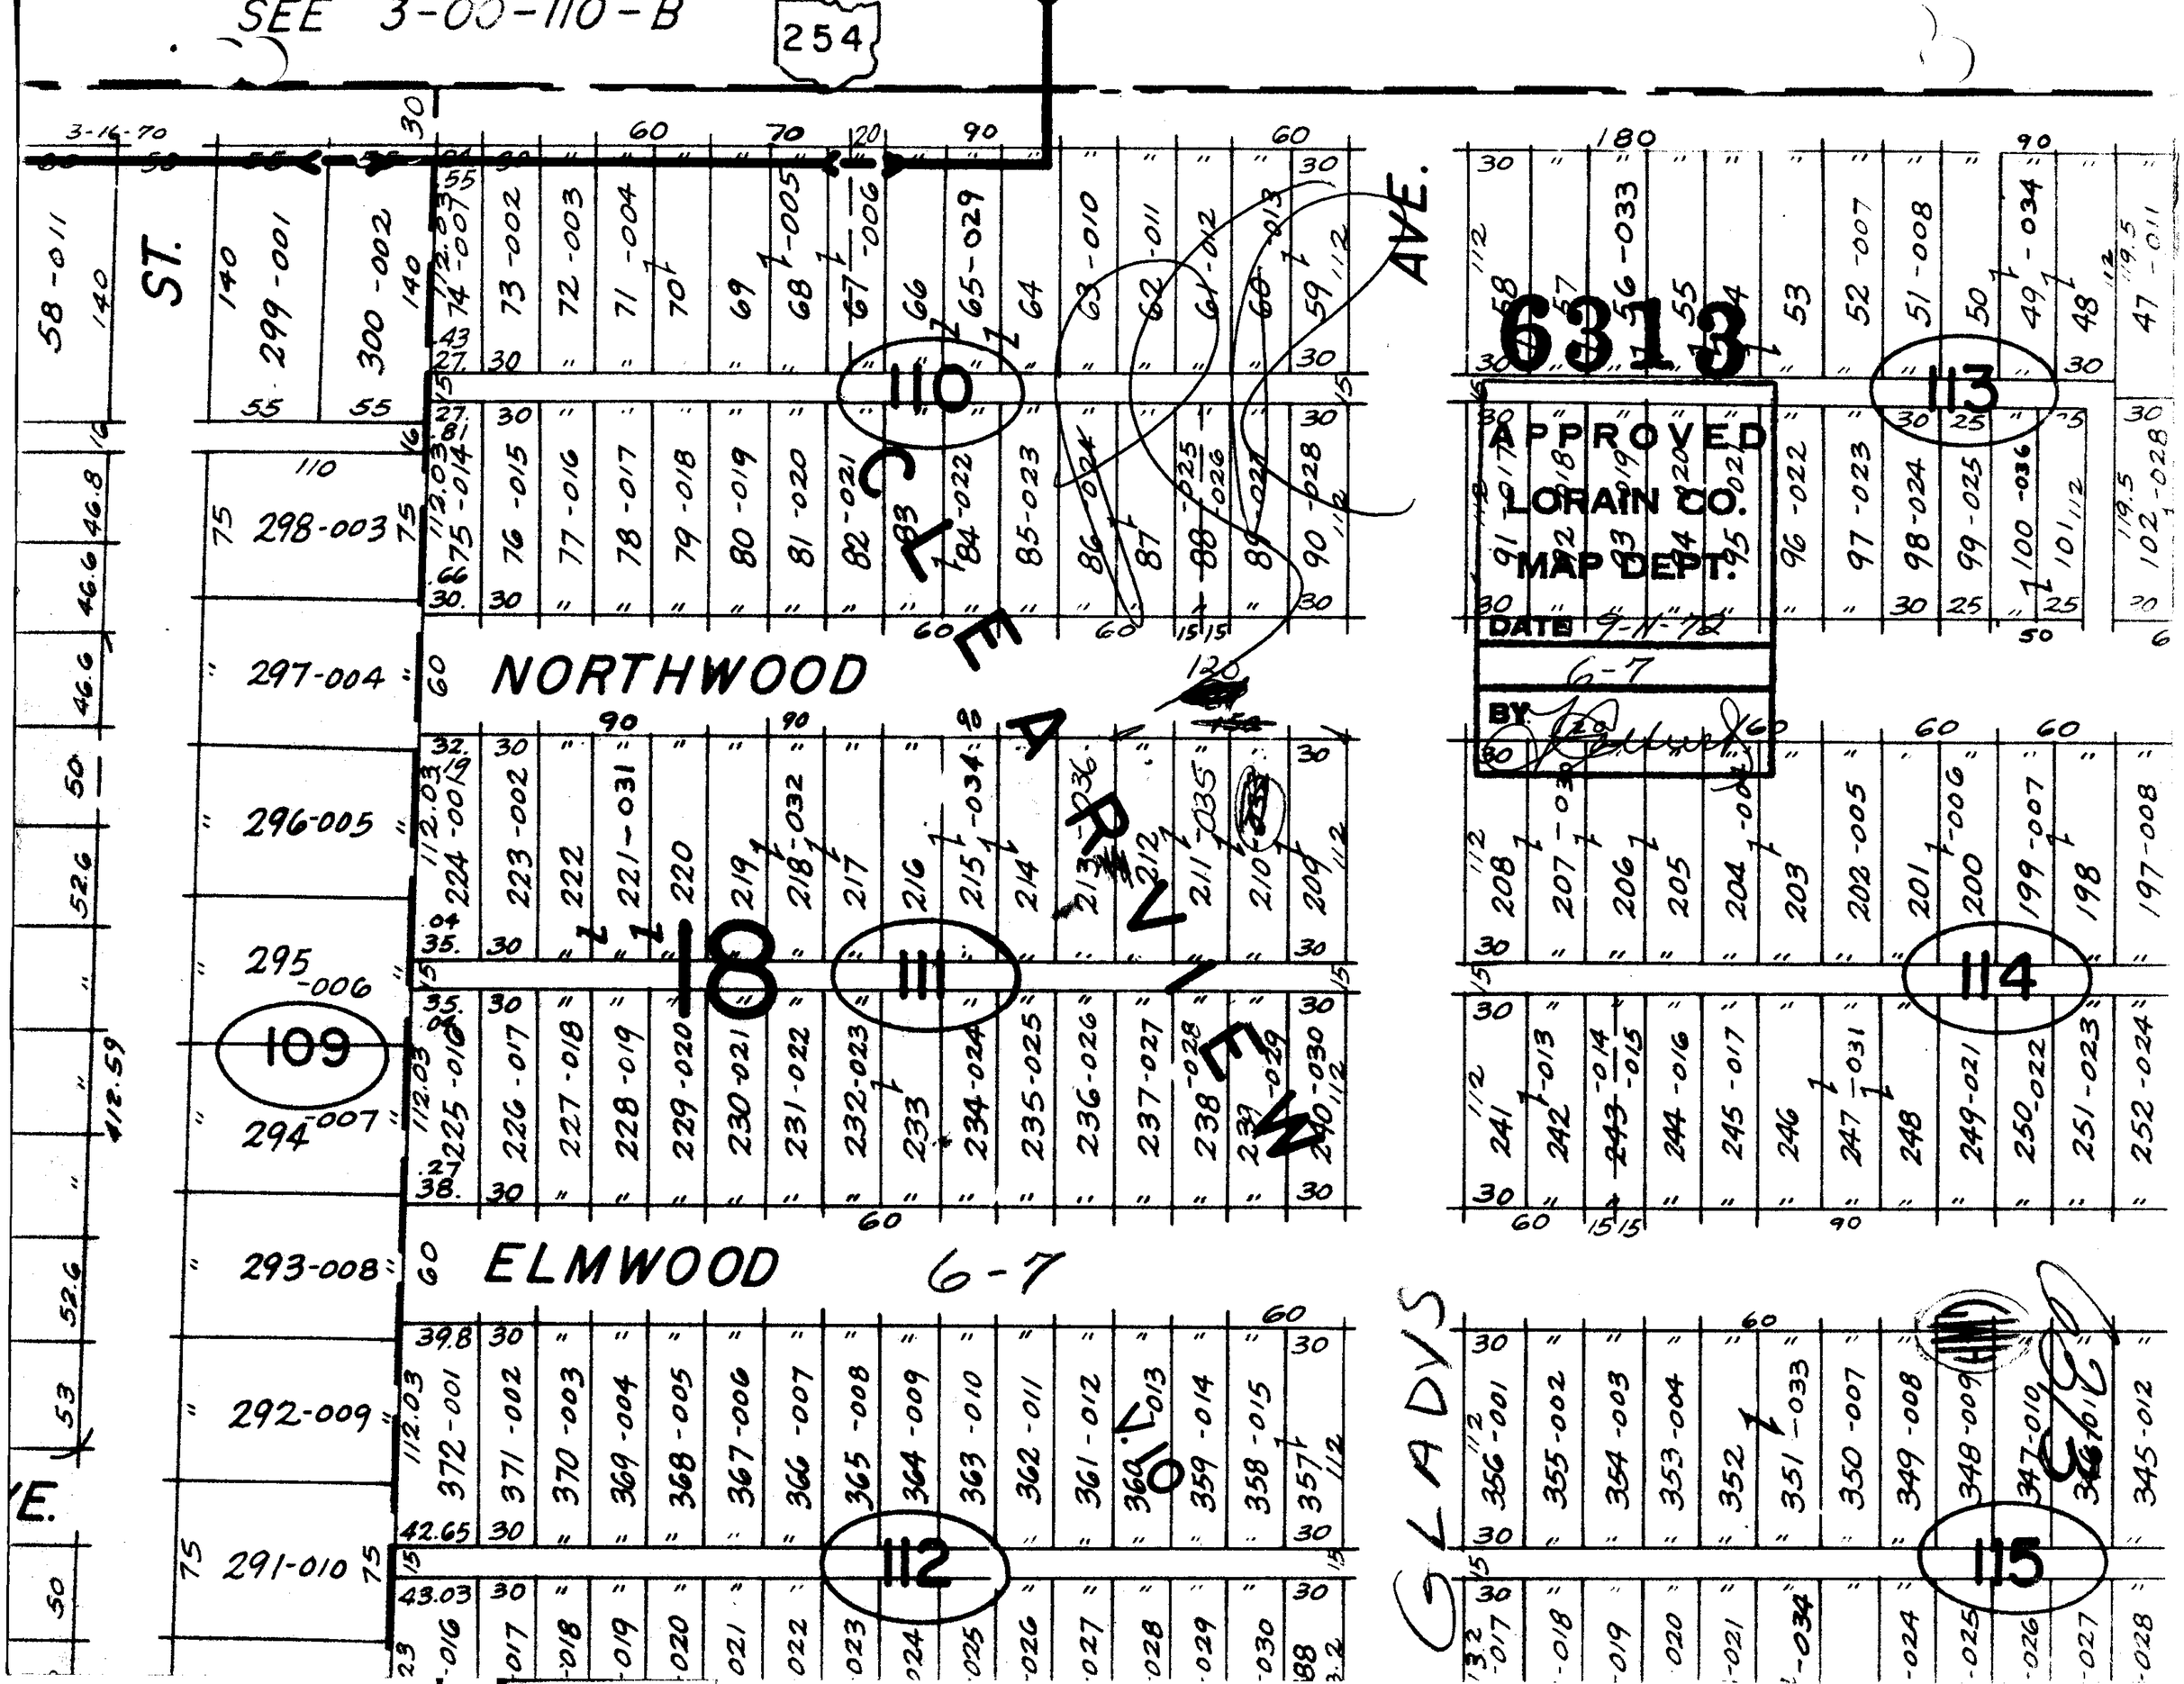

SEE 3-00-110-B
254
ST.
AVE.
CLEARVIEW
NORTHWOOD
ELMWOOD
GLADYS
6313
APPROVED
LORAIN CO.
MAP DEPT.
DATE 9-11-72
6-7
BY
110
111
112
113
114
115
109
18