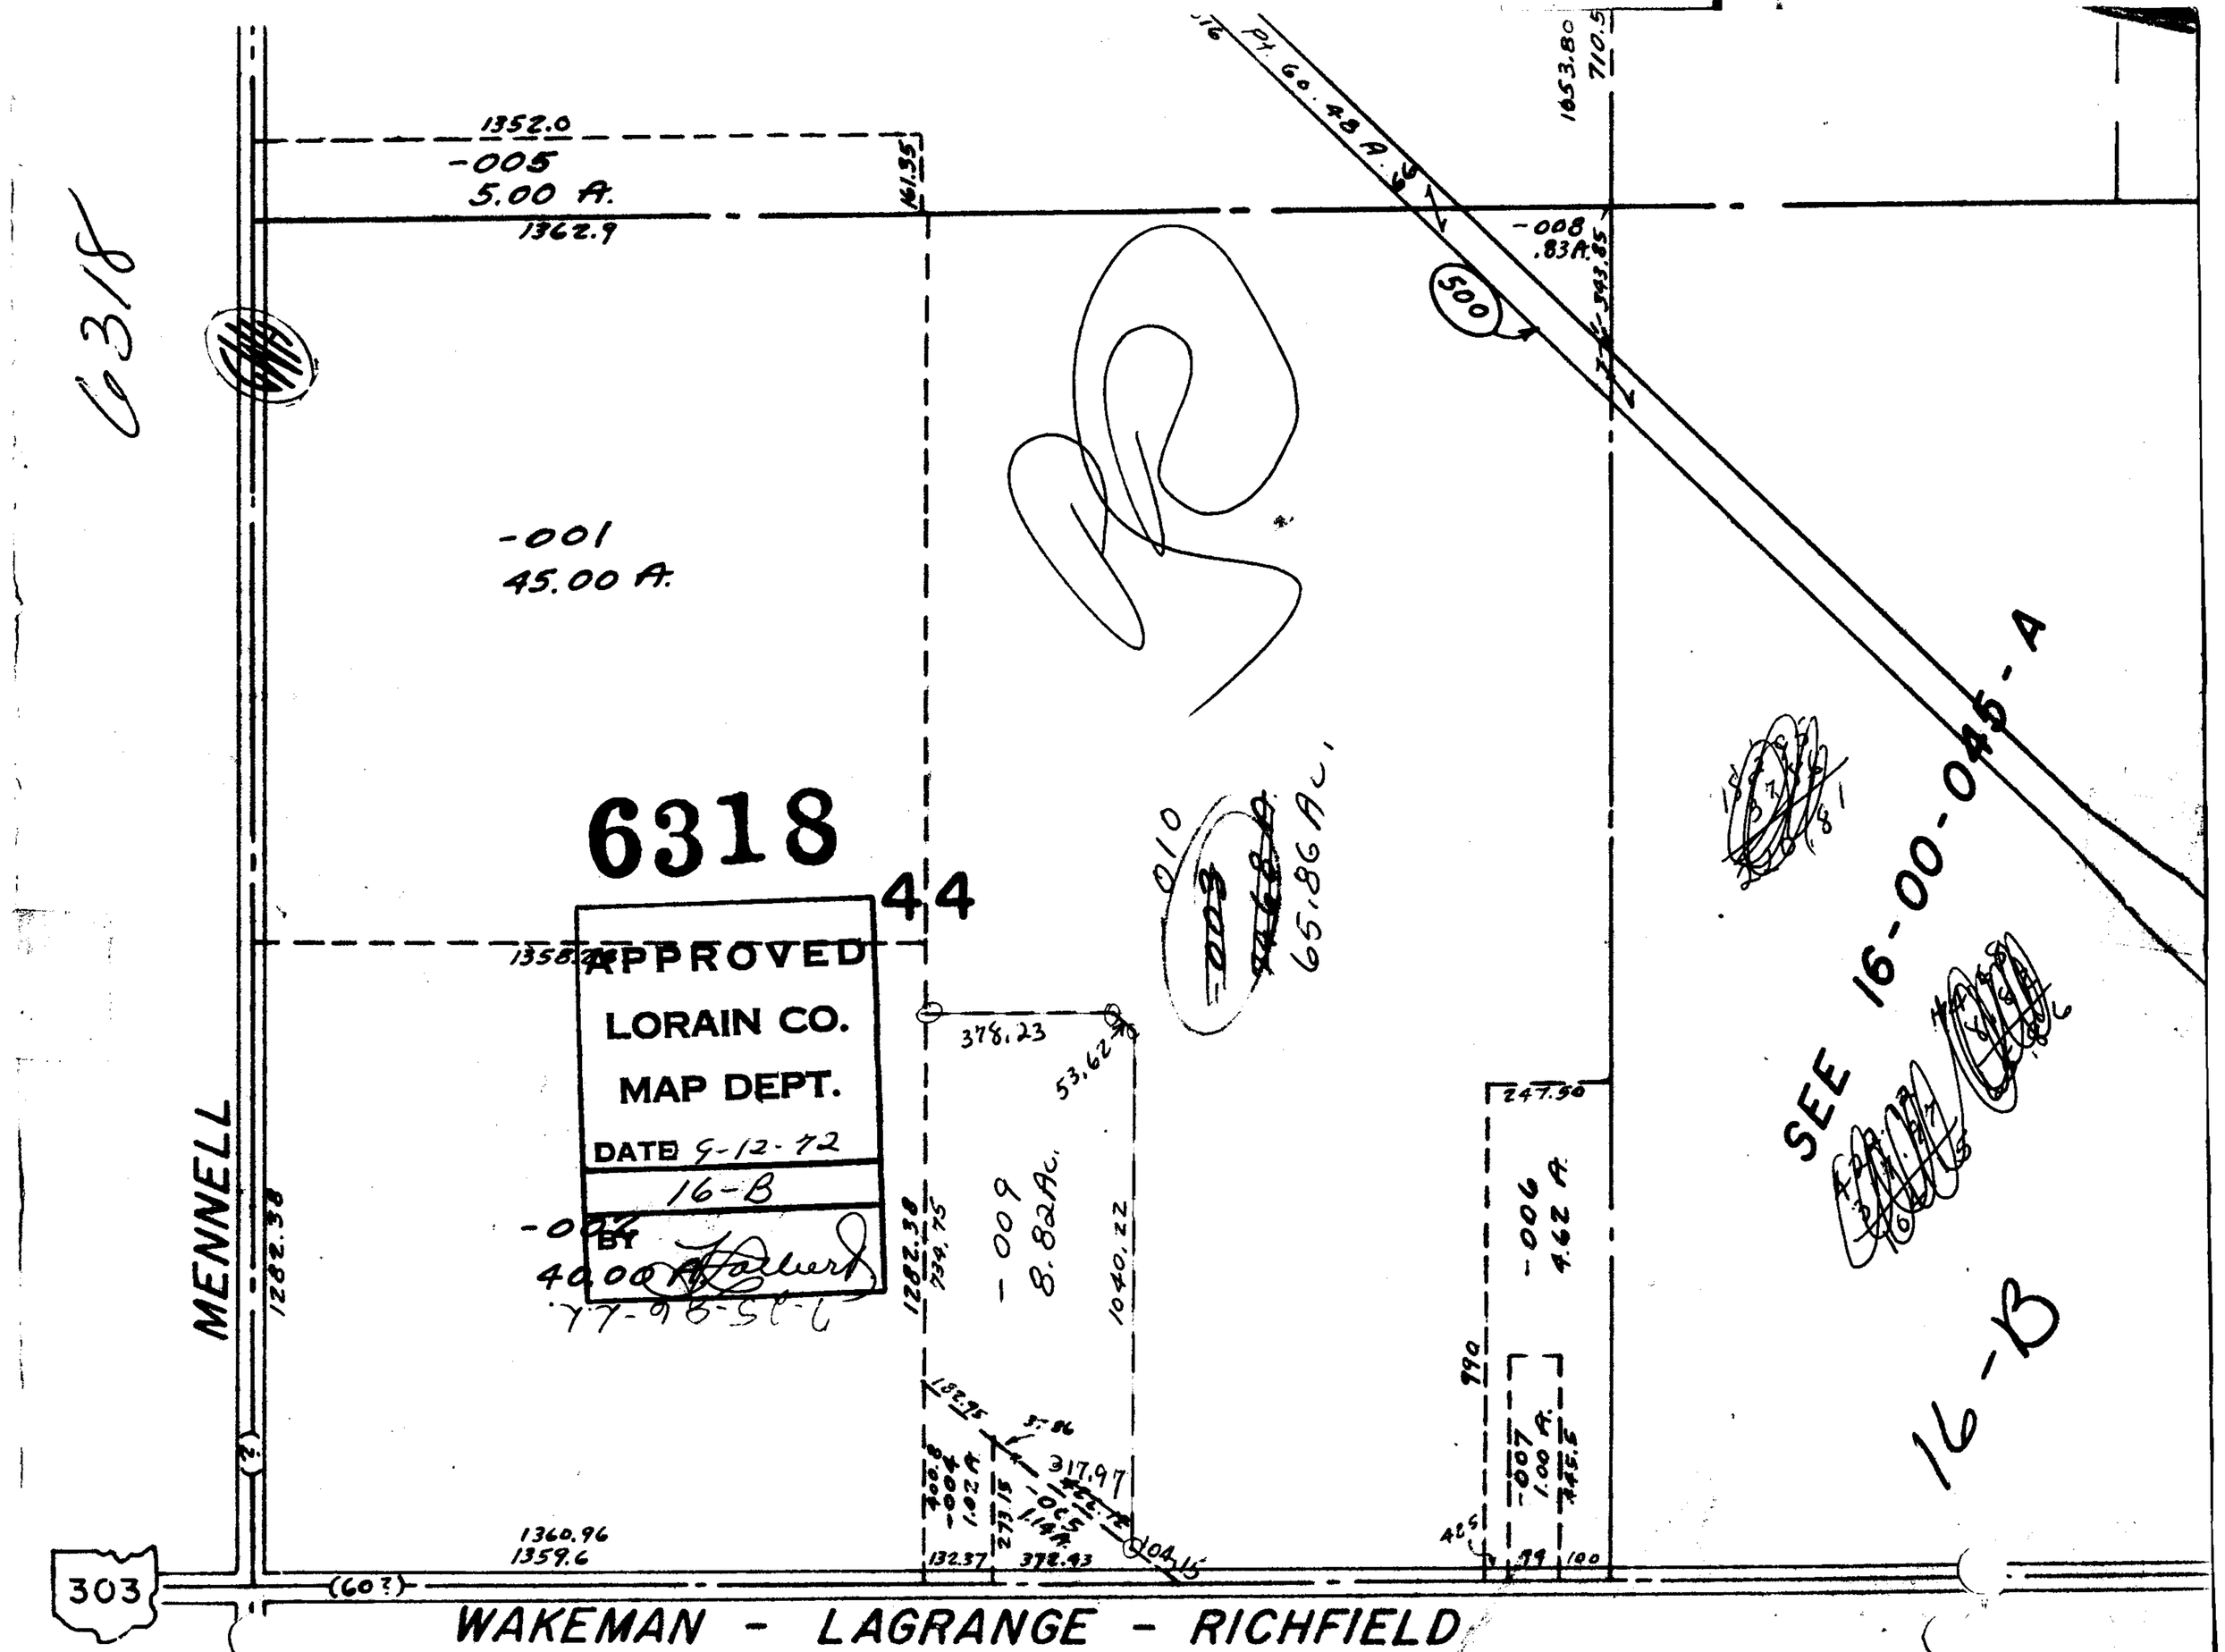
6318
1352.0
-005
5.00 A.
1362.9
161.35
-001
45.00 A.
6318
44
APPROVED
LORAIN CO.
MAP DEPT.
DATE 9-12-72
16-B
BY
-002
40.00 A.
77-98-5C-6
1358.
MENNELL
1282.38
1360.96
1359.6
303
(60?)
WAKEMAN - LAGRANGE - RICHFIELD
378.23
53.62
-009
8.82 Ac.
1040.22
1282.38
734.75
317.97
132.37
372.43
104.15
-010
-003
65.86 Ac.
Pt. 60.48 A.
500
-008
.83 A.
343.85
1653.80
710.5
247.50
-006
4.62 A.
990
-007
1.00 A.
445.5
425
99
100
SEE 16-00-045-A
16-B