

IAIE

90

12


016
3.85 R

6328
OK



15
102

430 23
430 05

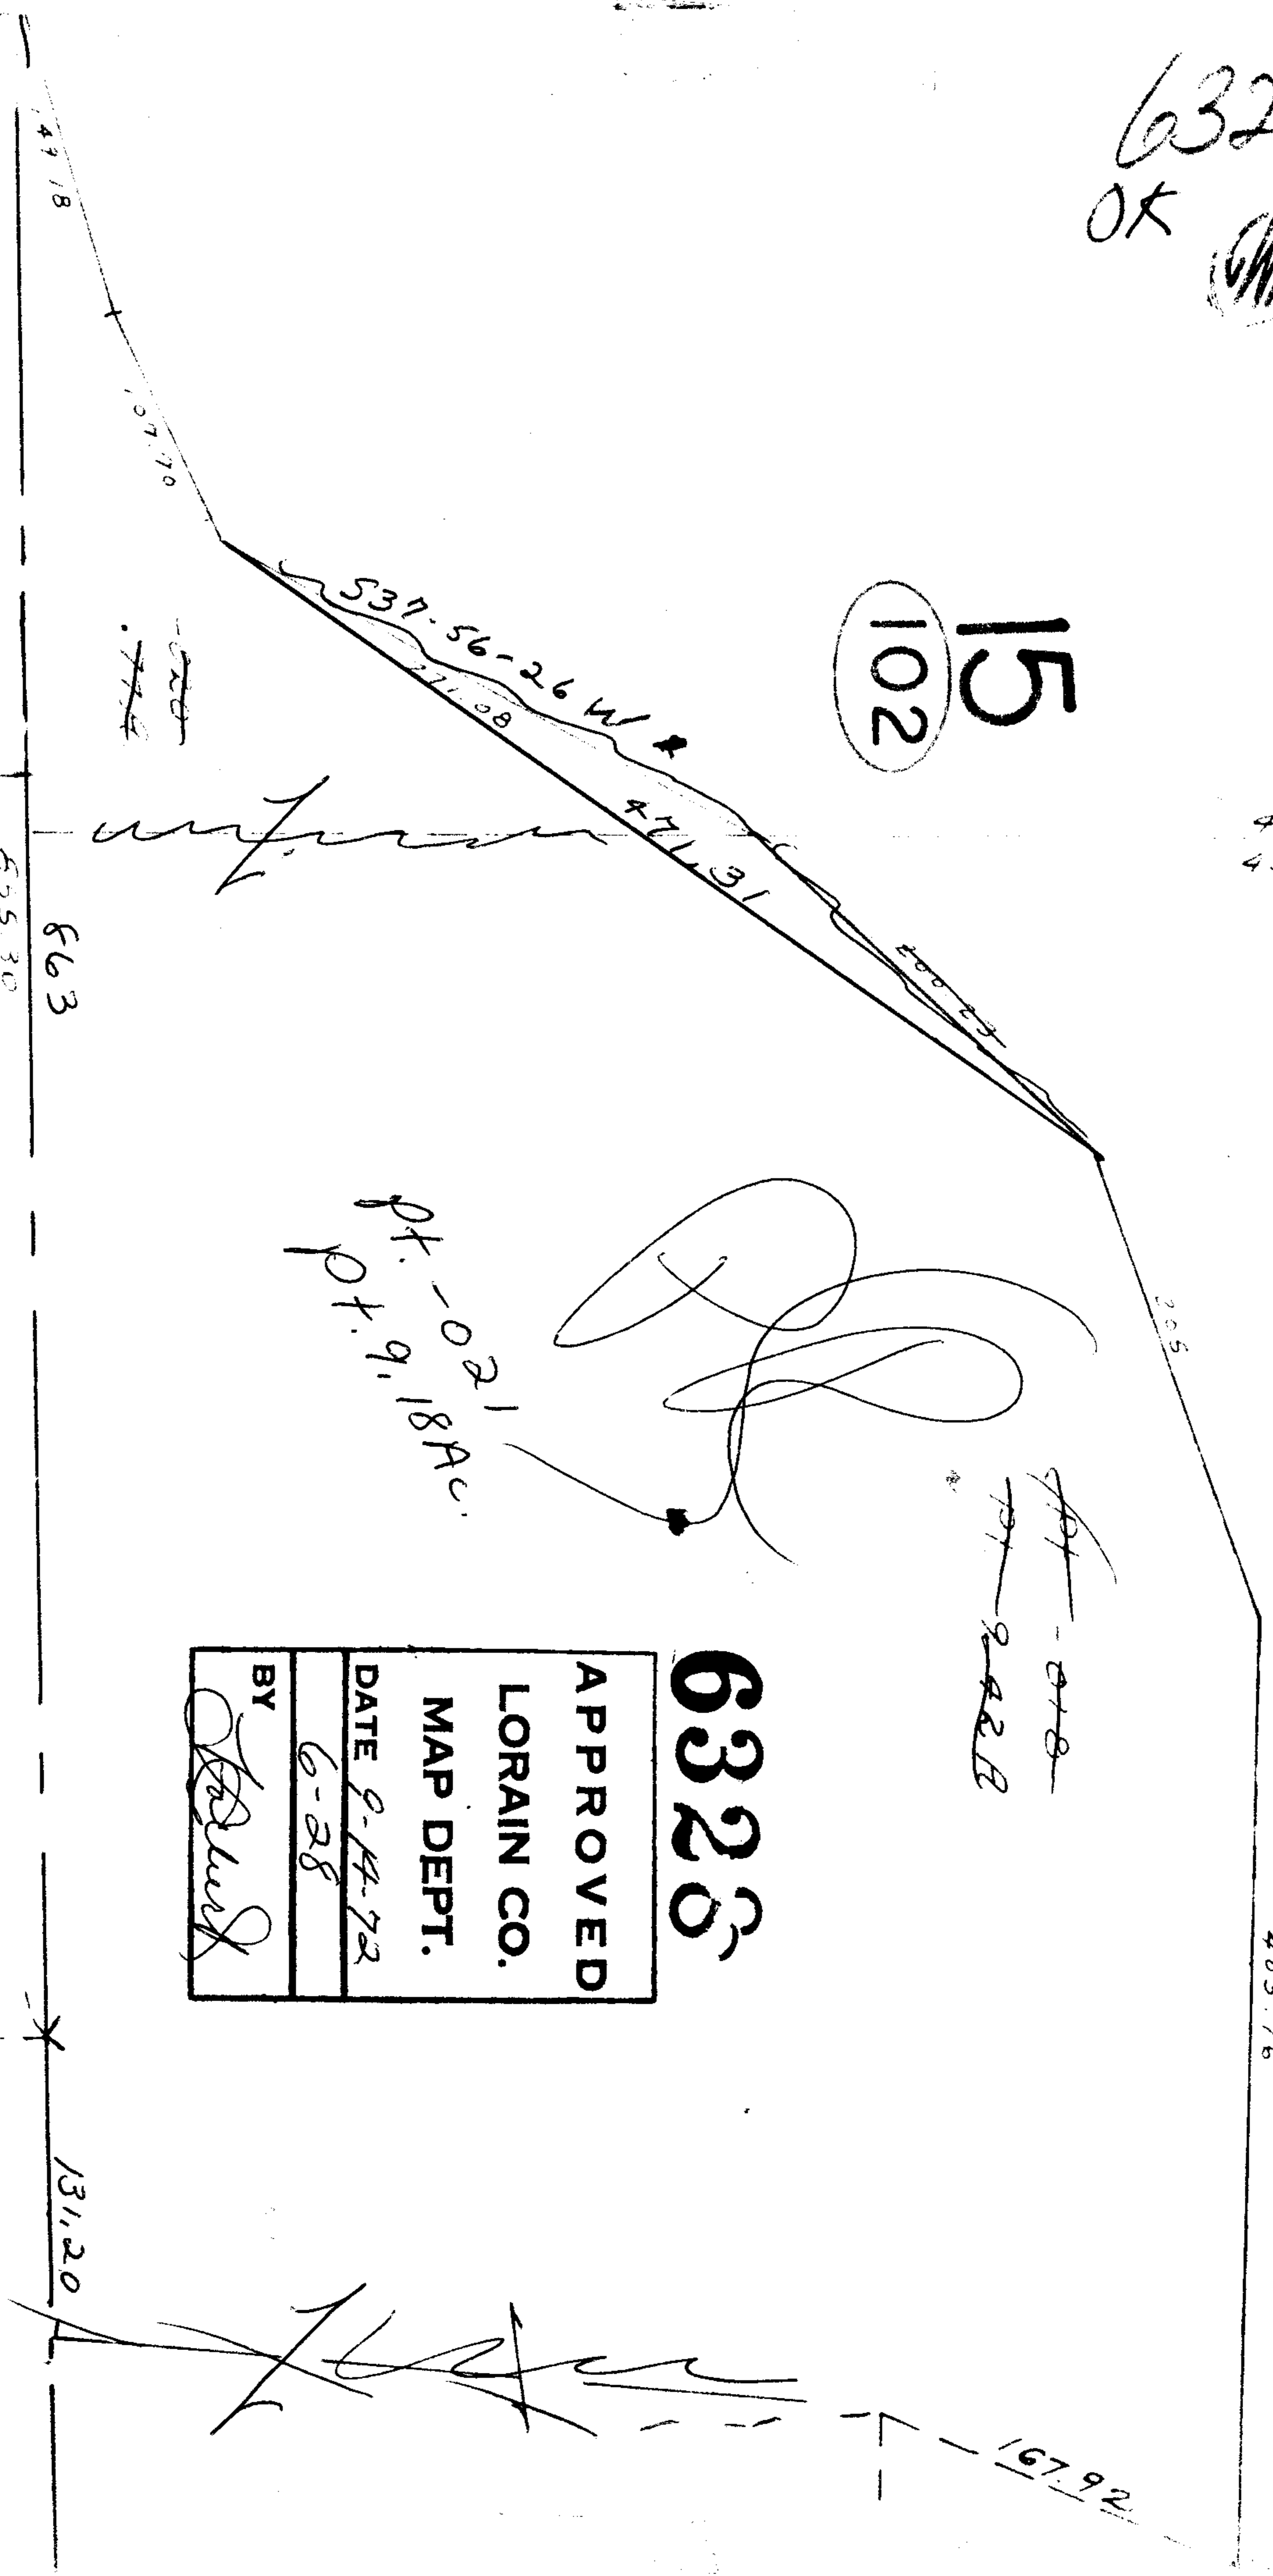

9-13
10/1/81

pt. -021
pt. 9, 18 AC

~~PT -018~~
~~PT 242B~~

APPROVED
LORAIN CO.
MAP DEPT.
DATE 8-14-72
6-28
BY <i>[Signature]</i>

6328

07-017
00 602A

2