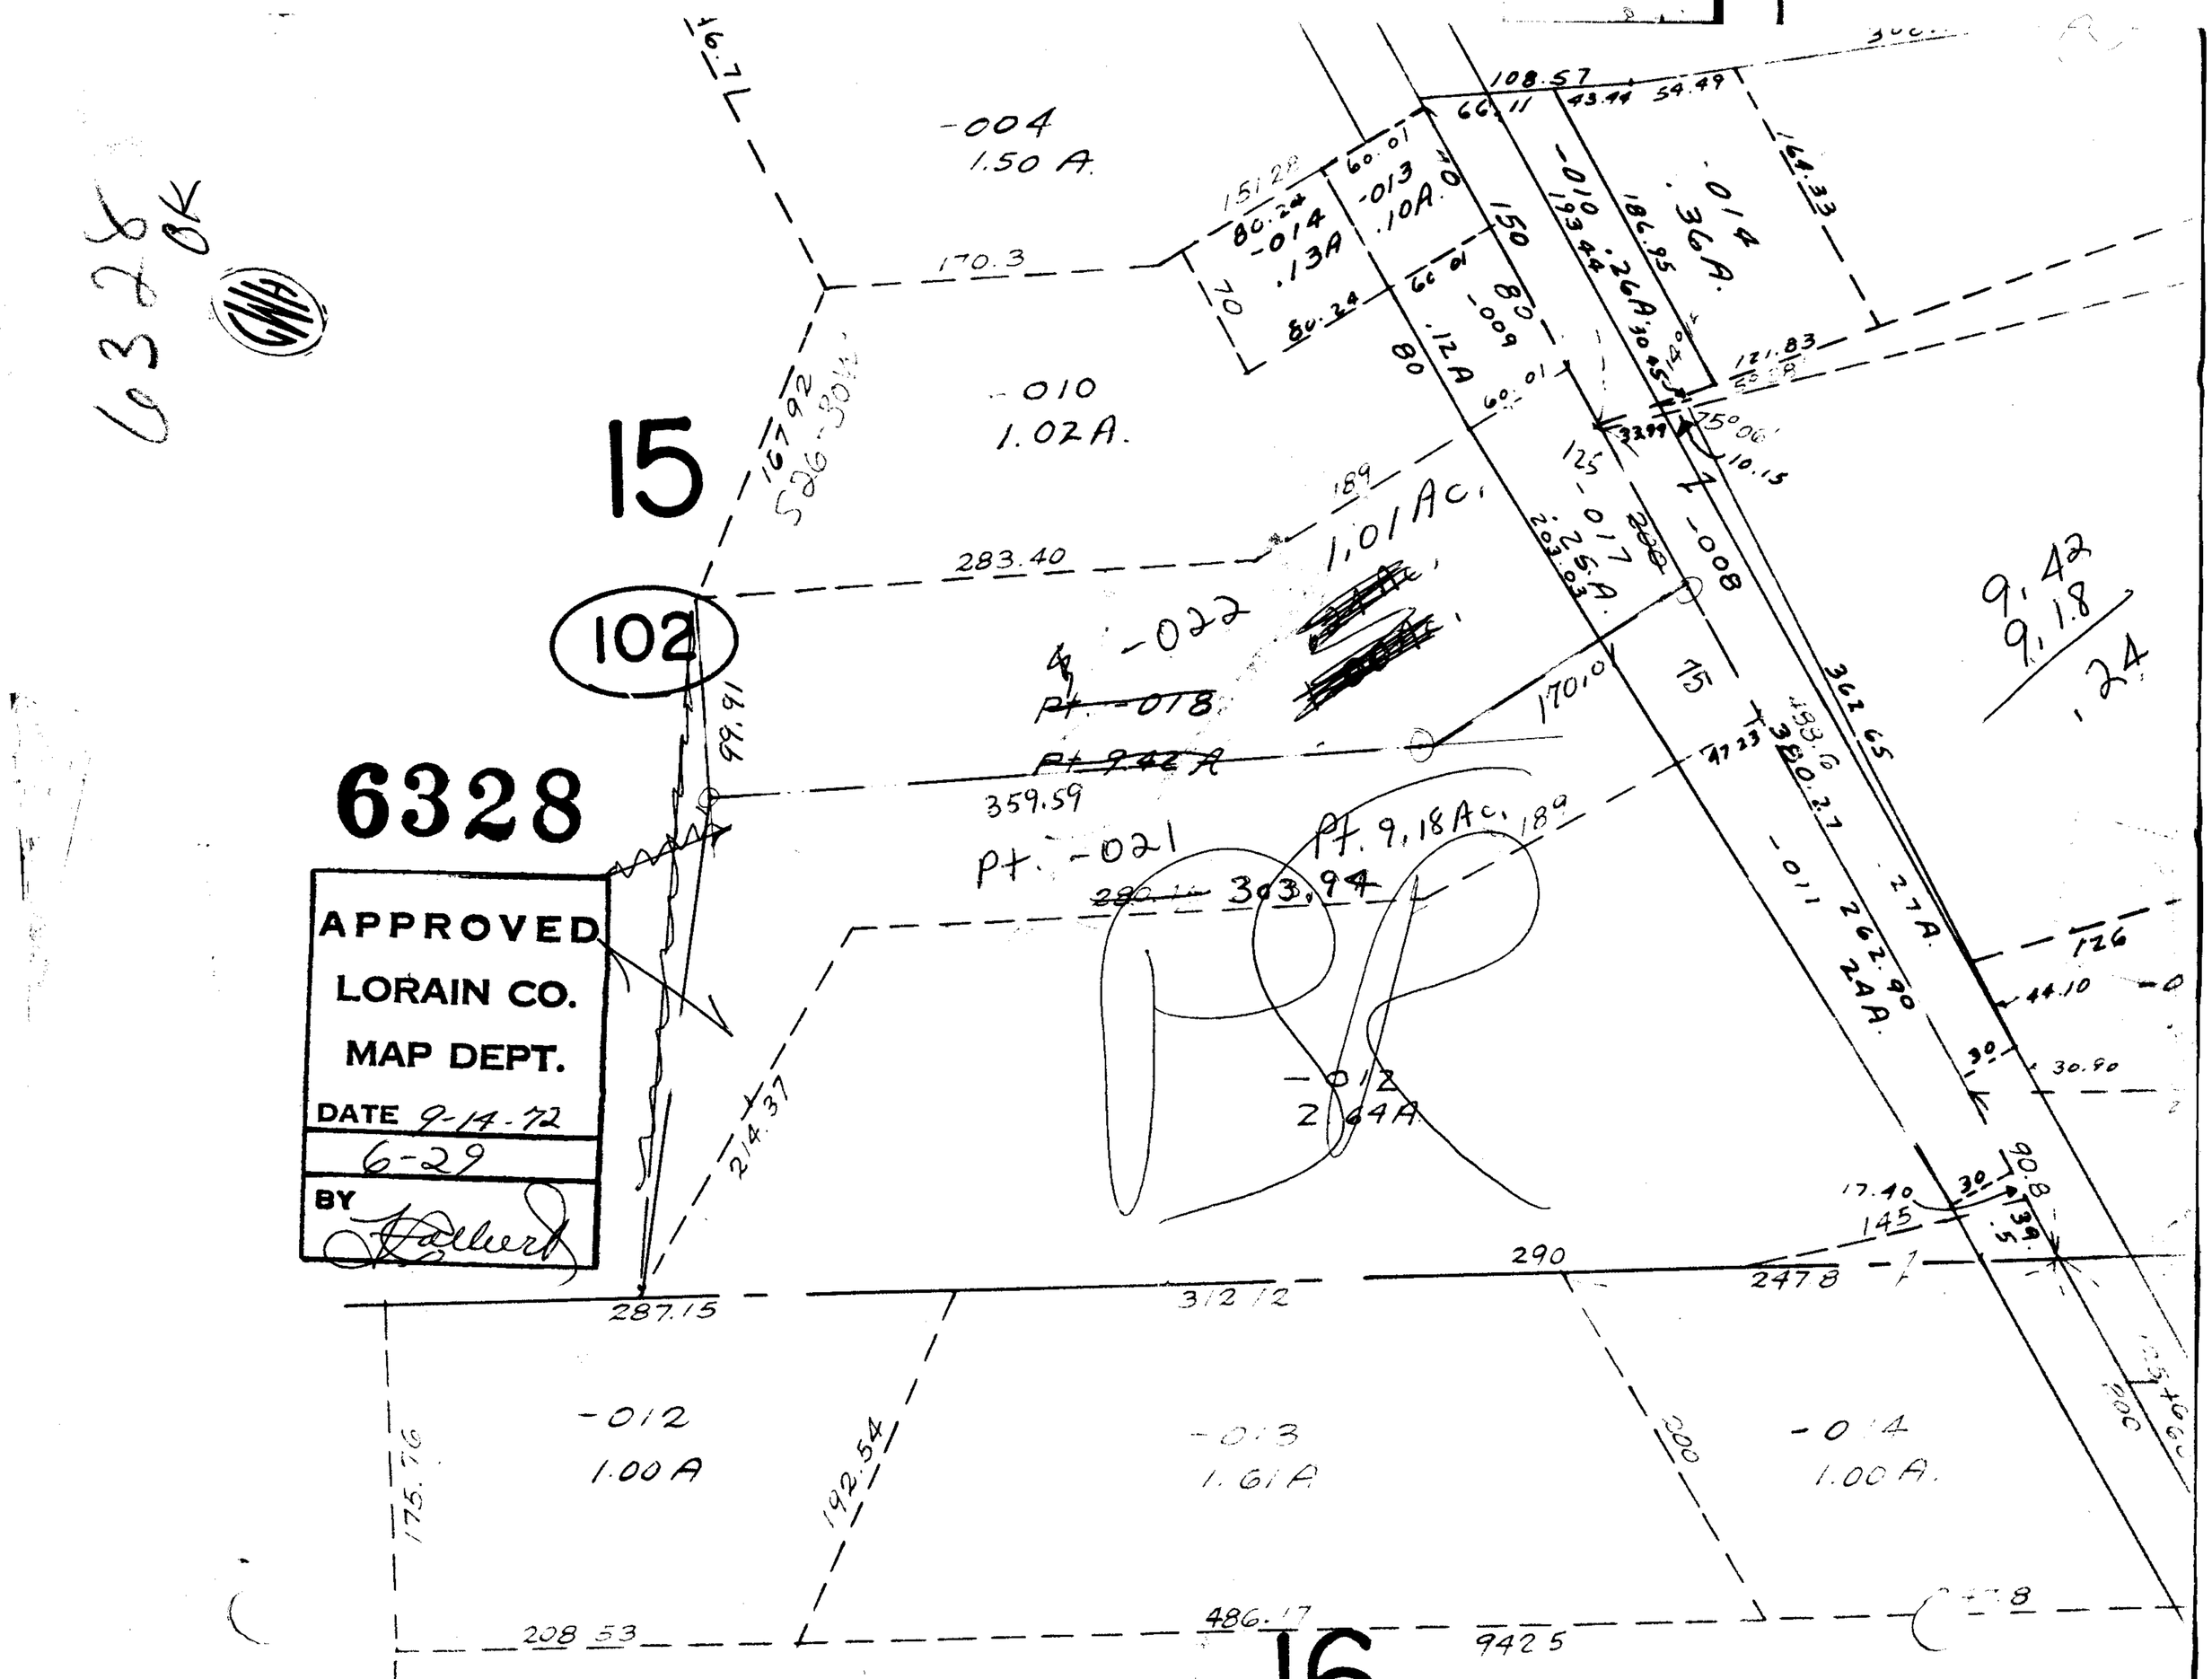
6328
OK
15
102
6328
APPROVED
LORAIN CO.
MAP DEPT.
DATE 9-14-72
6-29
BY
-004
1.50 A.
-010
1.02A.
-014
.13A
-013
.10A
-010
.26A
-014
.36A.
-017
.25A.
-008
-022
1.01Ac.
Pt. -018
Pt. 9.42 A
Pt. -021
Pt. 9.18Ac.
303.94
-012
2.64A
-012
1.00A
-013
1.61A
-014
1.00A.
9.42
9.18
.24
16