



6329
OK
GWA

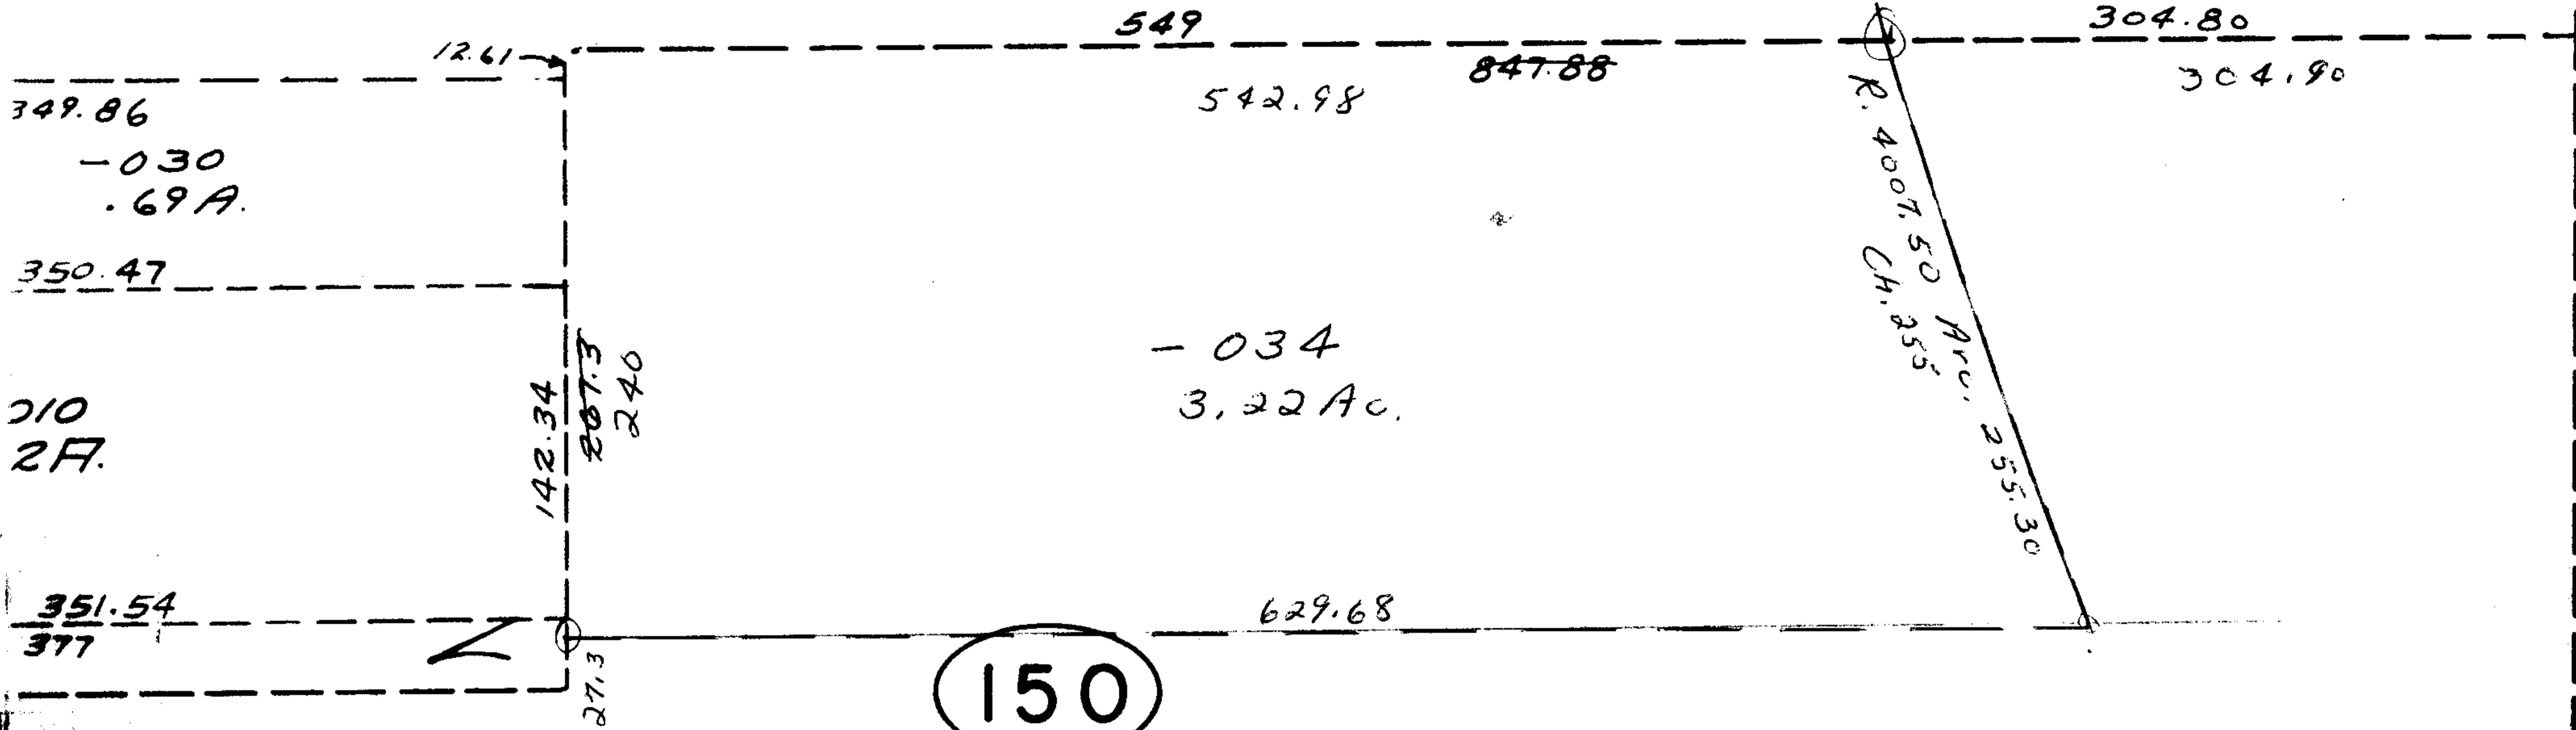

210
2F.

351.54
377

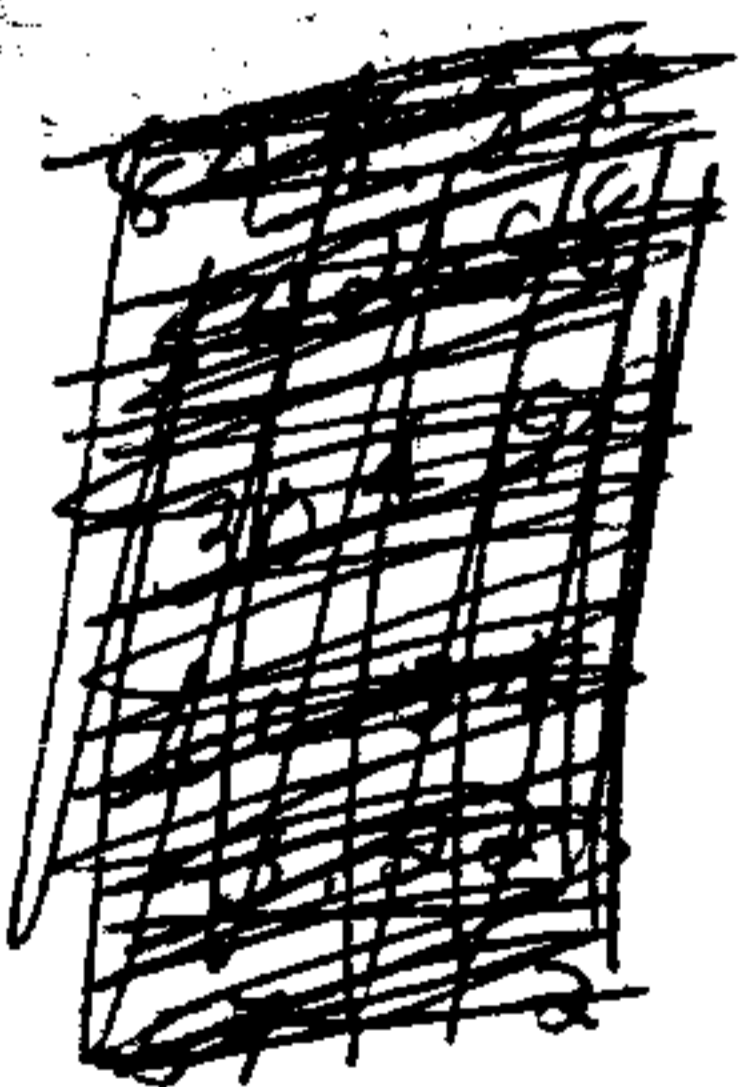

150

[Handwritten signature]

Y.Y
98-81-L
-035
-011
60.34 Ac.
57.12 Ac.

6329

APPROVED
LORAIN CO.
MAP DEPT.
DATE 9-14-72
4-00-007-G4 F
BY *[Signature]*

SEE 4-00-007-H