


6342

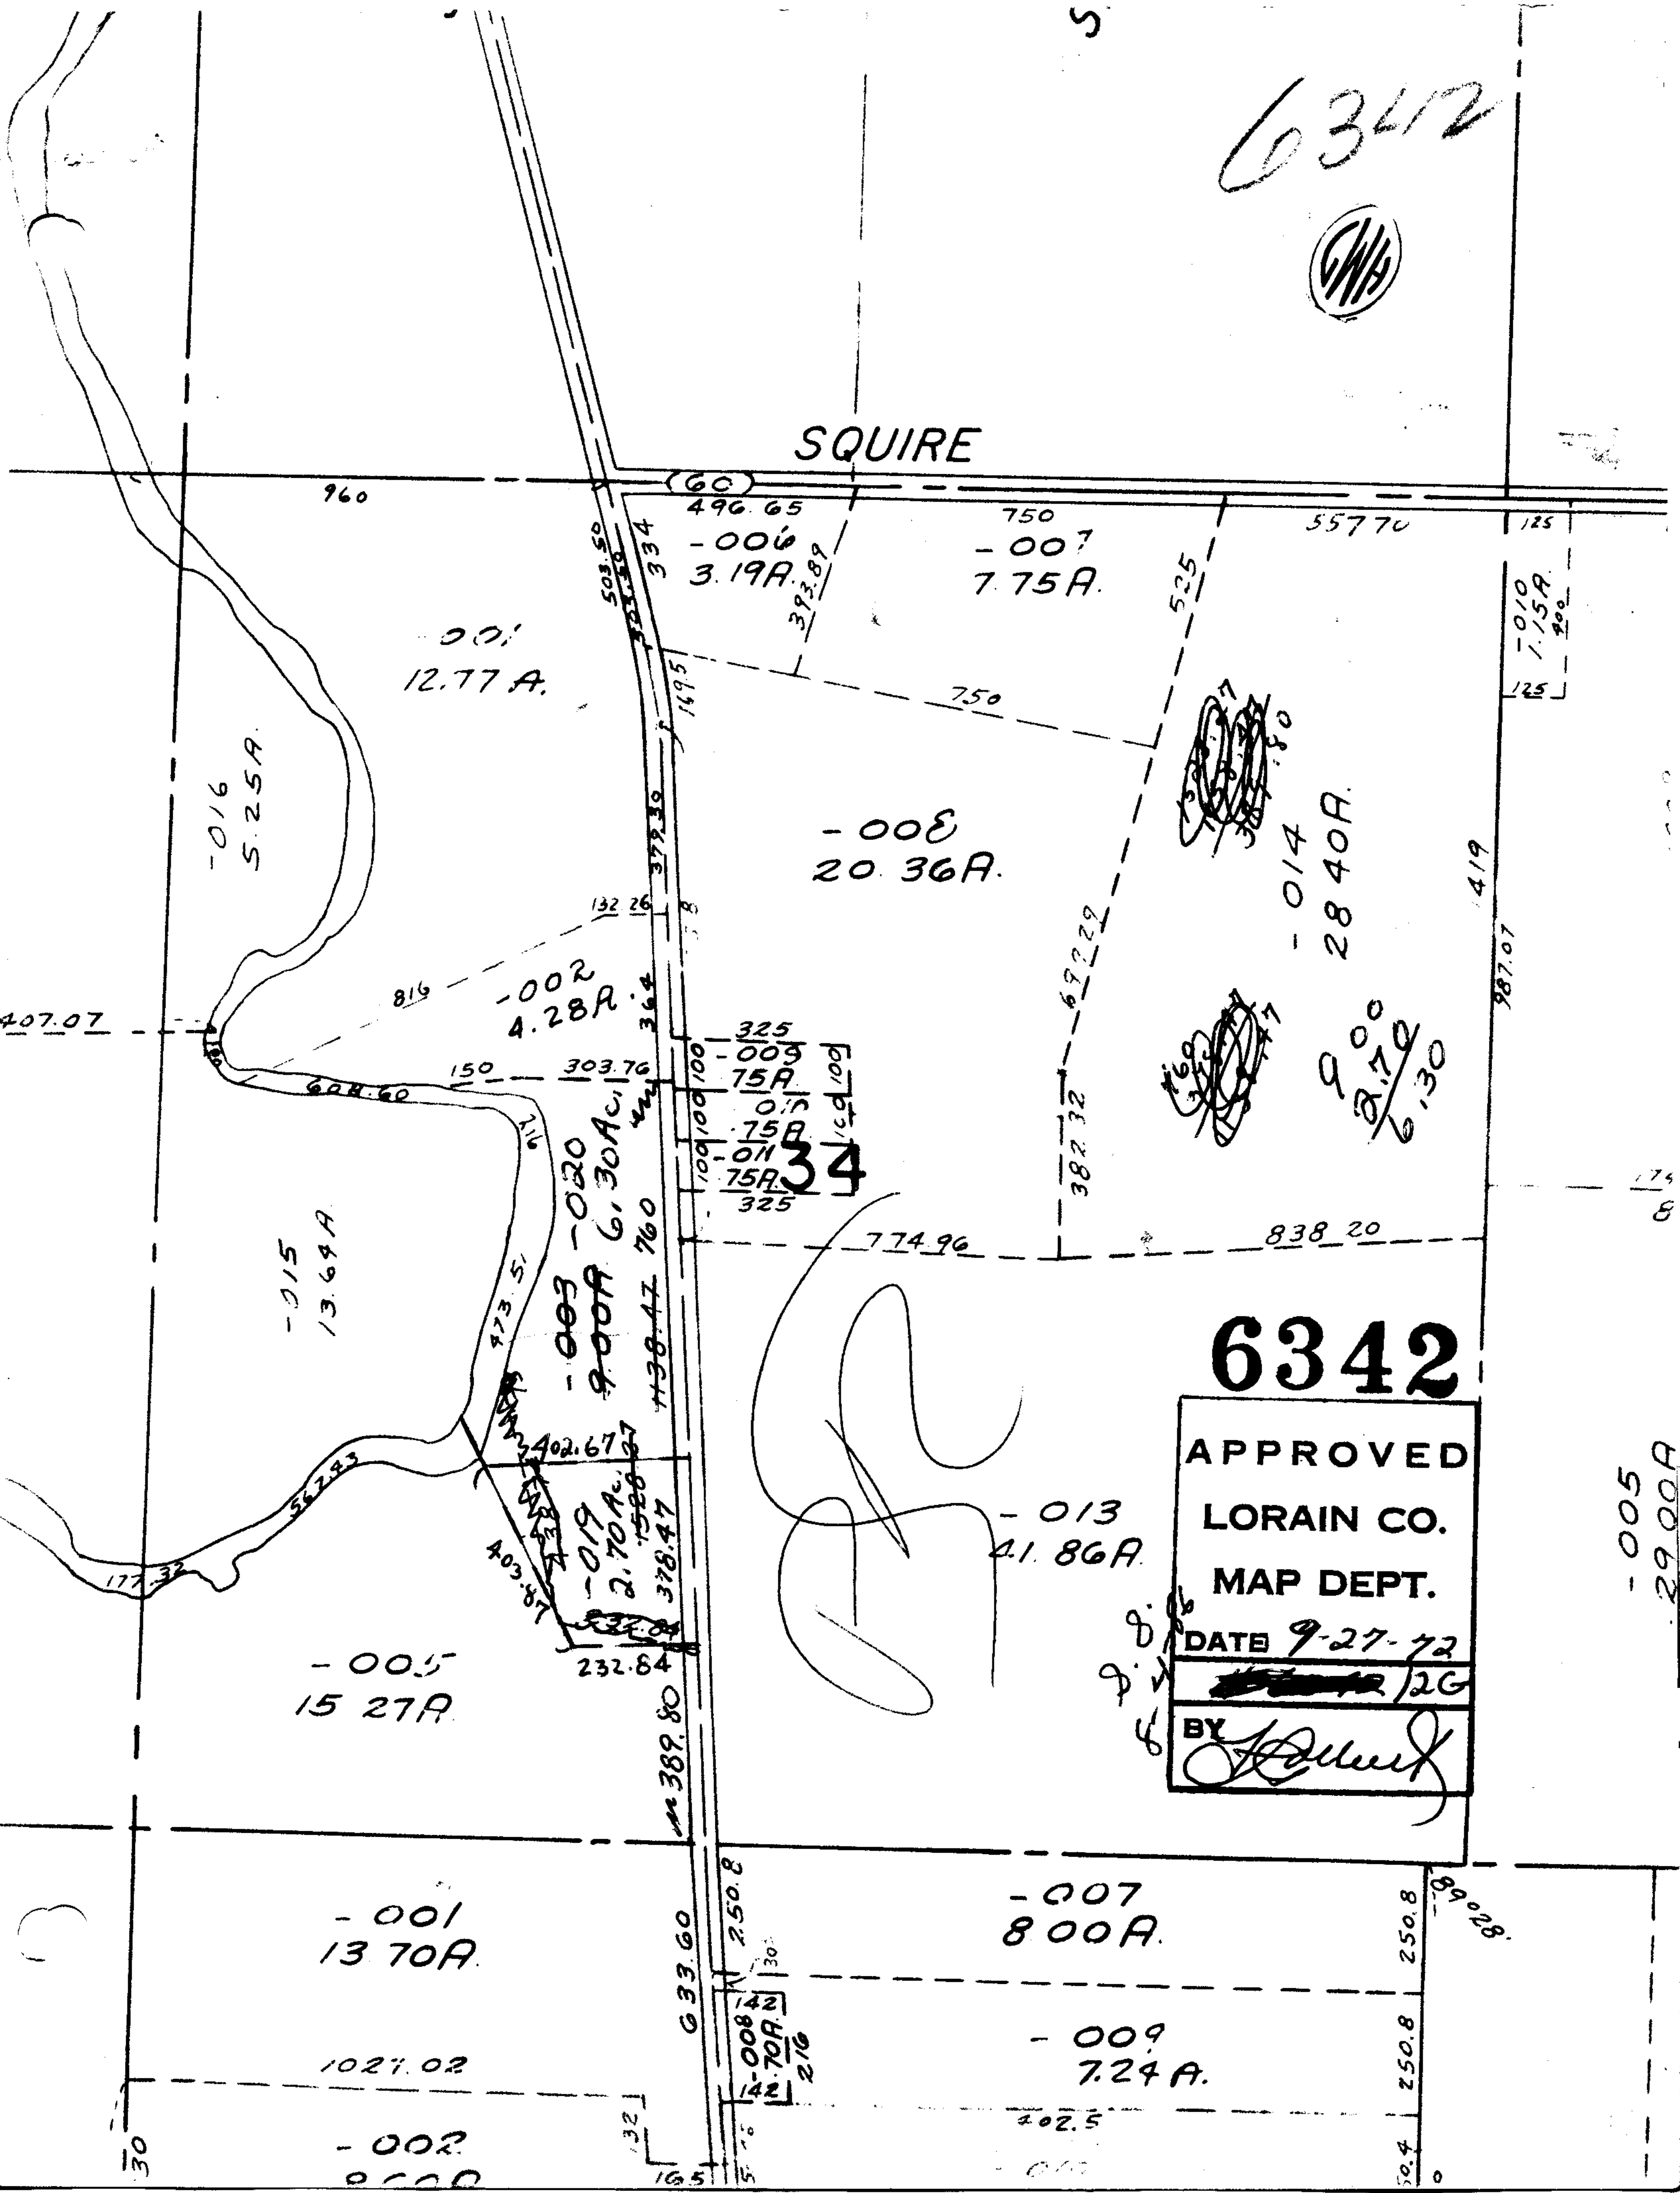

SQUIRE



6342

APPROVED
LORAIN CO.
MAP DEPT.

DATE 9-27-72

~~9-27-72~~ 126

BY *[Signature]*

-005
29.00A