


7-E

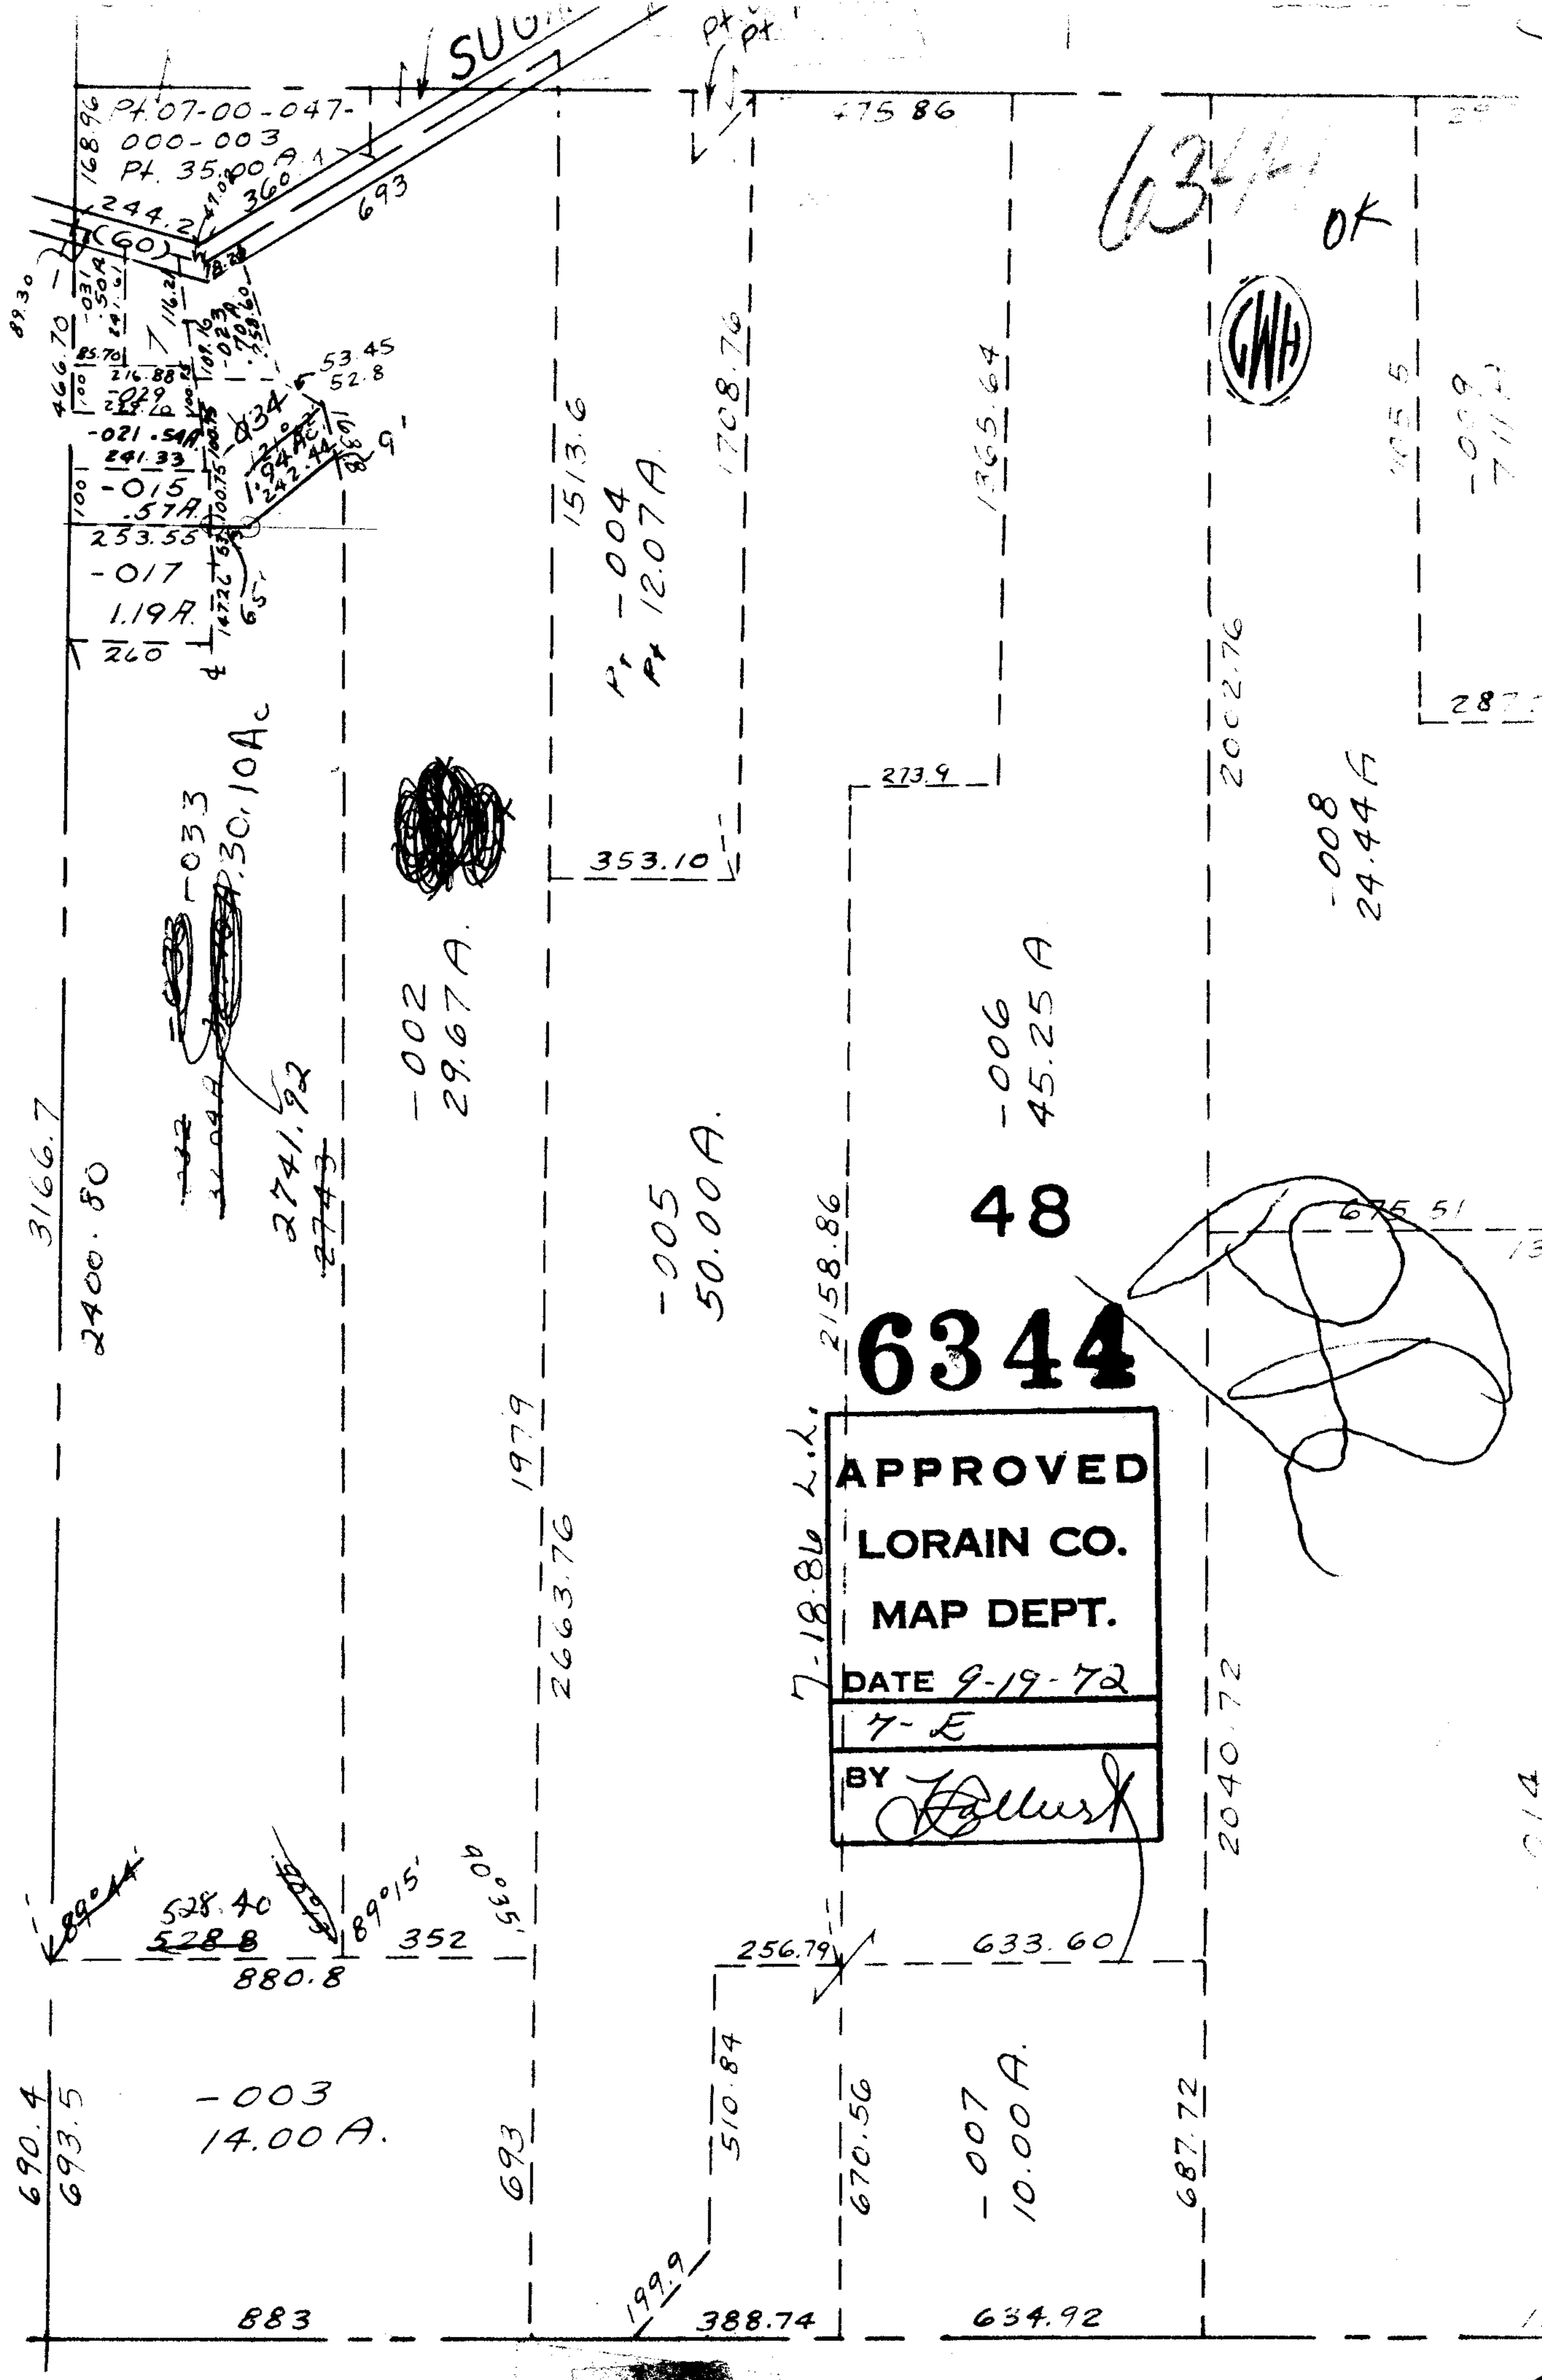

690.4  
693.5

-003  
14.00 A.

693

199.9  
388.74

670.56

-007  
10.00 A.

687.72

3166.7

2400.80

~~272~~  
2741.92

2743

-002  
29.67 A.

1979

2663.76

-005  
50.00 A.

353.10

1513.6

Pt -004  
Pt 12.07 A.

1708.76

7-18.86 L.L.  
2158.86

6344

48

APPROVED  
LORAIN CO.  
MAP DEPT.  
DATE 9-19-72  
7-E  
BY *Fallus*

-006  
45.25 A.

273.9

2040.72

2002.76

-008  
24.44 A.



6344 OK

105.5  
-009  
711.2

287.1

675.51

014