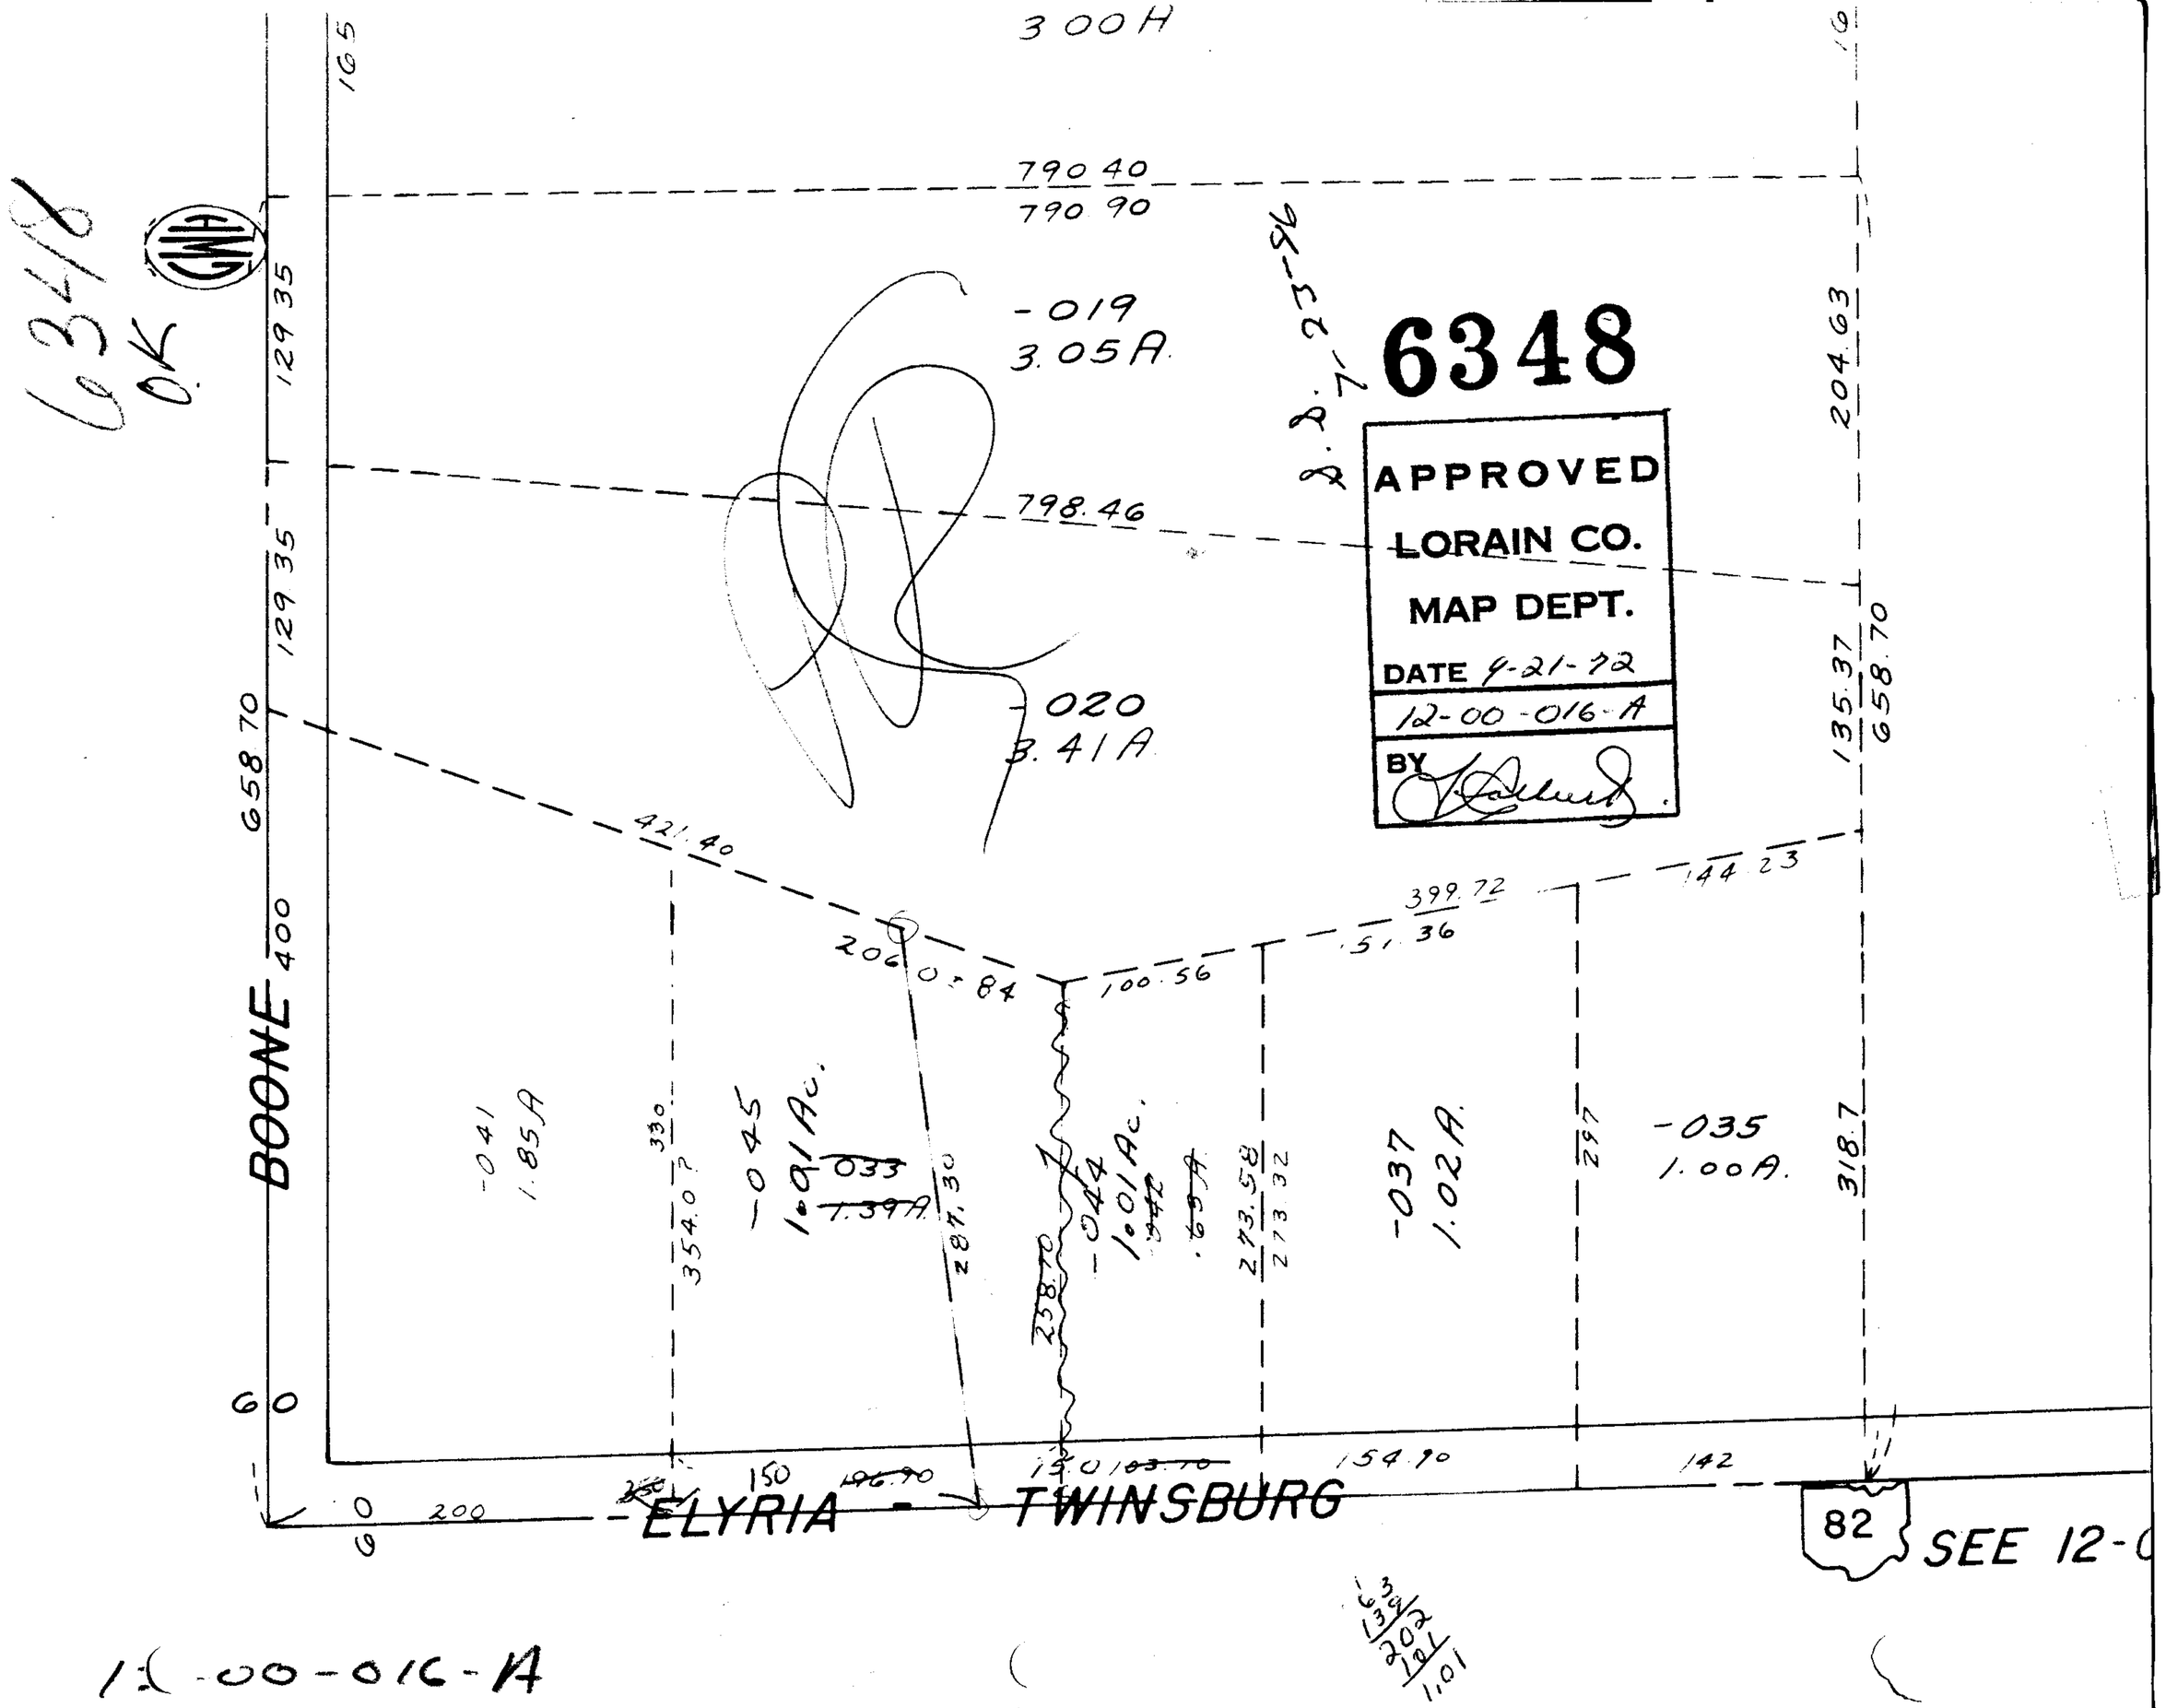
6348
APPROVED
LORAIN CO.
MAP DEPT.
DATE 9-21-72
12-00-016-A
BY
6348
OK
GMA
3.00 A
790.40
790.90
-019
3.05 A
798.46
-020
3.41 A
421.40
206.0 ± 84
100.56
399.72
151.36
144.23
-041
1.85 A
-045
1.01 Ac.
-033
1.39 A
-044
1.01 Ac.
-037
1.02 A
-035
1.00 A
BOONE
ELYRIA - TWINSBURG
82
SEE 12-0
204.63
135.37
658.70
318.7
154.90
142
150
200
129.35
658.70
400
60
165
12-00-016-A