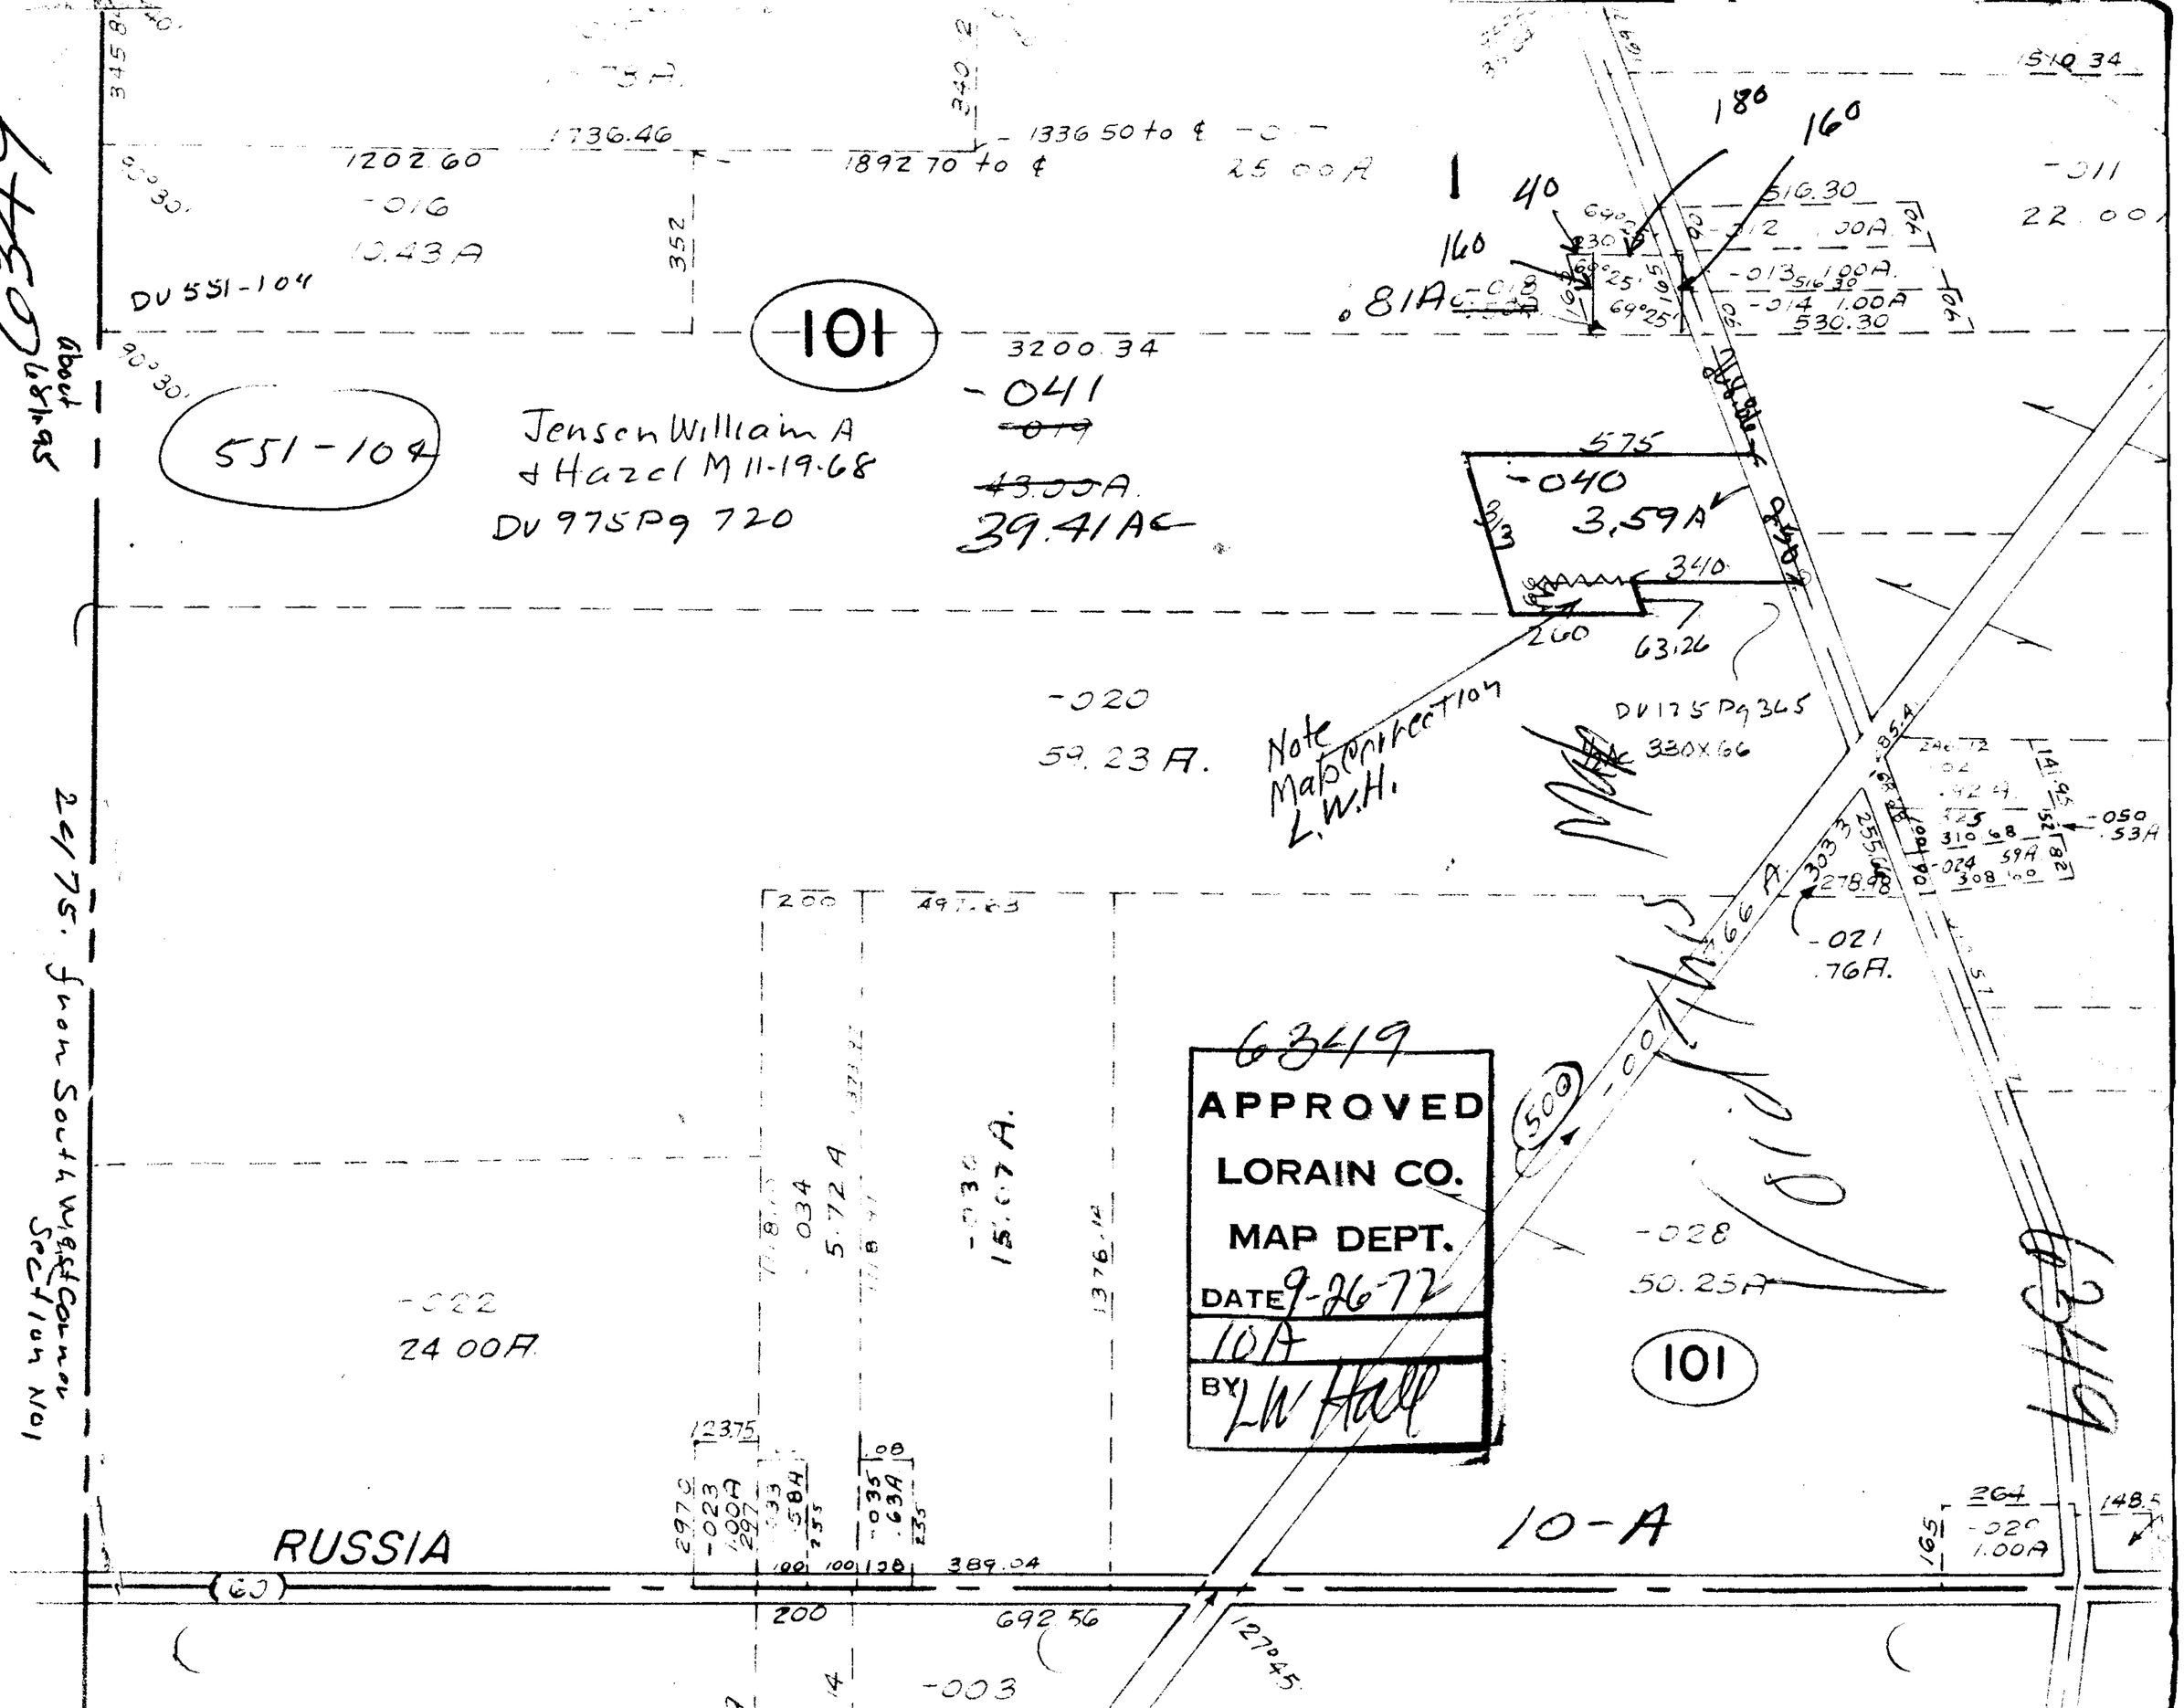
6349
About 6-8-95
24/75. from South West Corner Section No 1
101
551-104
Jensen William A & Hazel M 11-19-68
DV 975 Pg 720
DV 551-104
1202.60
-016
10.43 A
1736.46
1336.50 to ¢
1892.70 to ¢
25.00 A
3200.34
-041
~~-019~~
~~43.00 A.~~
39.41 AC
-020
59.23 A.
Note Map Correction L.W.H.
-040
3.59 A
575
340
260
63.26
DV 175 Pg 365
330 X 66
-011
22.00
516.30
-012
-013
-014
530.30
.81 AC
-021
.76 A.
-028
50.25 A
-022
24.00 A
-034
5.72 A
-036
15.07 A.
1376.12
6349
APPROVED
LORAIN CO.
MAP DEPT.
DATE 9-26-72
10A
BY LW Hall
500
10-A
RUSSIA
(60)
389.04
200
692.56
127°45
-003
-050
.53 A
-024
-020
1.00 A
264
148.5
165
1510.34