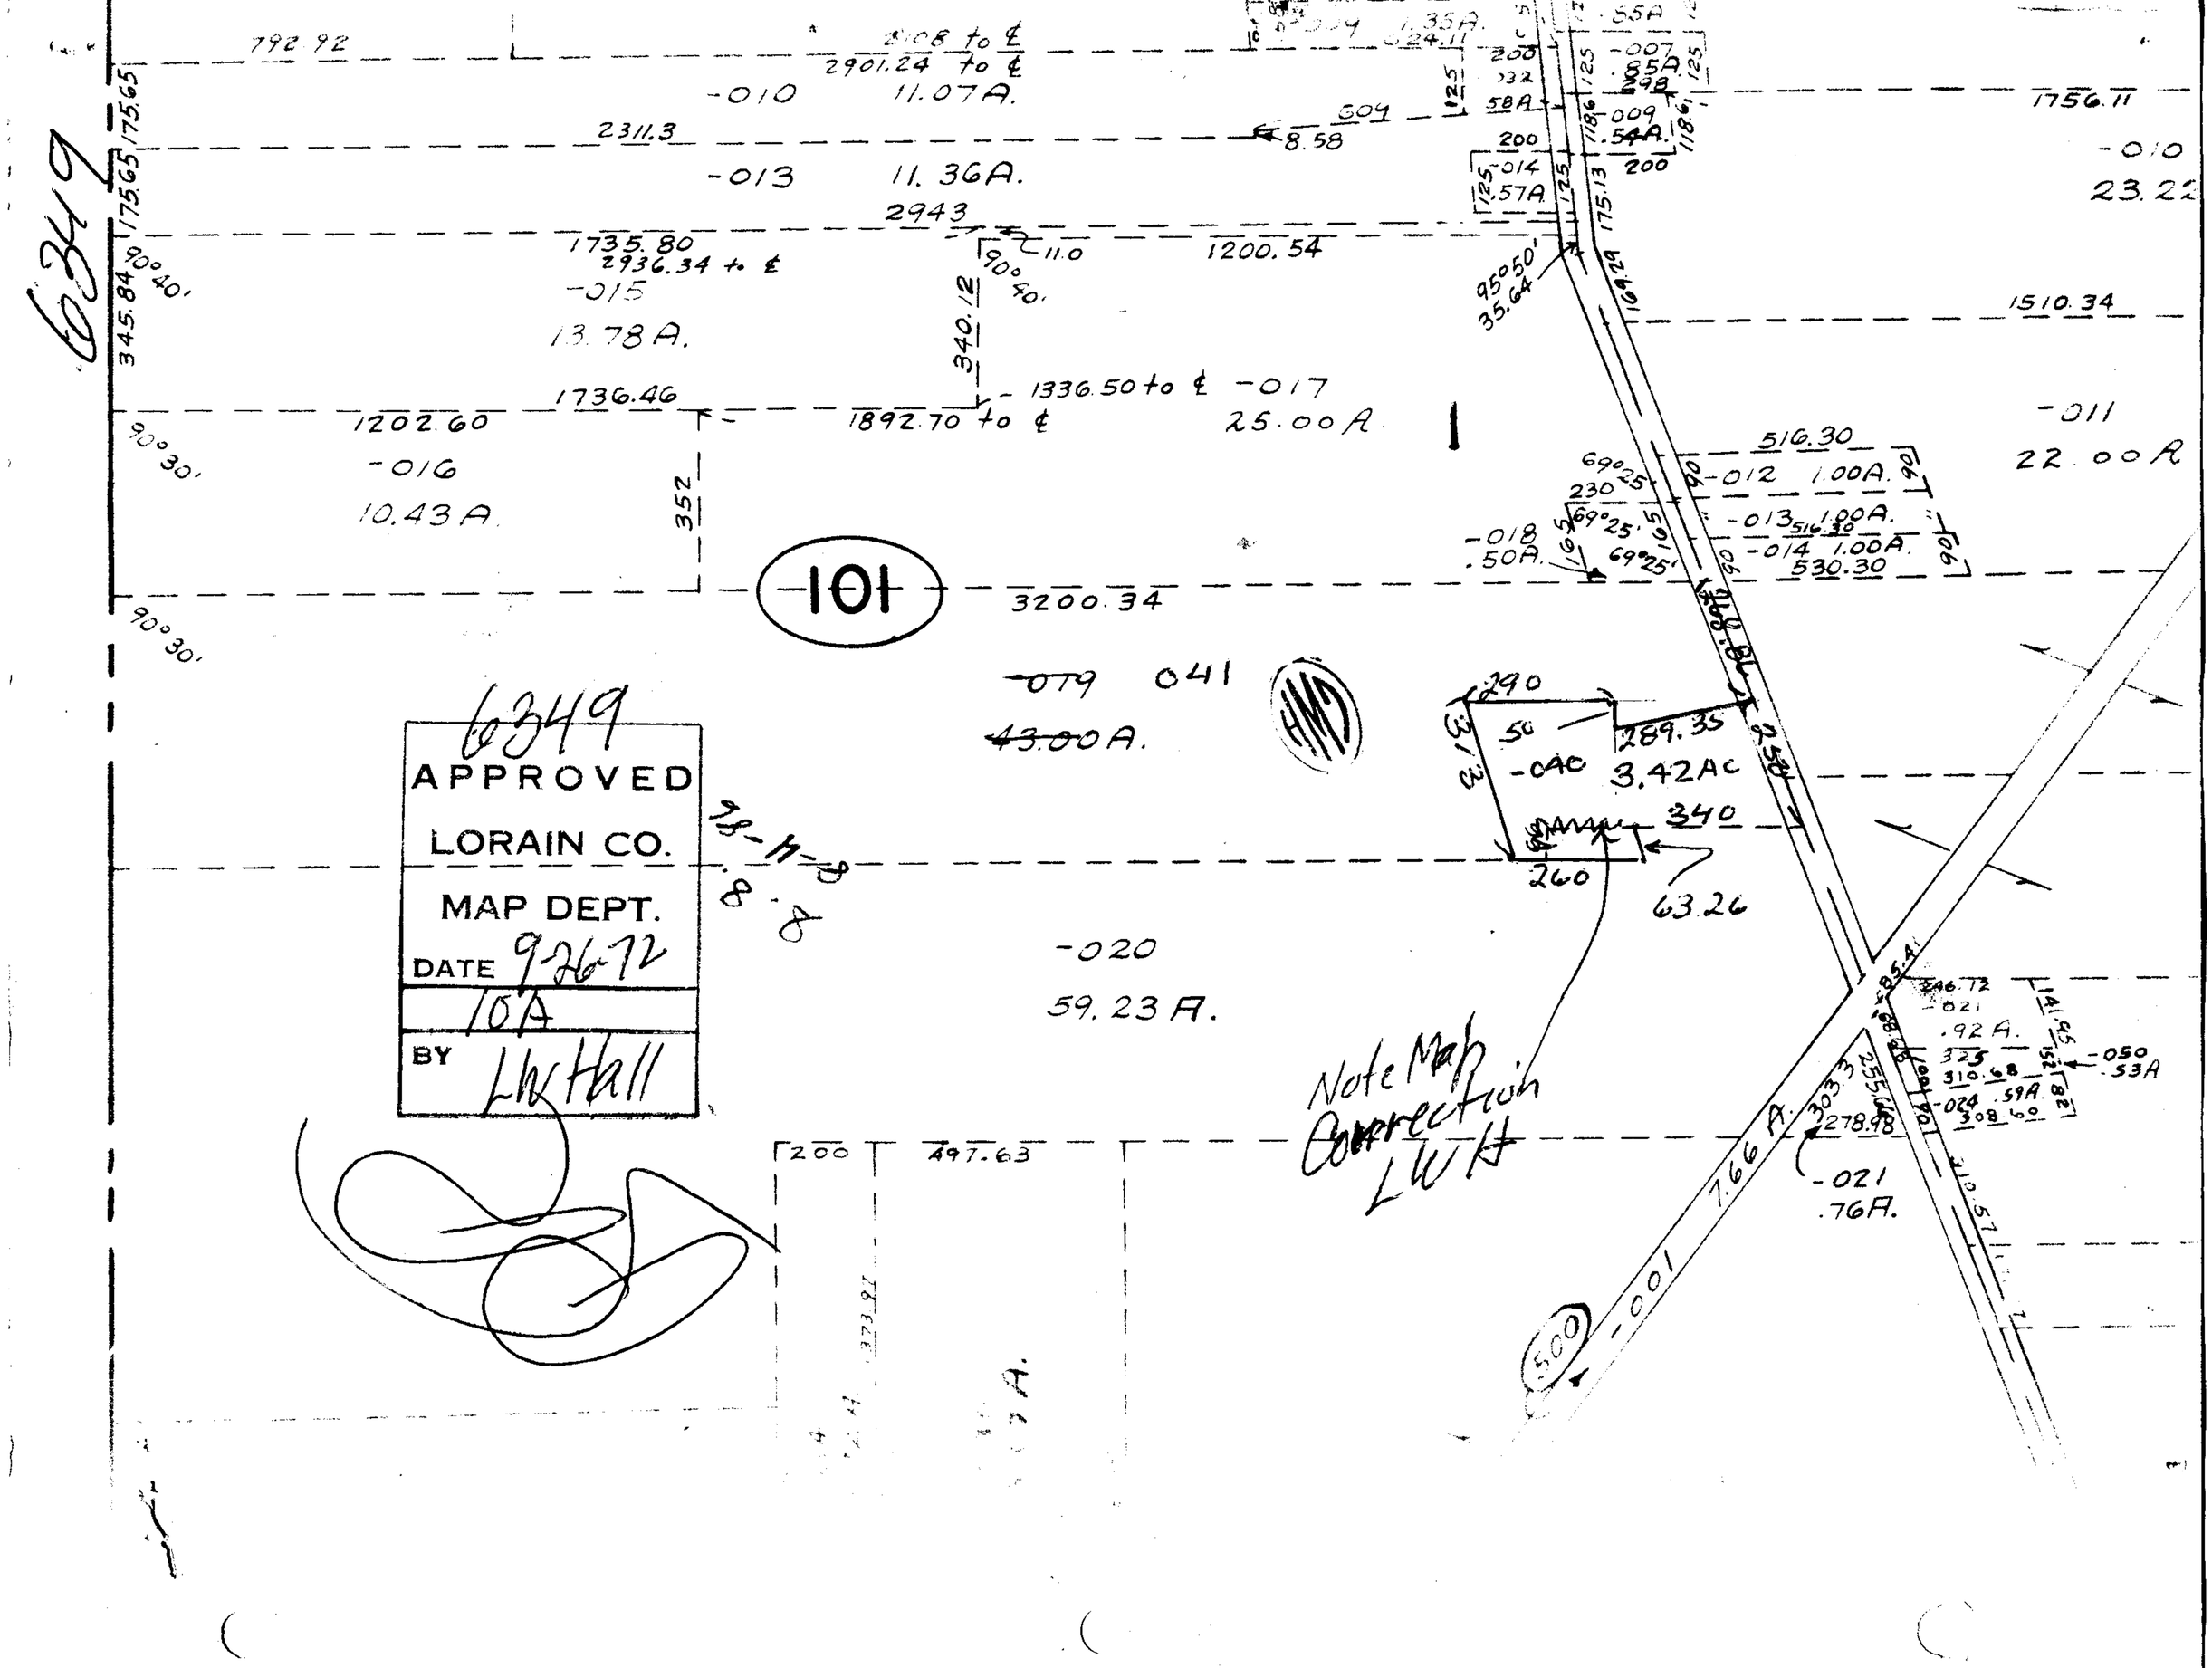
6349
APPROVED
LORAIN CO.
MAP DEPT.
DATE 9-26-72
10A
BY LW Hall
Note Map Correction LWH
101
-010 11.07A.
-013 11.36A.
-015 13.78A.
-016 10.43A.
-017 25.00A.
-019 041
43.00A.
-020 59.23A.
-021 .76A.
-011 22.00A
-012 1.00A.
-013 1.00A.
-014 1.00A.
-018 .50A.
-040 3.42AC
-050 .53A
-001 7.66A.
-007 .85A.
-009 .54A.
-014 .57A.
-024 .59A.
-021 .92A.
1756.11
1510.34
1200.54
1735.80
1736.46
1202.60
1892.70 to ℄
1336.50 to ℄
2901.24 to ℄
2311.3
2943
3200.34
1756.11
345.84
90°40'
90°30'
352
340.12
95°50'
35.64
69°25'
516.30
530.30
289.35
340
260
63.26
200
497.63
500