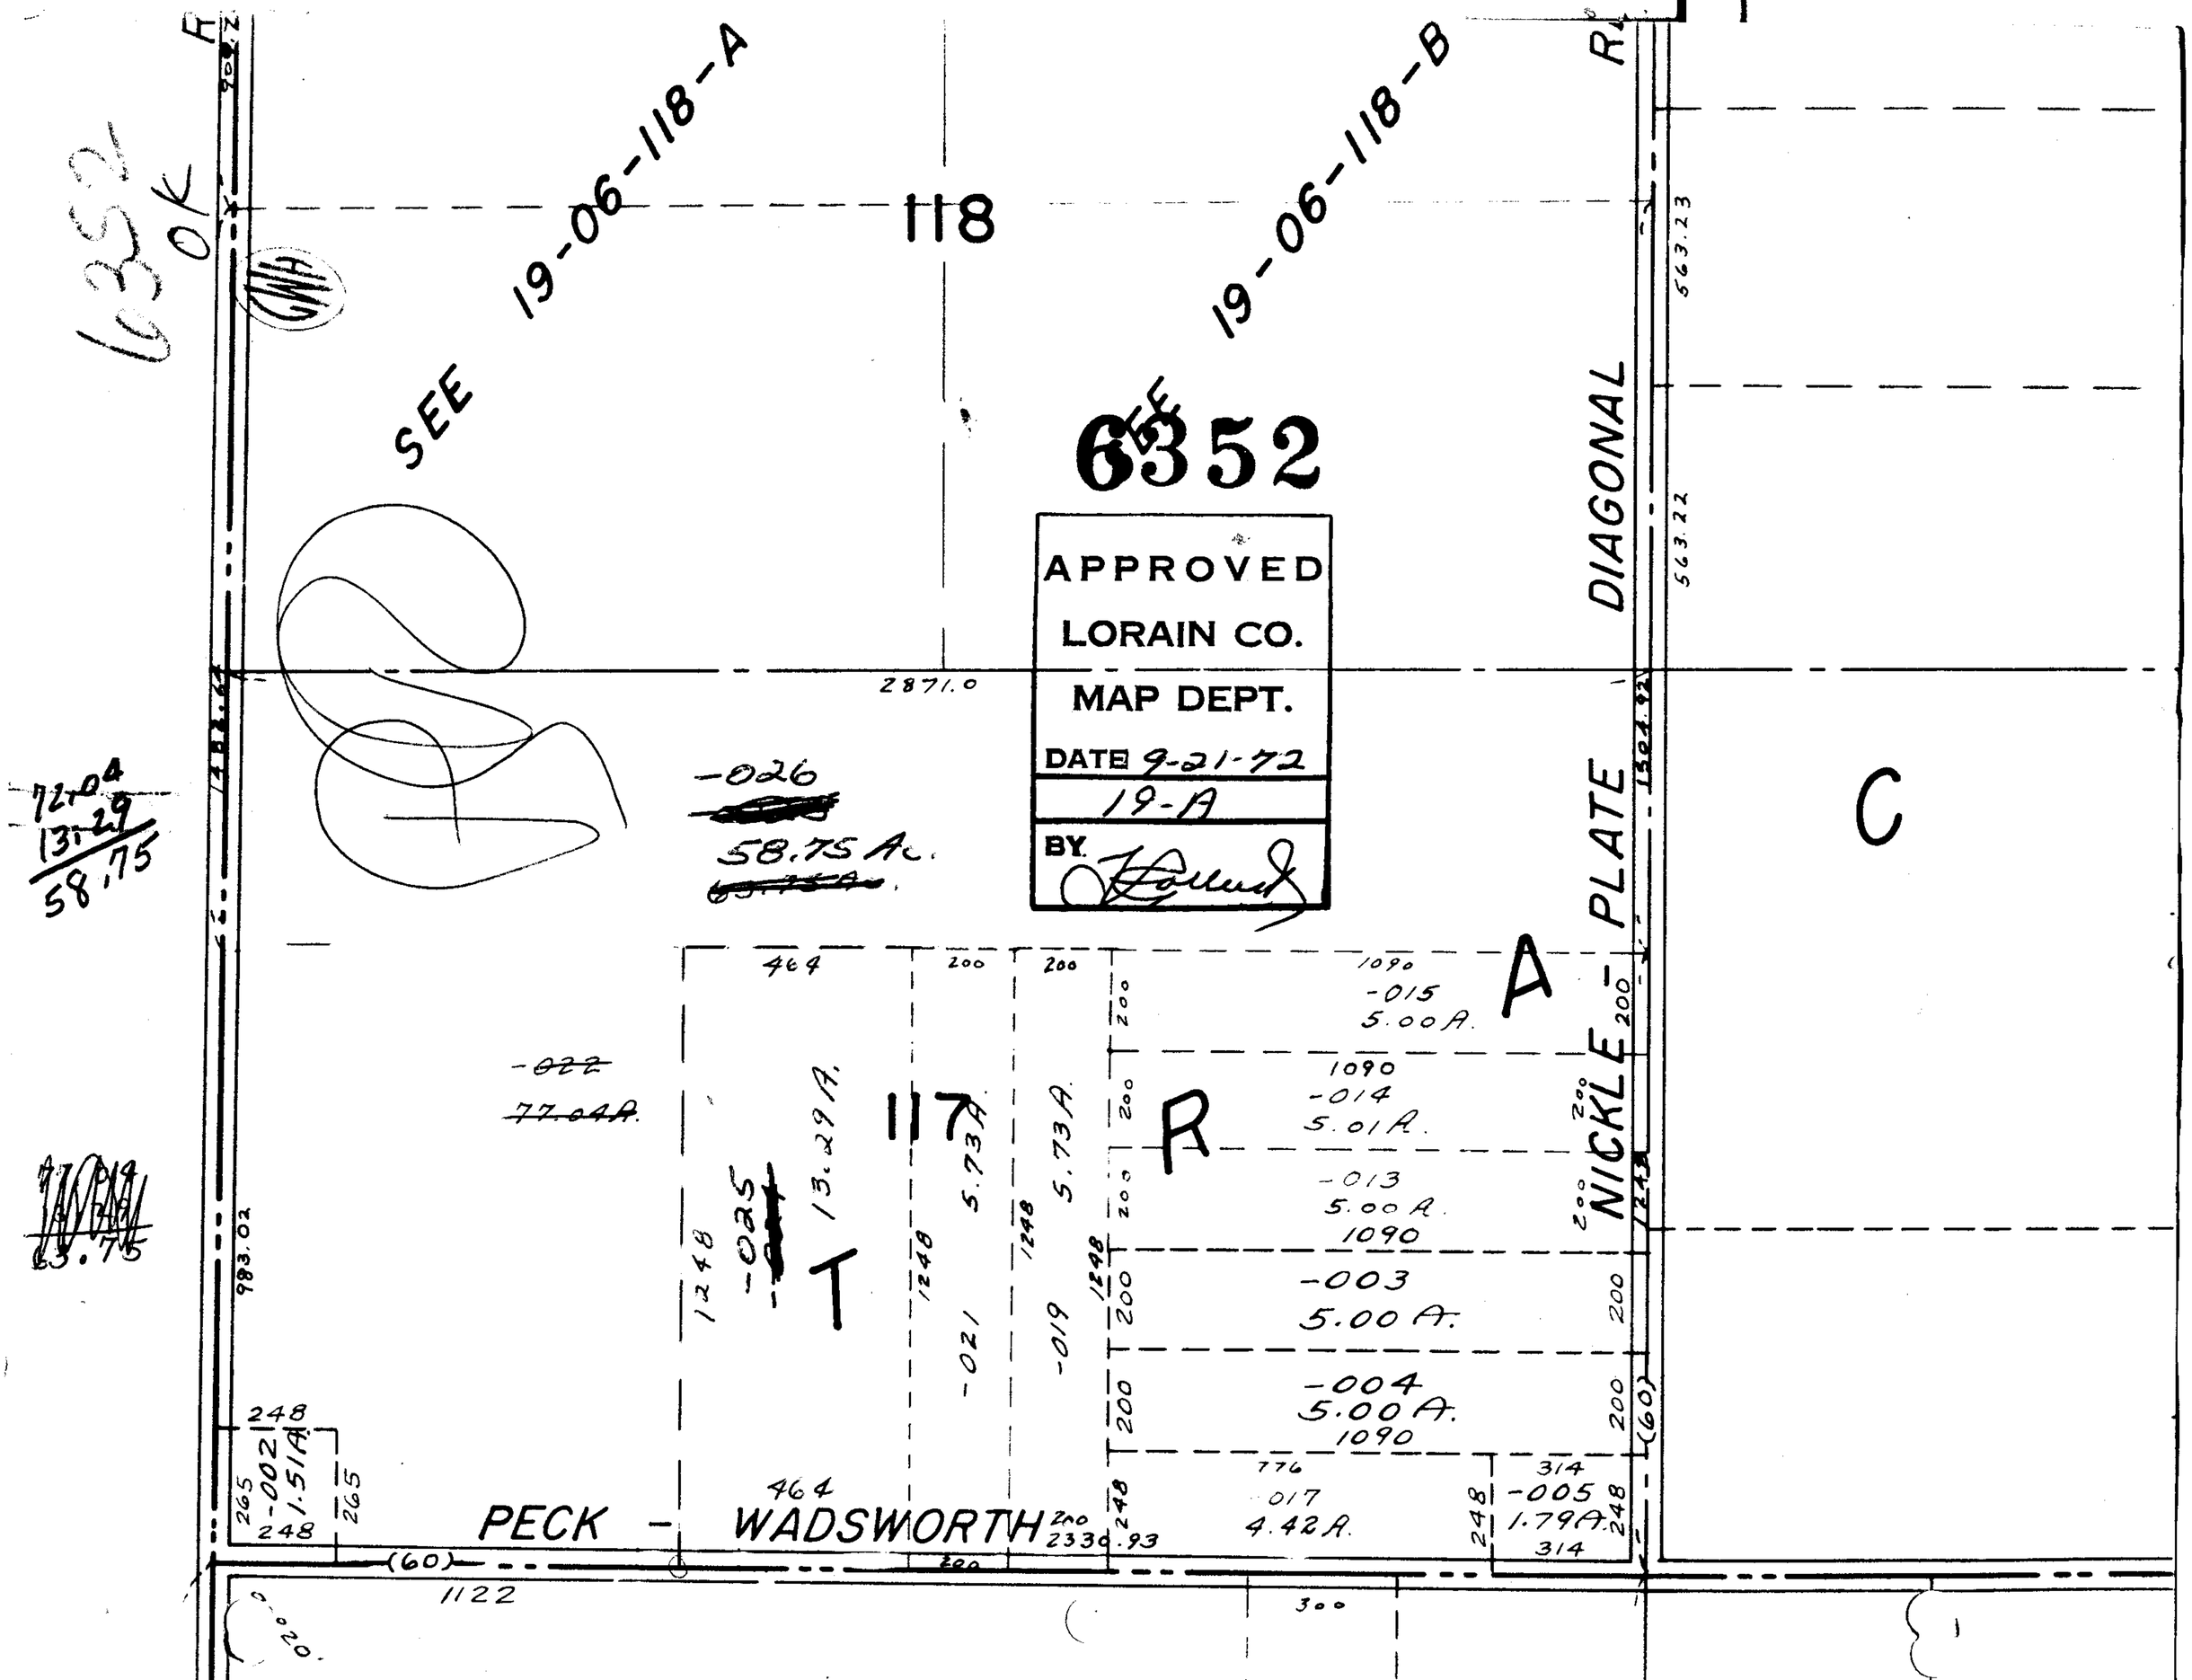

6352
OK
SEE 19-06-118-A
118
SEE 19-06-118-B
6352
APPROVED
LORAIN CO.
MAP DEPT.
DATE 9-21-72
19-A
BY
DIAGONAL
PLATE
NICKLE
C
A
R
T
117
-026
58.75 Ac.
-022
77.04A.
-025
13.29A.
5.73A.
-021
-019
-015
5.00A.
-014
5.01A.
-013
5.00A.
-003
5.00A.
-004
5.00A.
-017
4.42A.
-005
1.79A.
-002
1.51A.
PECK - WADSWORTH
2871.0
2330.93
1122
983.02
563.23
563.22
1304.92