


SE

WAKEMAN-LAGRANGE-RICHFIELD

6357

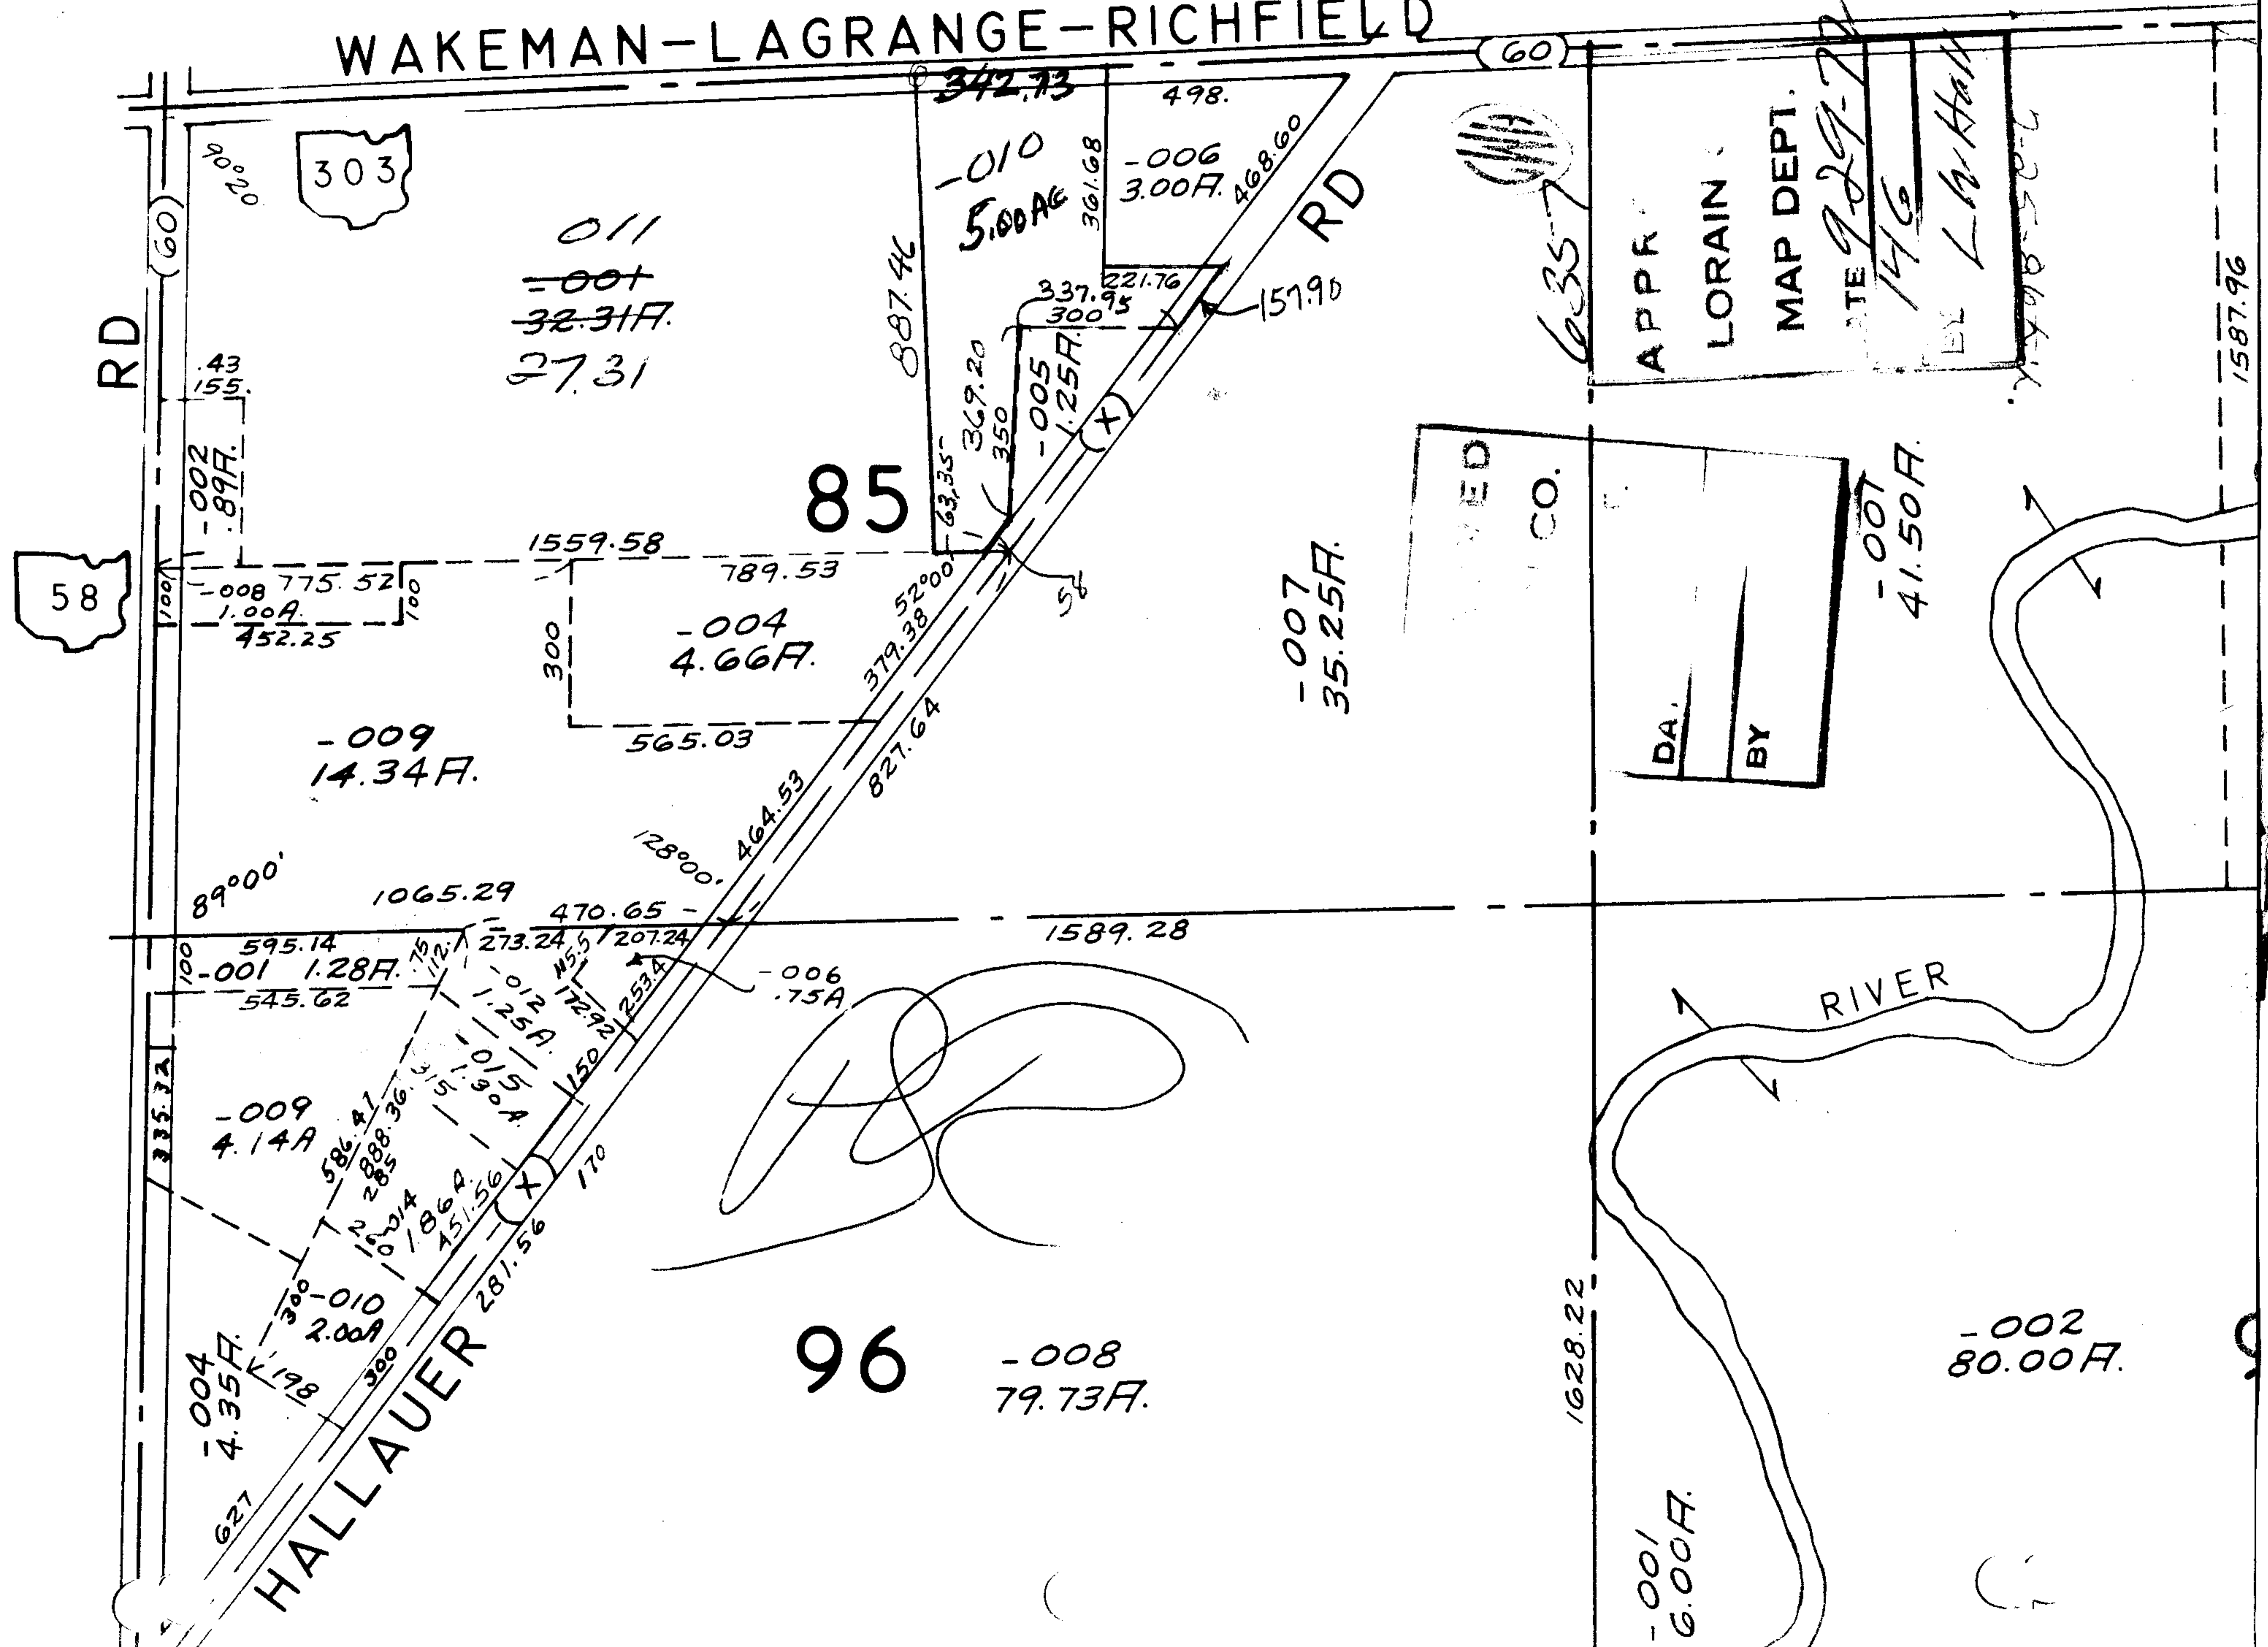

58

303

85

96

APPR.
LORAIN
MAP DEPT.

DATE 9-29-77
BY L.W. Hall

DA.
BY

80.00 F.

1587.96

1628.22

6.00 F.

41.50 F.



6357