


4-00-019-J

6366
6366

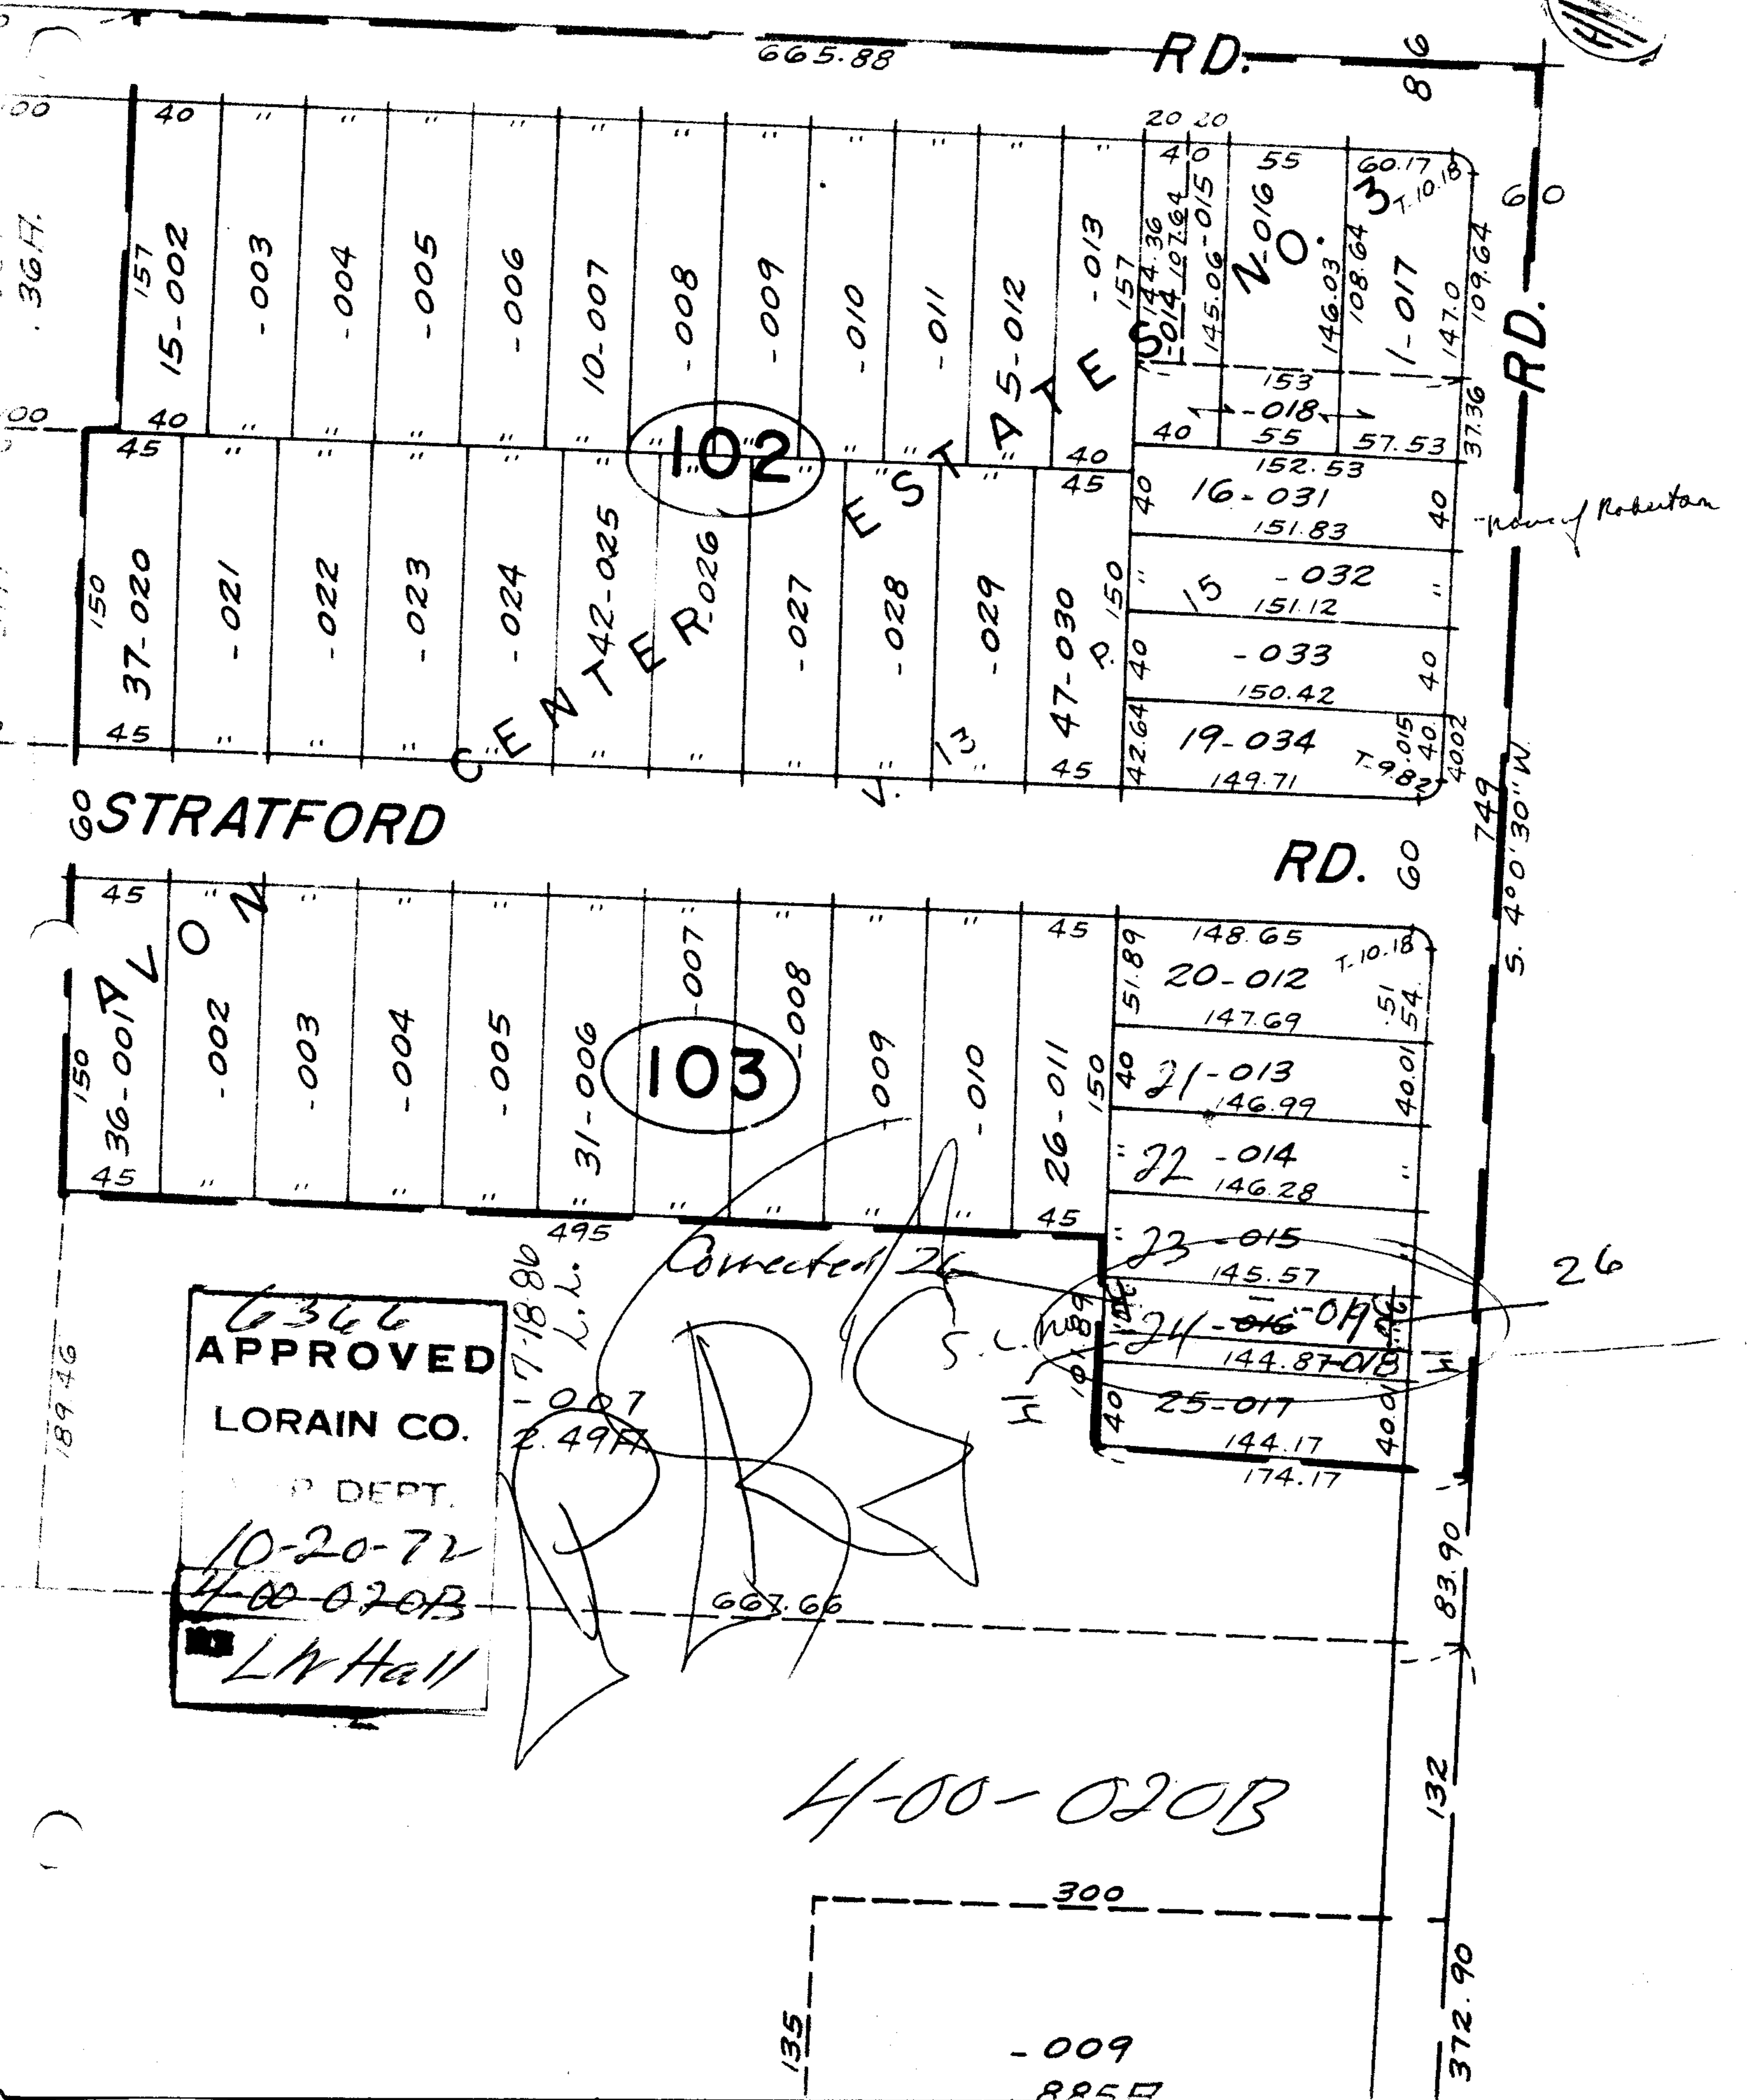

6366
APPROVED
 LORAIN CO.
 P. DEPT.
 10-20-72
 4-00-020B
 L.V. Hall

4-00-020B

Name of Robertson

26

-009
8857