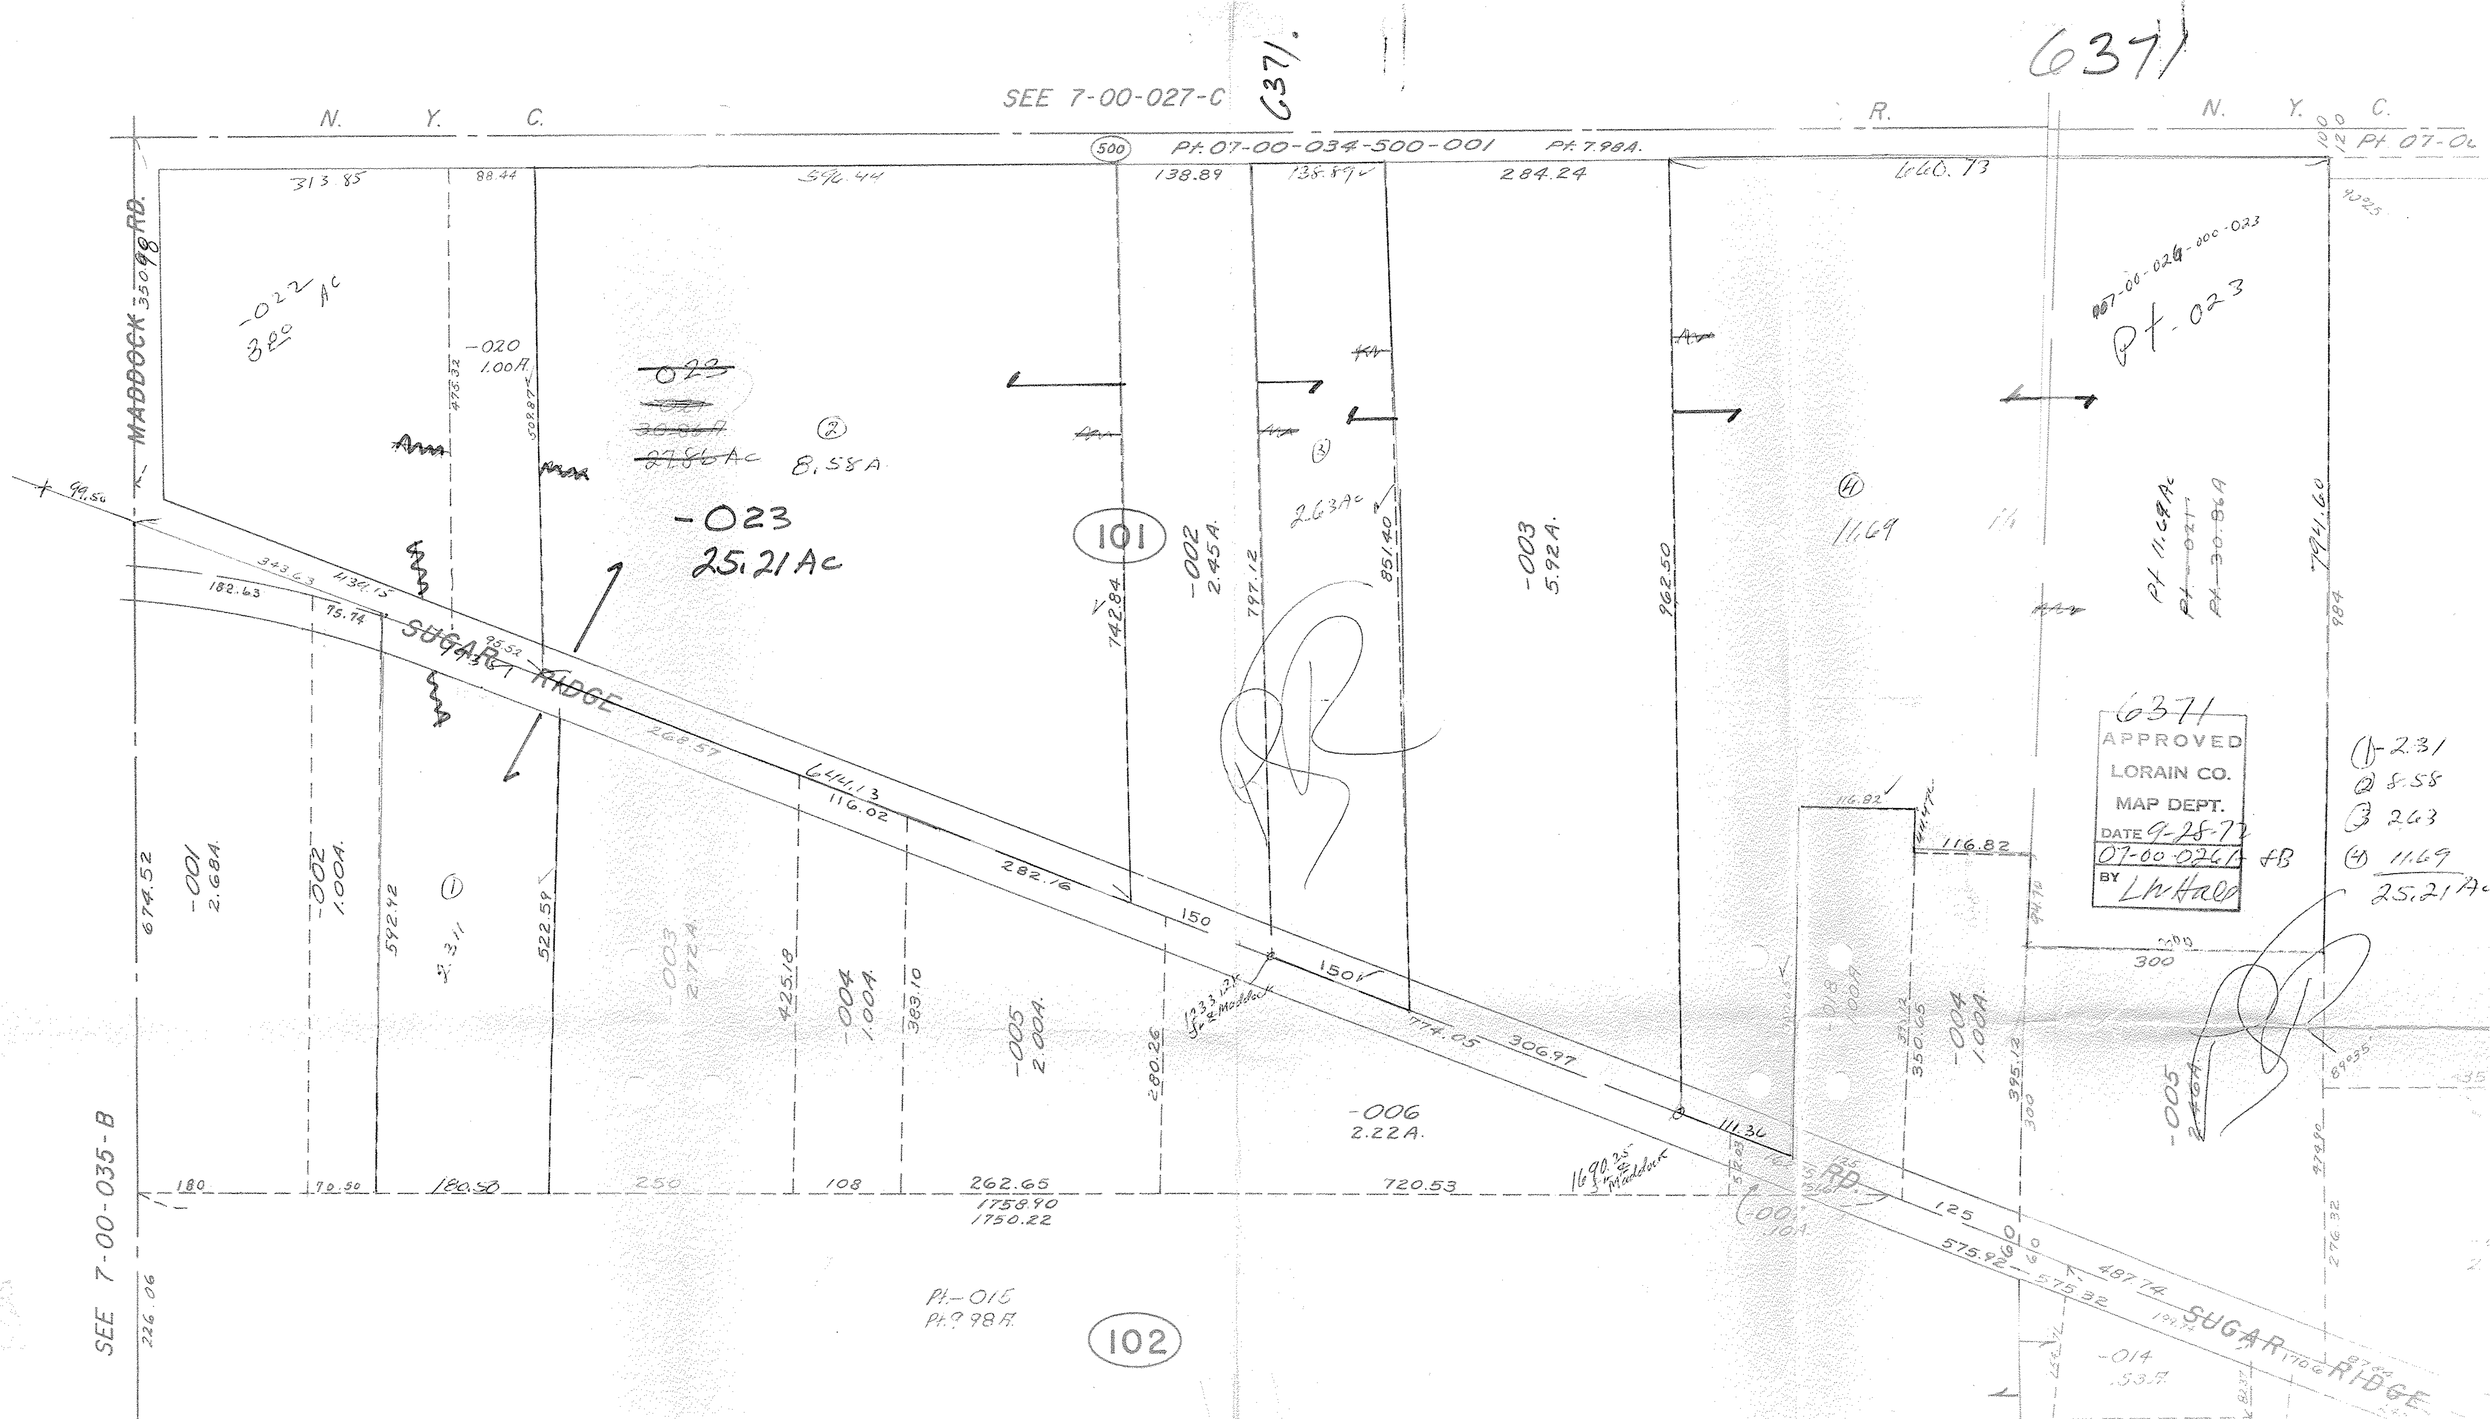
6371
SEE 7-00-027-C
N. Y. C. R.
Pt. 07-00-034-500-001 Pt. 7.98A.
MADDOCK RD.
SUGAR RIDGE
-022 3.80 Ac
-020 1.00A.
-023 25.21Ac
8.58A
2.63Ac
-002 2.45A
-003 5.92A.
11.69
Pt. 11.69Ac
Pt. 07-00-026-000-023
Pt. 023
101
-001 2.68A.
-002 1.00A.
-003 2.72A.
-004 1.00A.
-005 2.00A.
-006 2.22A.
-004 1.00A.
-005 2.00A.
-014 .53A.
Pt.-015 Pt. 7.98A.
102
SEE 7-00-035-B
6371
APPROVED
LORAIN CO.
MAP DEPT.
DATE 9-28-72
07-00-026A
BY
(1) 2.31
(2) 8.58
(3) 2.63
(4) 11.69
25.21Ac