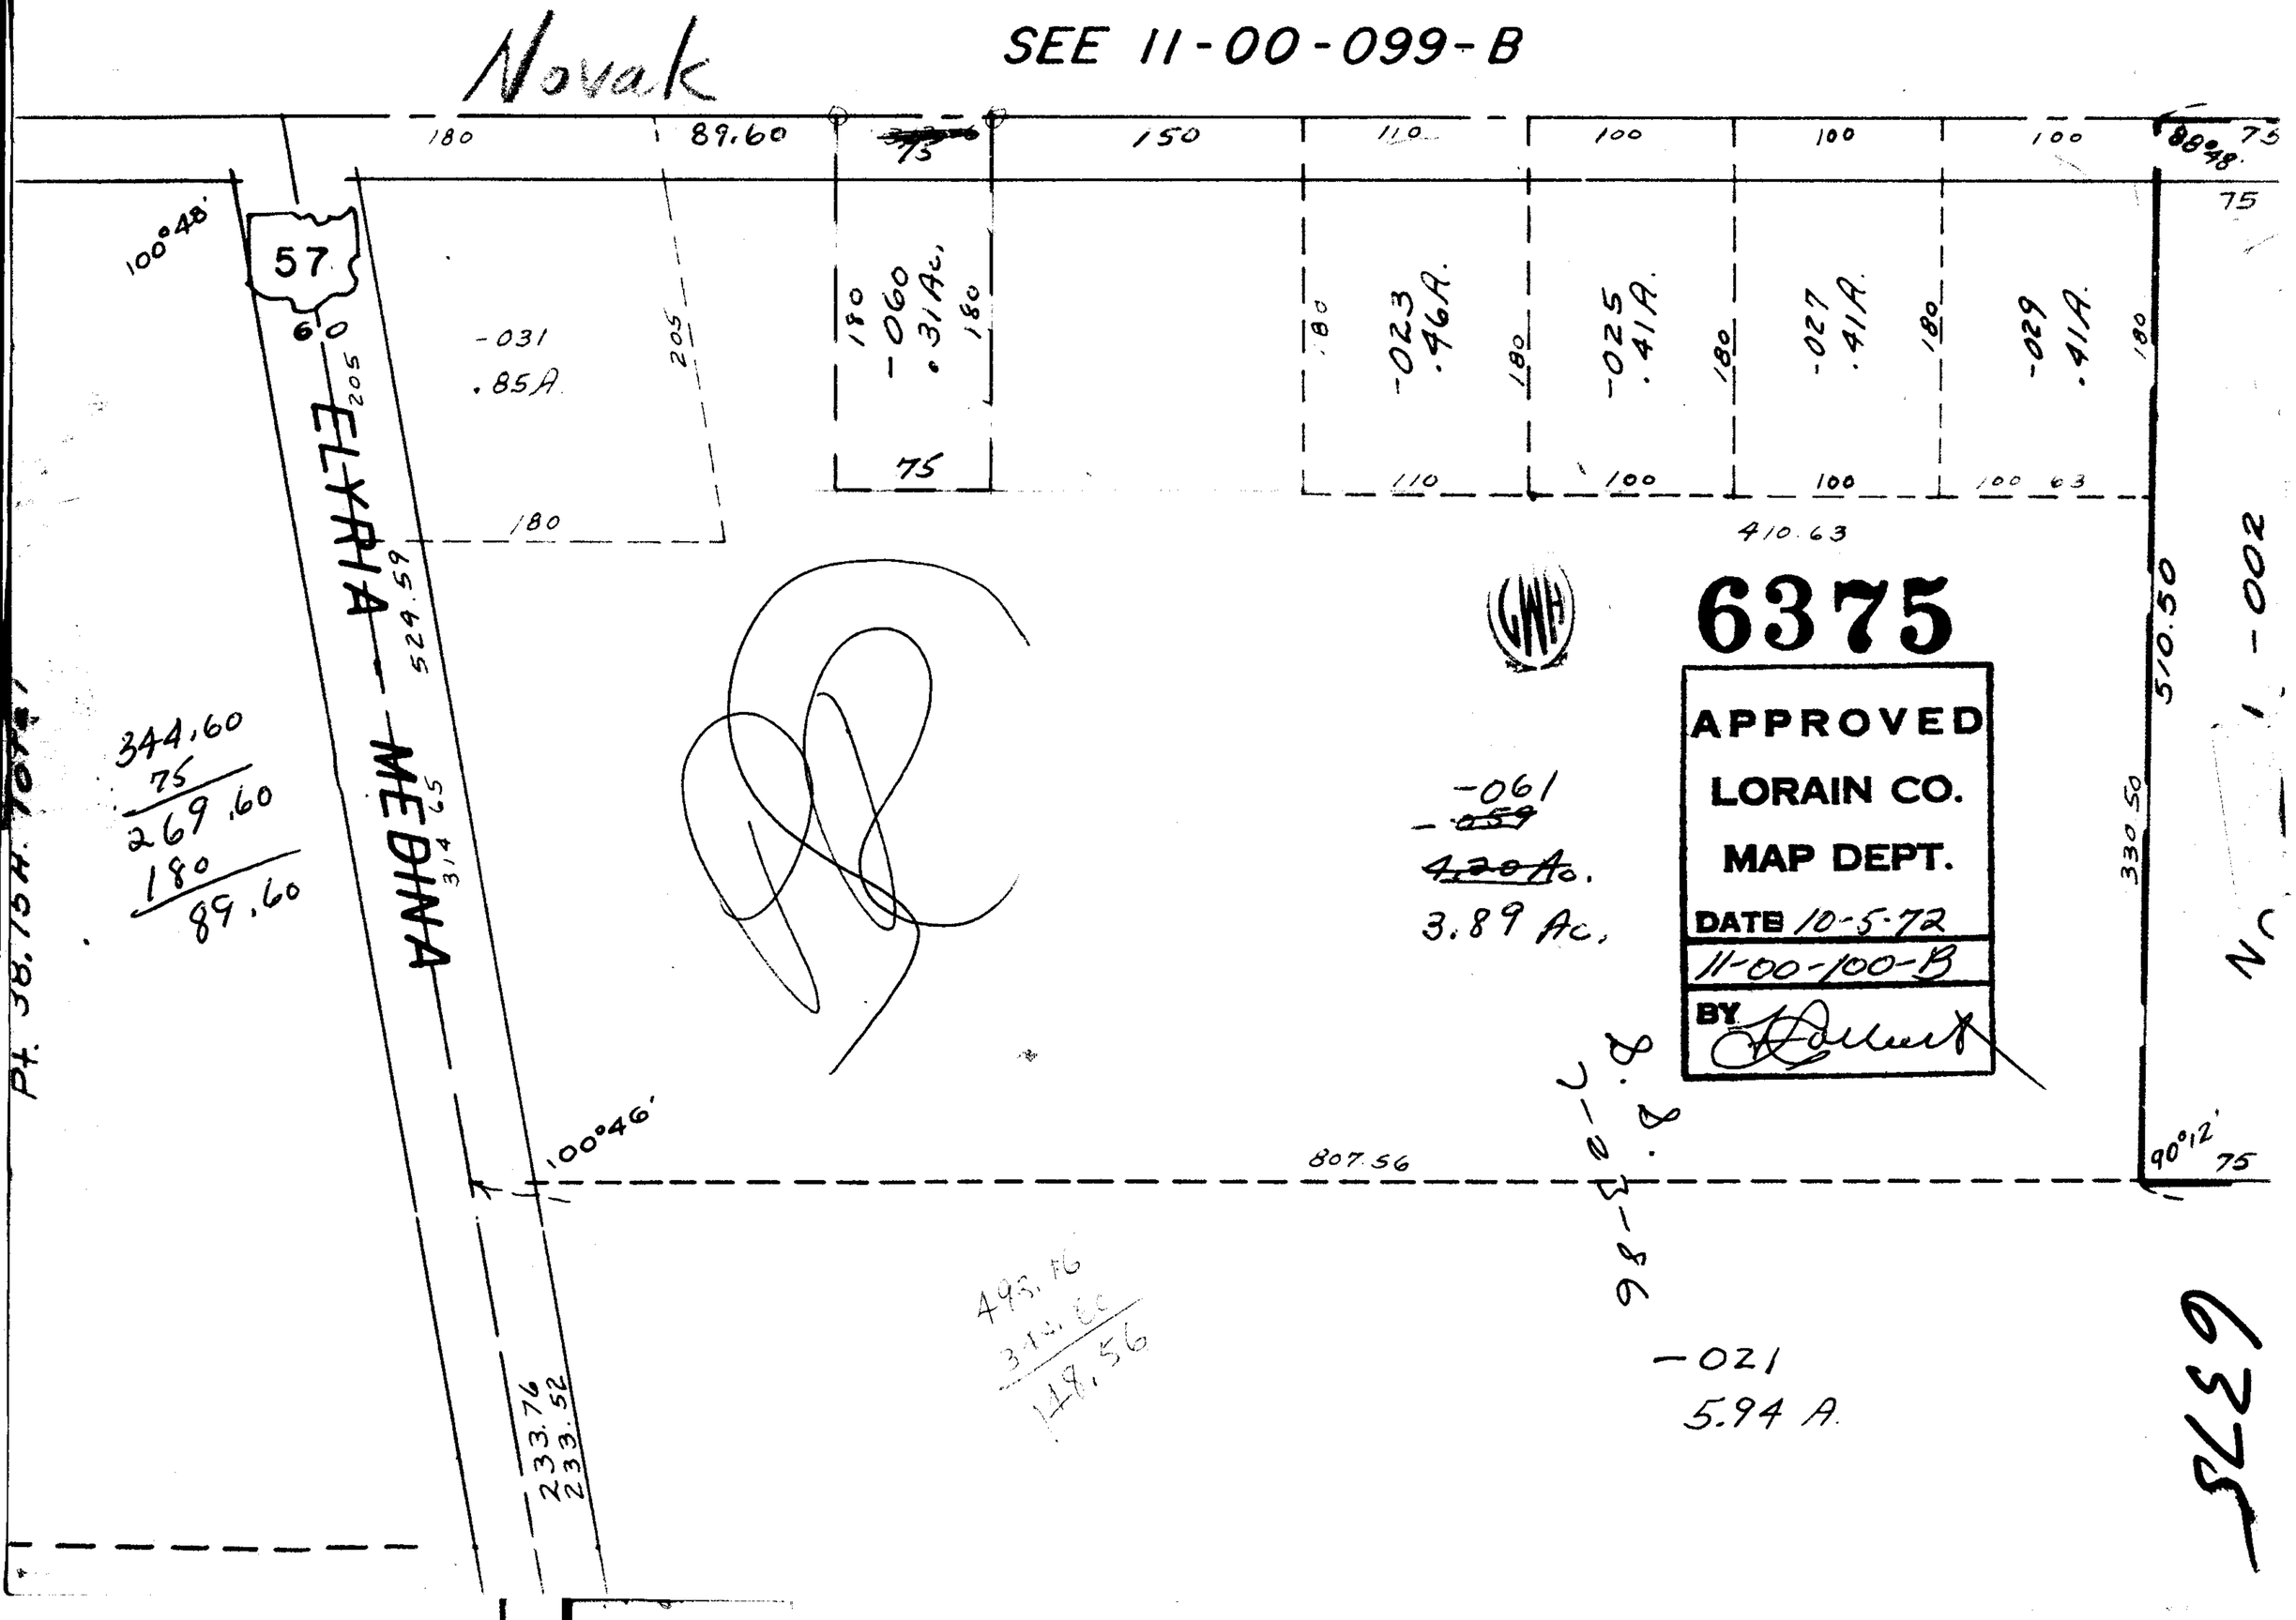
Novak
SEE 11-00-099-B
180
89.60
75
150
110
100
100
100
88°48'
75
100°48'
57
60
ELYRIA
MEDINA
205
-031
.85A
205
180
-060
.31Ac.
180
75
180
-023
.46A.
180
-025
.41A.
180
-027
.41A.
180
-029
.41A.
180
110
100
100
100.63
410.63
529.59
314.65
344.60
75
269.60
180
89.60
Pt. 38.75A.
6375
APPROVED
LORAIN CO.
MAP DEPT.
DATE 10-5-72
11-00-100-B
BY
-061
~~-059~~
~~4.20 Ac.~~
3.89 Ac.
510.50
330.50
-002
100°46'
807.56
90°12'
75
493.76
344.60
148.56
-021
5.94 A.
233.76
233.52
6375