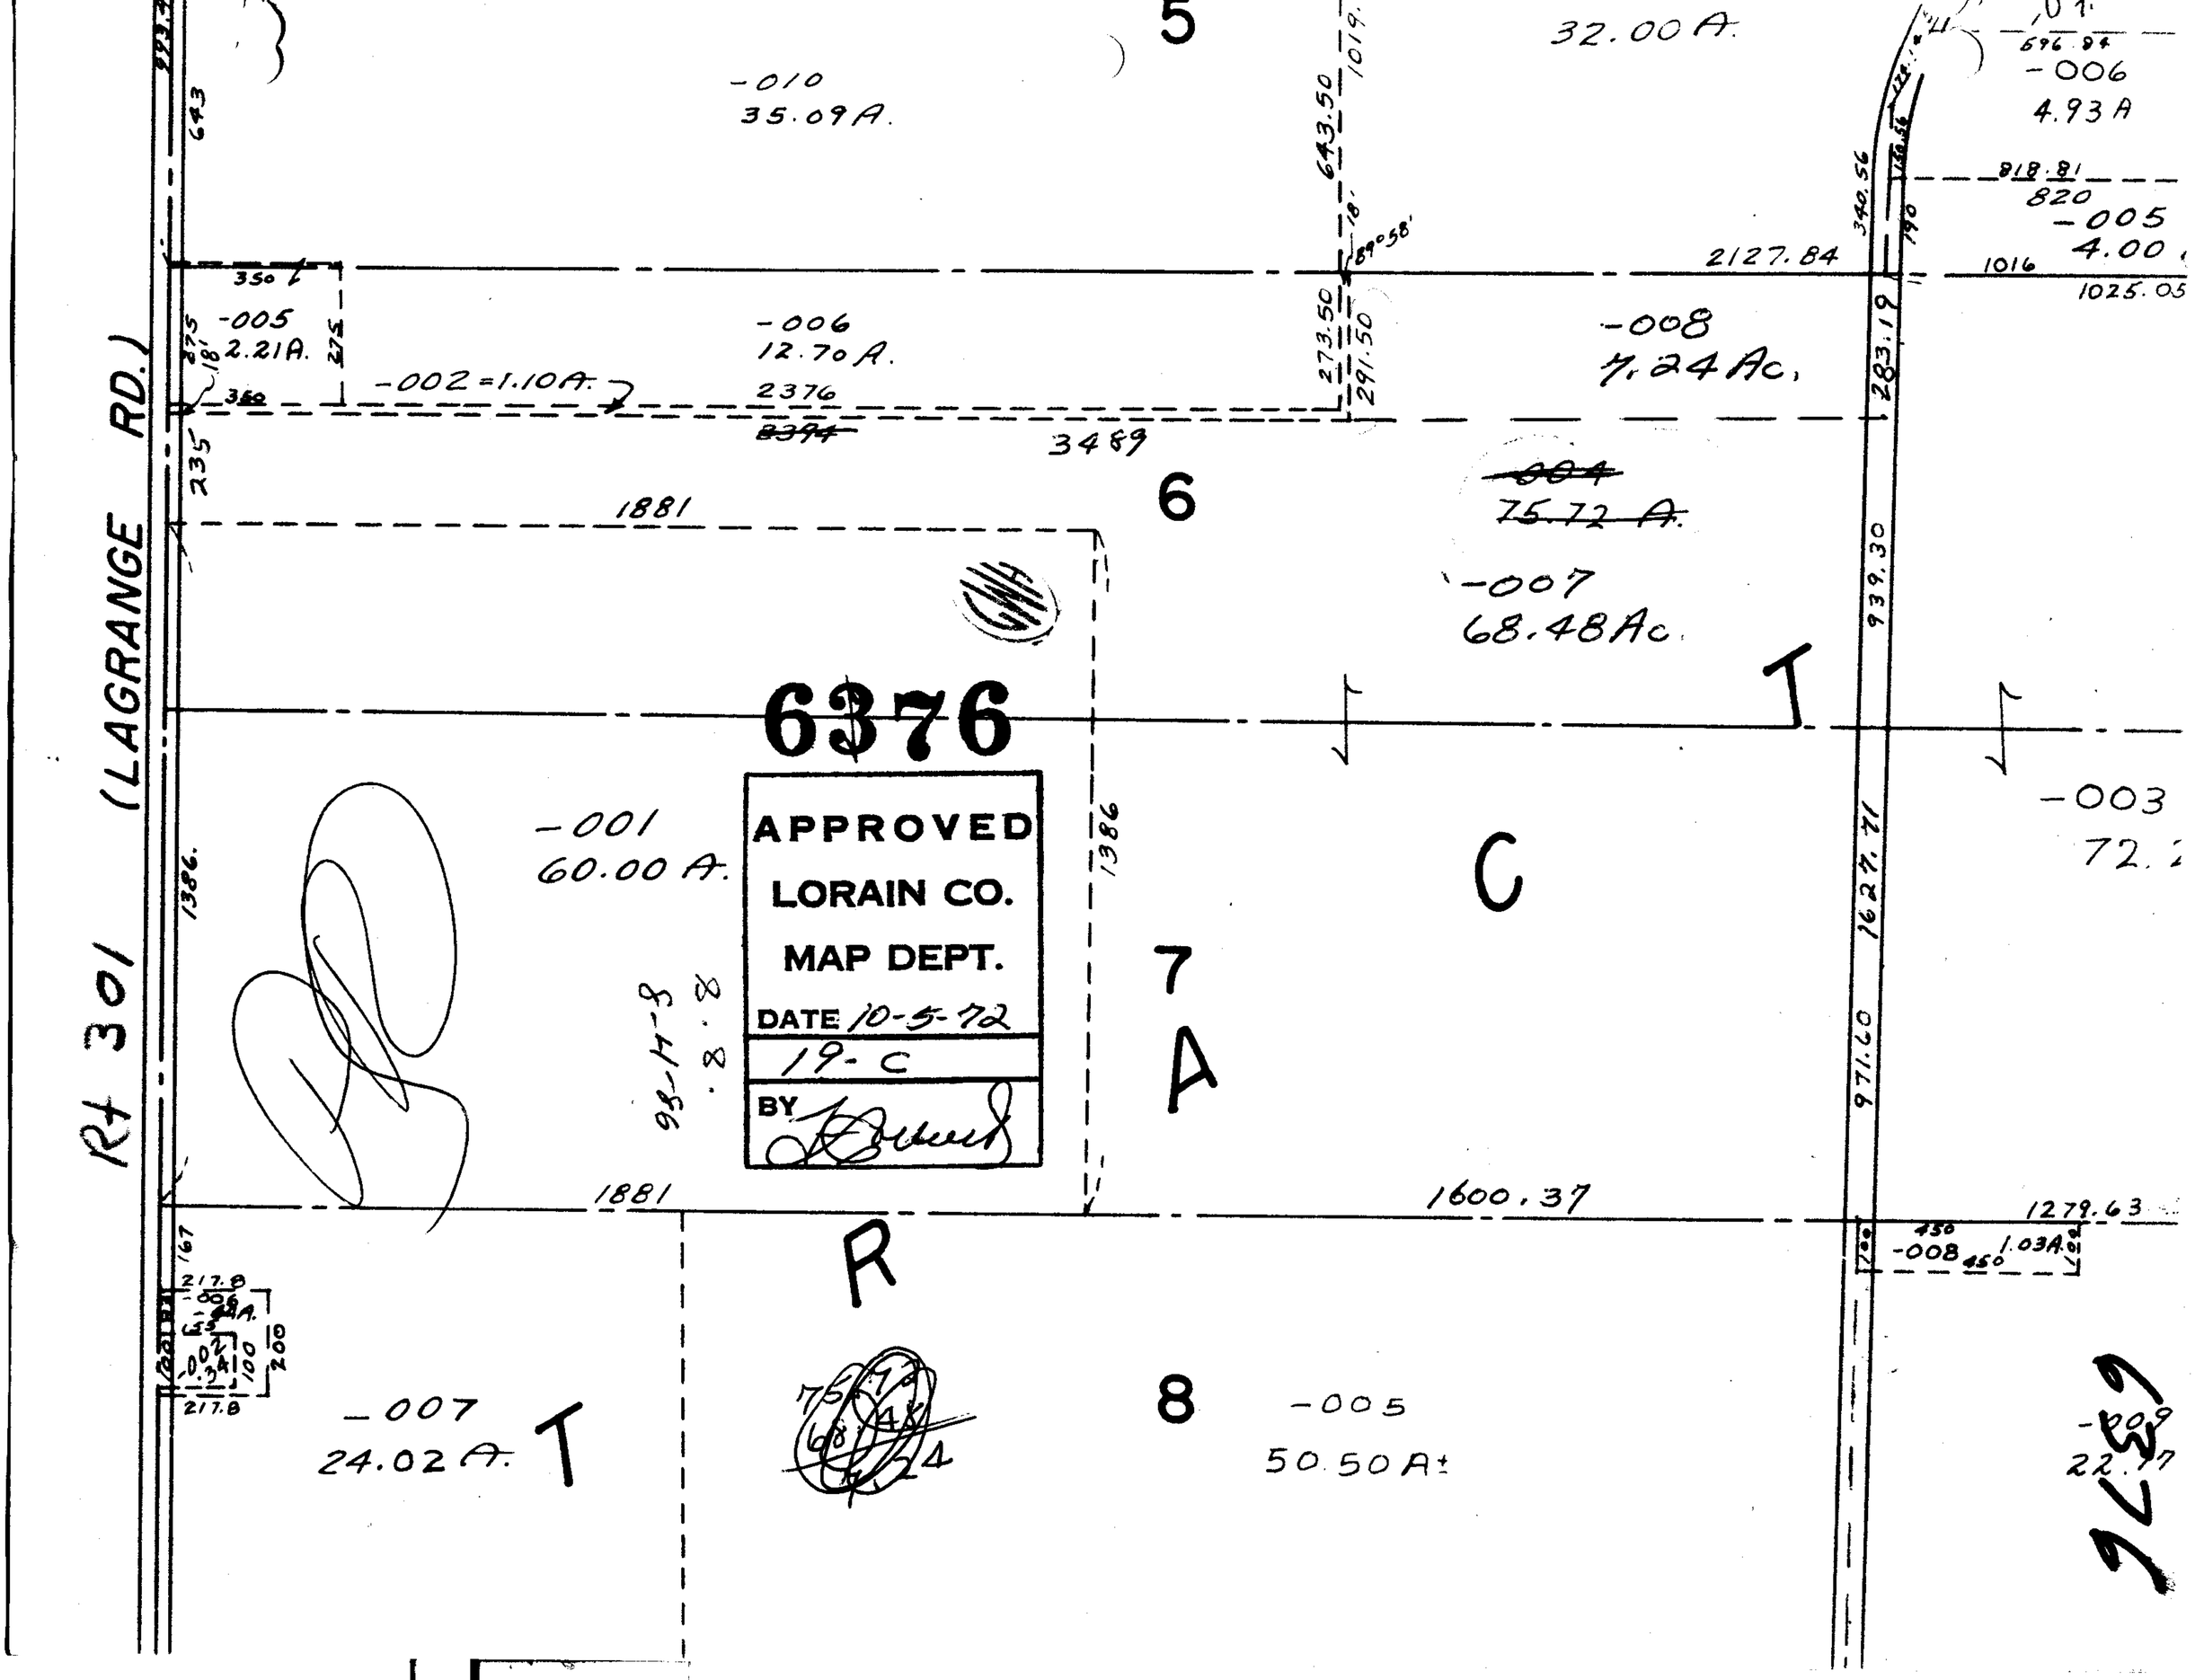

Rt 301 (LAGRANGE RD.)
5
-010
35.09A.
32.00A.
-006
4.93A
-005
4.00
-005
2.21A.
-002=1.10A.
-006
12.70A.
2376
3489
-008
7.24Ac.
2127.84
1016
1025.05
6
1881
-007
68.48Ac.
6376
APPROVED
LORAIN CO.
MAP DEPT.
DATE 10-5-72
19-C
BY
-001
60.00A.
1386
C
7
A
-003
72.2
1627.71
971.60
1881
1600.37
1279.63
R
-008
1.03A.
-007
24.02A.
T
8
-005
50.50A±
6376